


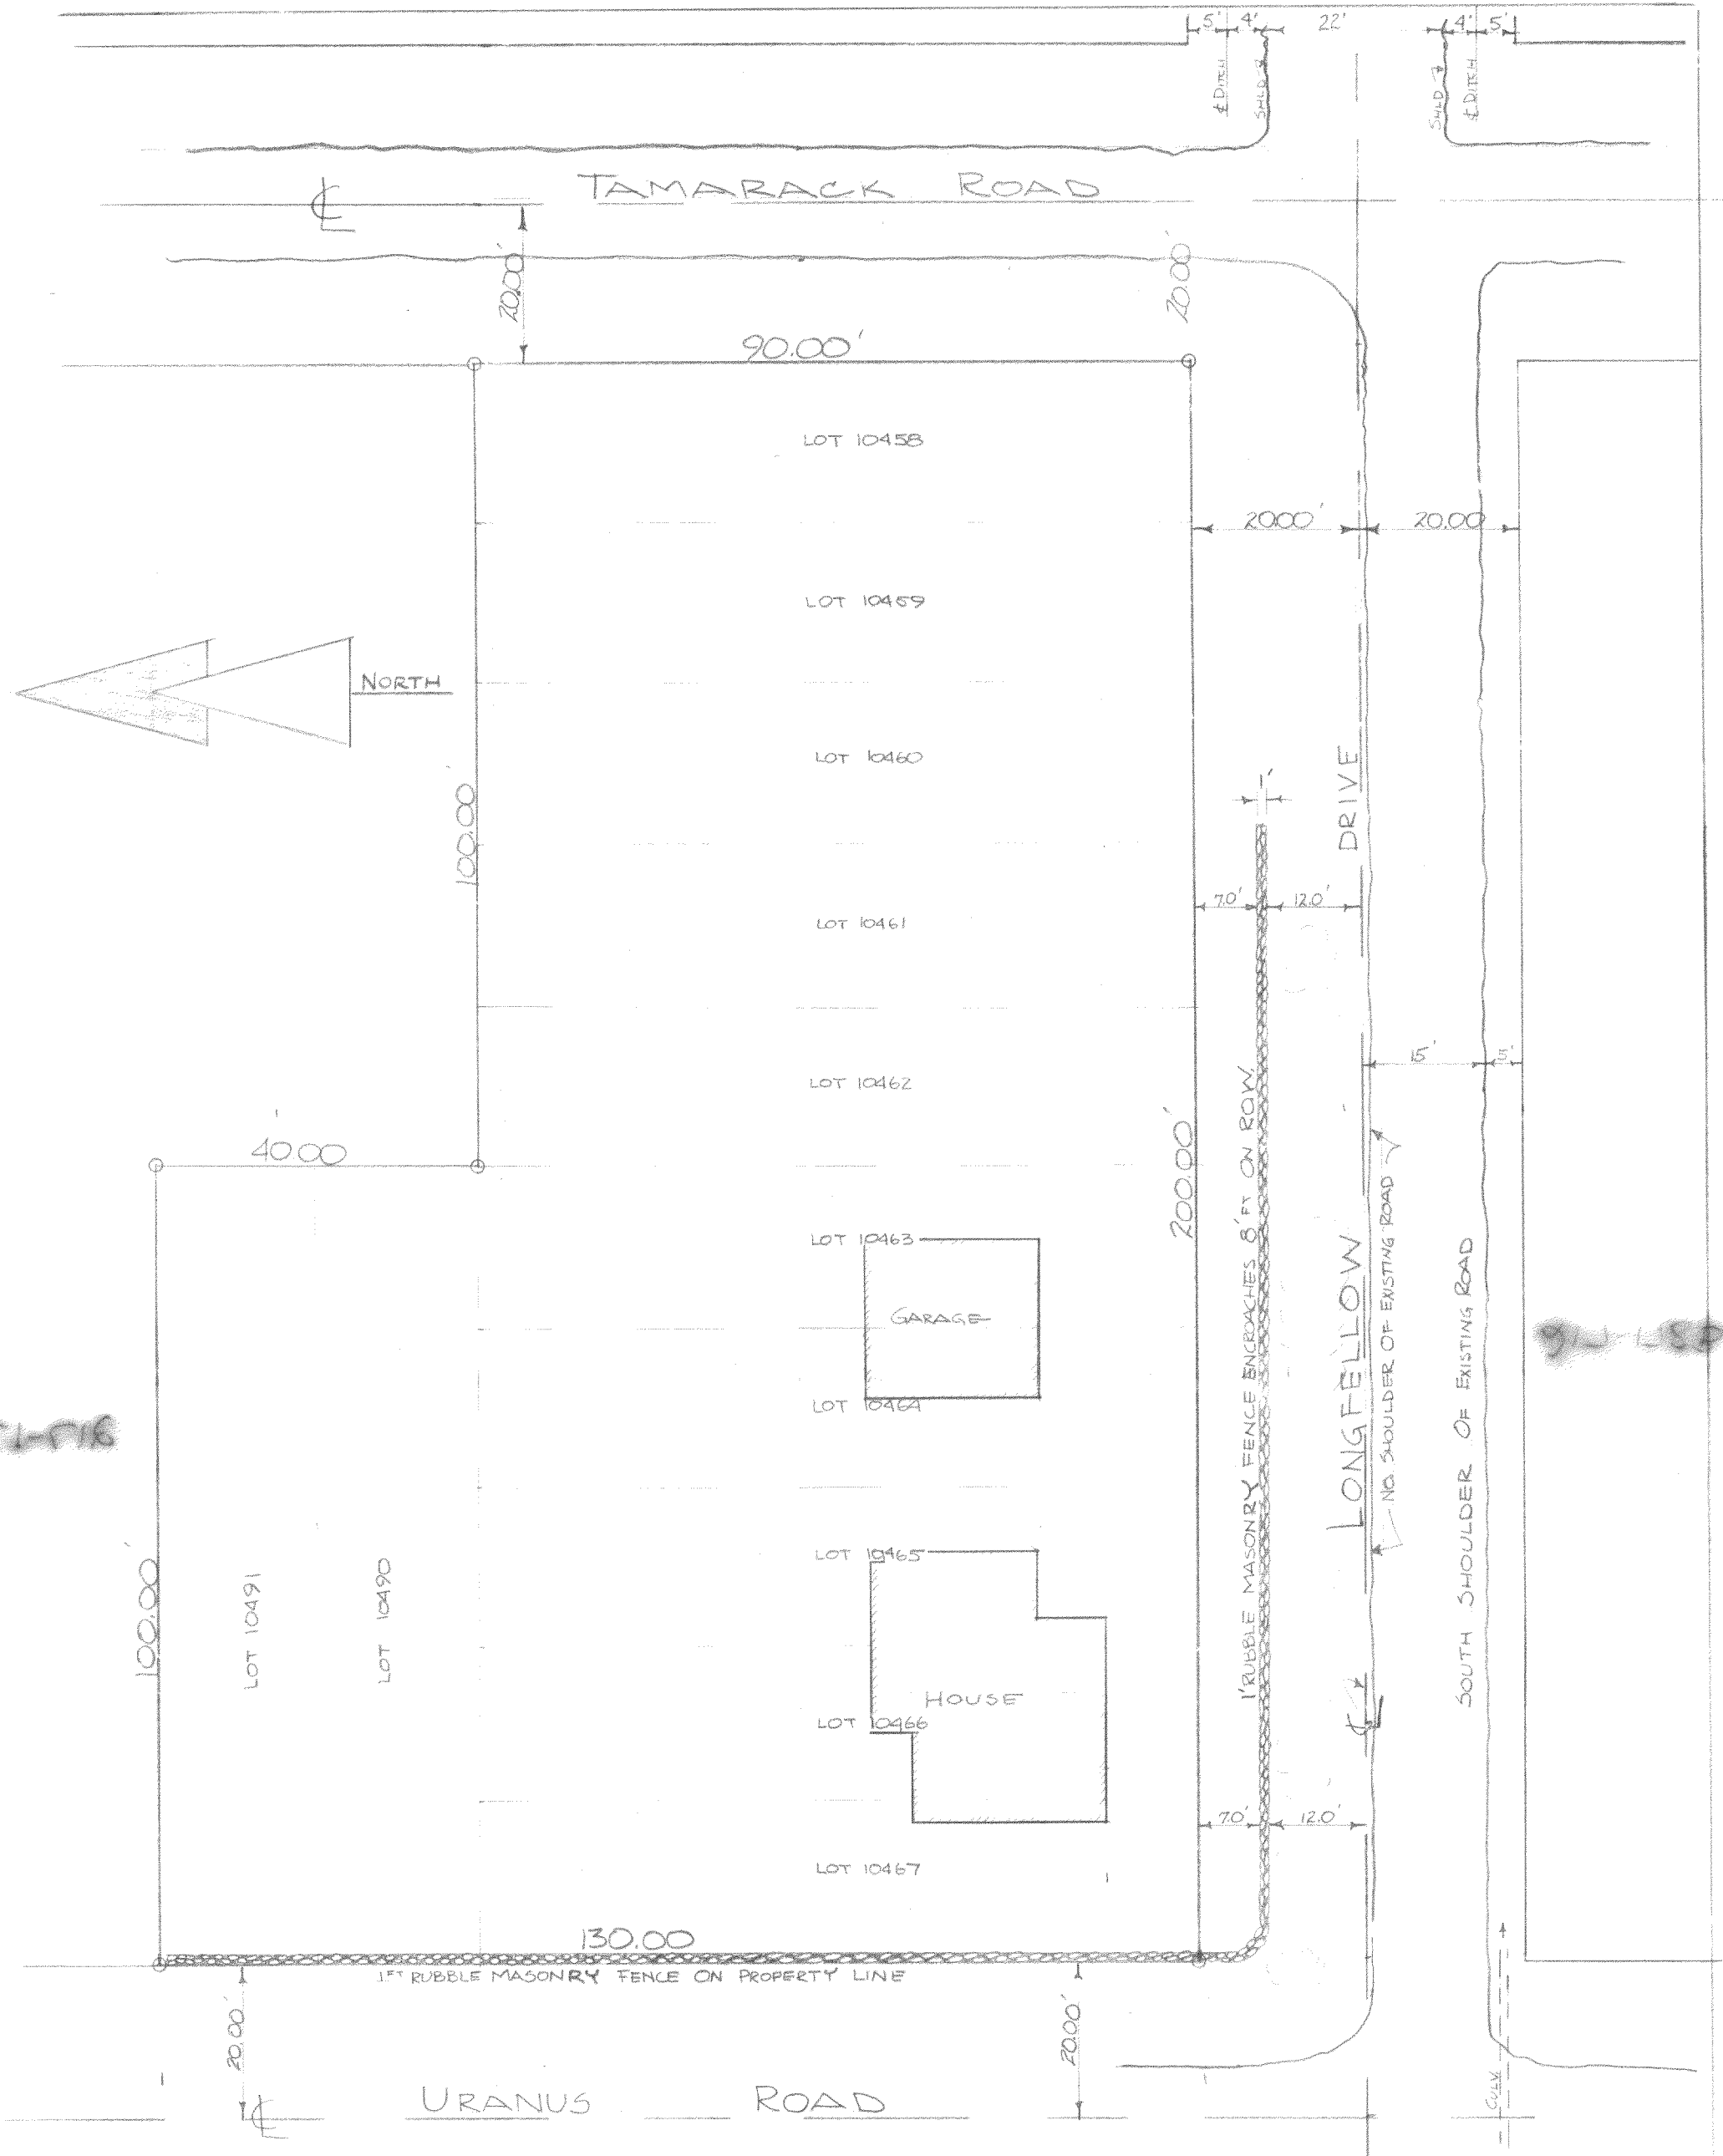

DESCRIPTION: Plot of Survey showing location of rubble masonry wall along the North Side of Longfellow Drive between Uranus and Tamarack Roads in the 5th map of Lake Como Beach Subdivision, Geneva Township, Walworth County, Wisconsin.

CERTIFICATE: I, James F. Biagi, surveyor, do hereby certify that I have surveyed the property lines hereon shown and that the location of the improvements are as shown on the above drawing.

June 15, 1961

SEAL

lots 10455 - 10467 incl
and lots 10490
10491

UTIL. POLE 2.5' NO.
OF 2.5' EAST OF PL.

217-178 B