

PLAT OF SURVEY

PATHFINDER SURVEYING
FORMERLY KOLB LAND CONSULTING
929 WILLIAMS STREET LAKE GENEVA, WI. 53147
(414) 248-3697


ORDERED BY: BASSO BUILDERS
405 SKYLINE DRIVE
LAKE GENEVA WI. 53147

DATE: 7-13-1999


DESCRIPTION:

PARCEL A LOTS 2190 THRU 2195, BLOCK 36 OF LAKE COMO BEACH SUBDIVISION, LOCATED IN SECTION 22, T2N, R17E, WALWORTH COUNTY, WISCONSIN.

PARCEL B LOTS 2196 THRU 2202, BLOCK 36 OF LAKE COMO BEACH SUBDIVISION, LOCATED IN SECTION 22, T2N, R17E, WALWORTH COUNTY, WISCONSIN.

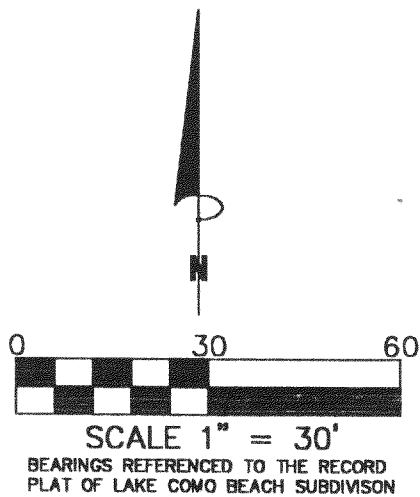



- LEGEND
- FOUND IRON PIPE
 - SET IRON PIPE
 - FOUND IRON PIN
 - (XXXX) RECORDED AS

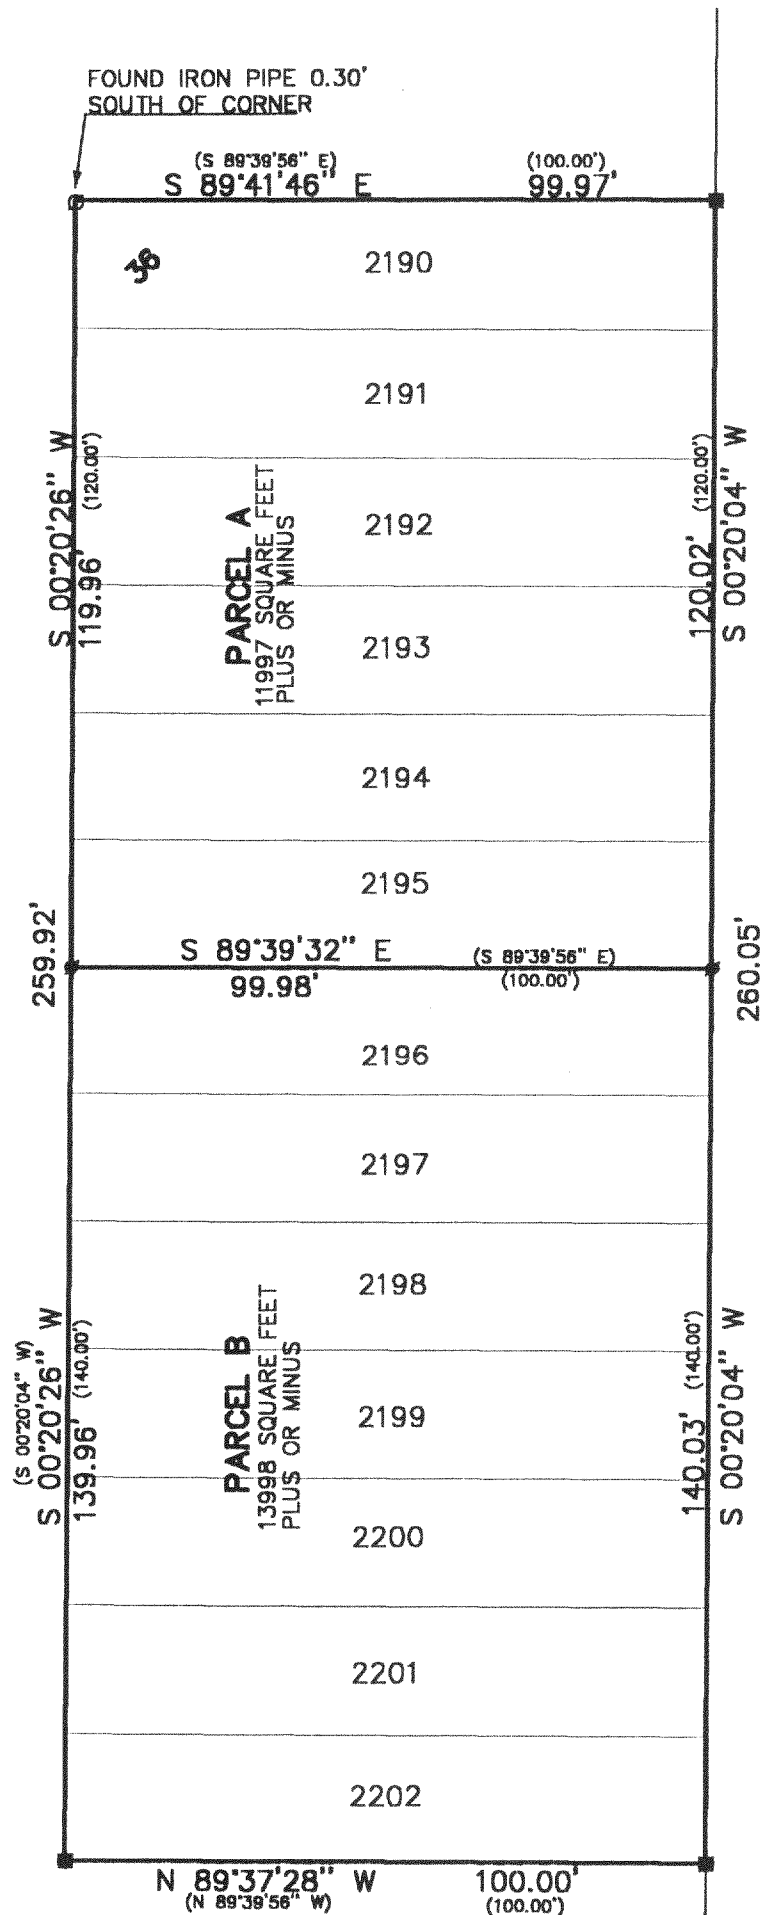

THE ABOVE MAP IS A TRUE REPRESENTATION THEREOF AND SHOWS THE SIZE AND LOCATION OF ALL THE PROPERTY, EXTERIOR BOUNDARIES, THE LOCATION OF ALL VISIBLE BOUNDARY FENCES, APPARENT EASEMENTS, ROADWAYS AND VISIBLE ENCROACHMENTS, IF ANY

THIS SURVEY IS MADE FOR THE USE OF THE PRESENT OWNERS OF THE PROPERTY, AND ALSO THOSE WHO PURCHASE, MORTGAGE OR GUARANTEE TITLE THERETO WITHIN ONE (1) YEAR FROM DATE HERETO.

John P. Krott
JOHN P. KROTT, R.L.S. 2258

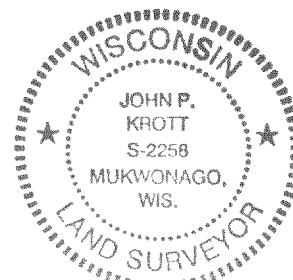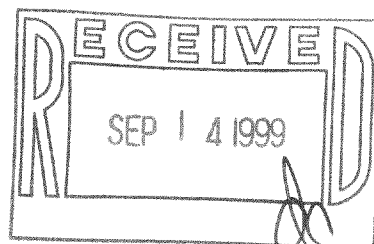

NOTE: THIS IS NOT A CERTIFIED COPY UNLESS SEAL IS IN RED.

JOB NUMBER #99148 2-17-JLCB-00374

JLCB-374

217-1800