



PLAT OF SURVEY

PATHFINDER SURVEYING
FORMERLY KOLB LAND CONSULTING
929 WILLIAMS STREET LAKE GENEVA, WI. 53147
(414) 248-3697

ORDERED BY: ADT INC.
P.O. BOX 386
WHITEWATER, WI
53190

DATE: 7-27-1999

DESCRIPTION: LOTS 2753 THRU 2759 BLOCK 48 OF LAKE COMO BEACH
SUBDIVISON, LOCATED IN T2N, R17E, WALWORTH COUNTY
WISCONSIN.

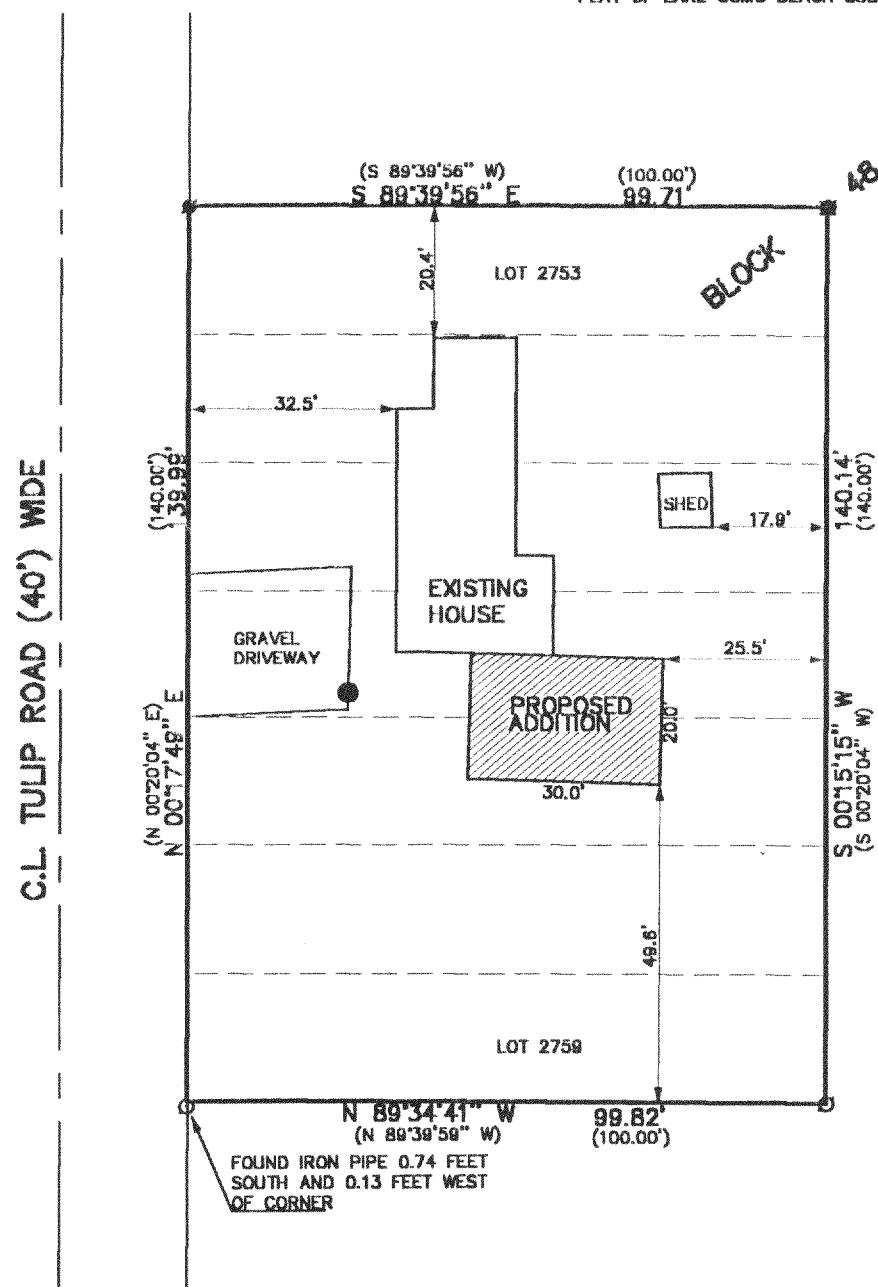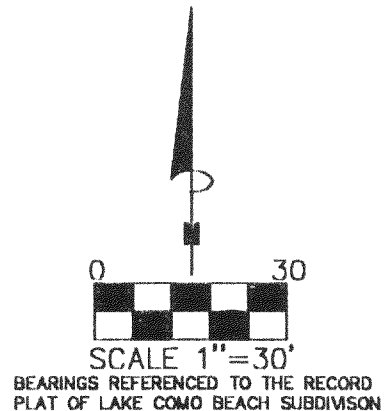



LEGEND

- FOUND IRON PIPE
- SET IRON PIPE
- FOUND IRON PIN
- (XXXX) RECORDED AS
- WELL

THE ABOVE MAP IS A TRUE REPRESENTATION THEREOF AND SHOWS THE SIZE AND LOCATION OF ALL THE PROPERTY, EXTERIOR BOUNDARIES, THE LOCATION OF ALL VISIBLE BOUNDARY FENCES, APPARENT EASEMENTS, ROADWAYS AND VISIBLE ENCROACHMENTS, IF ANY

THIS SURVEY IS MADE FOR THE USE OF THE PRESENT OWNERS OF THE PROPERTY, AND ALSO THOSE WHO PURCHASE, MORTGAGE OR GUARANTEE TITLE THERETO WITHIN ONE (1) YEAR FROM DATE HERETO.

John P. Krott
JOHN P. KROTT, R.L.S. 2258

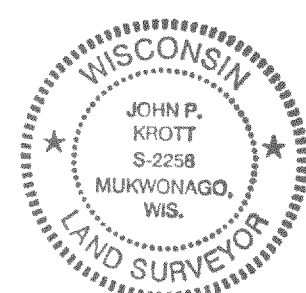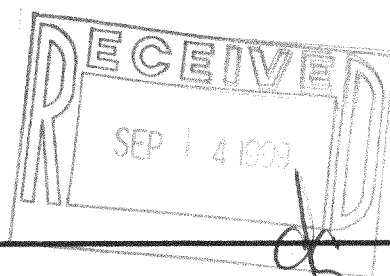

NOTE: THIS IS NOT A CERTIFIED COPY
UNLESS SEAL IS IN RED.
JOB NUMBER #99158 2-17-JLCB 000480

JLCB-480
217-1804