

PLAT OF SURVEY
LOT 5
LAKE FOREST ESTATES


A SUBDIVISION LOCATED IN THE NW, SW, AND SE 1/4'S
OF THE SW 1/4 OF SECTION 26,
THE SE & NE 1/4'S OF SECTION 27
AND THE NE 1/4 OF THE NW 1/4 OF SECTION 35
ALL IN TOWN 2 NORTH, RANGE 17 EAST
WALWORTH COUNTY, WISCONSIN

WORK ORDERED FOR: FJEFF GIOVINETTI
BY: PAT MOORE
MIDWEST CONSTRUCTION
PO BOX 487
WILLIAMS BAY, WISCONSIN 53191

FARRIS, HANSEN & ASSOCIATES, INC.
Engineering, Architecture, Surveying
7 Ridgway Court P.O. Box 437
ELKHORN, WISCONSIN 53121
Office: (414) 723-2098
Fax: (414) 723-5886

REVISIONS

PROJECT NO.
5226
DATE
02-22-99
SHEET NO.
1 OF 1

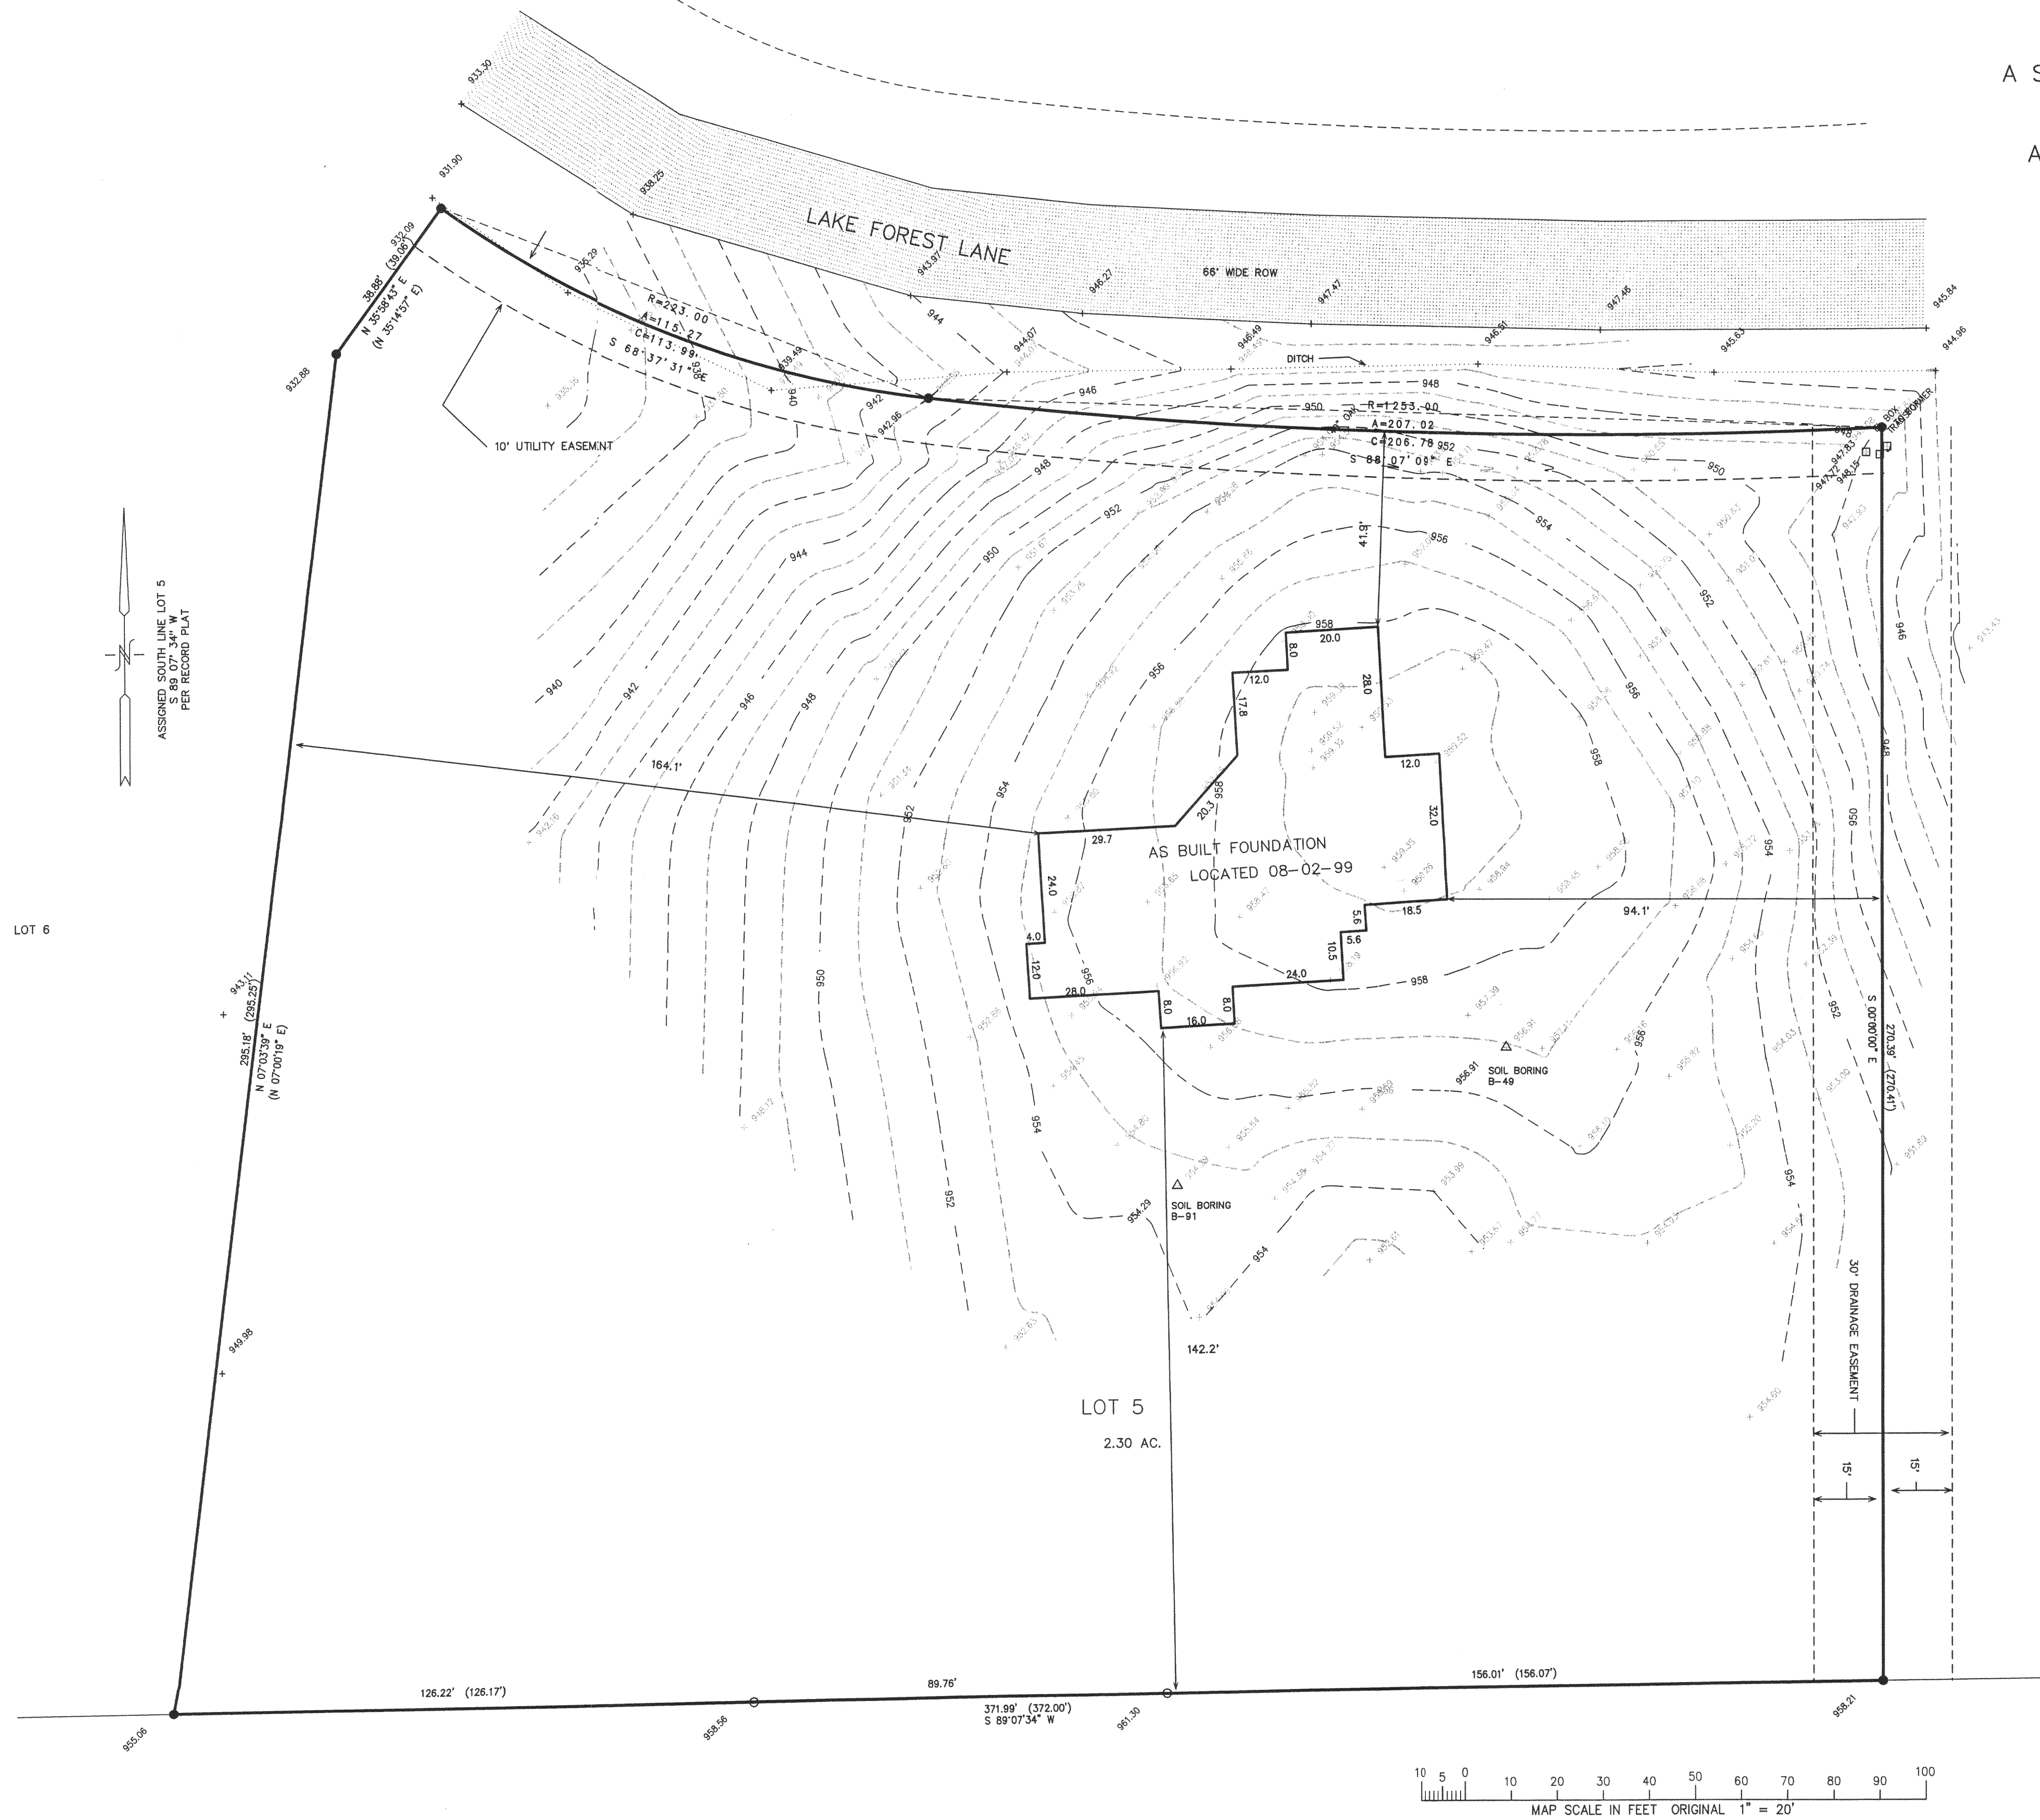


LEGEND
● = FOUND IRON REBAR STAKE
○ = FOUND IRON PIPE STAKE
△ = FOUND LATH
■ = SET IRON REBAR STAKE
(xxx) = RECORDED AS

NOTE: COPIES OF THIS MAP TO WHICH THE FOLLOWING CERTIFICATE WILL APPLY SHOW SURVEYOR'S ORIGINAL SEAL AND SIGNATURE IN RED INK. COPIES BY ANY OTHER MEANS MAY HAVE ALTERATIONS WHICH DO NOT REPRESENT THE SURVEYOR'S WORK PRODUCT.

I HEREBY CERTIFY THAT THE ABOVE DESCRIBED PROPERTY HAS BEEN SURVEYED UNDER MY DIRECTION AND THAT THE ABOVE MAP IS A TRUE REPRESENTATION THEREOF AND SHOWS THE SIZE AND LOCATION OF THE PROPERTY AND ITS EXTERIOR BOUNDARIES. THIS SURVEY IS MADE FOR THE USE OF THE PRESENT OWNERS OF THE PROPERTY, AND ALSO THOSE WHO PURCHASE, MORTGAGE, OR GUARANTEE THE TITLE THERETO WITHIN ONE YEAR FROM THE DATE HEREOF.

DATED: 02-22-1999
PETER S. GORDON R.L.S. 2101

REVISED 08-04-99
TO SHOW SIZE & LOCATION OF
FOUNDATION AS BUILT

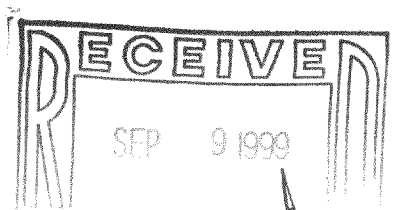

217-1810 JUE-5