


ABELL SURVEYING & MAPPING

1140 SEQUOIA STREET • DELAVAN, WISCONSIN 53115
414-728-6737

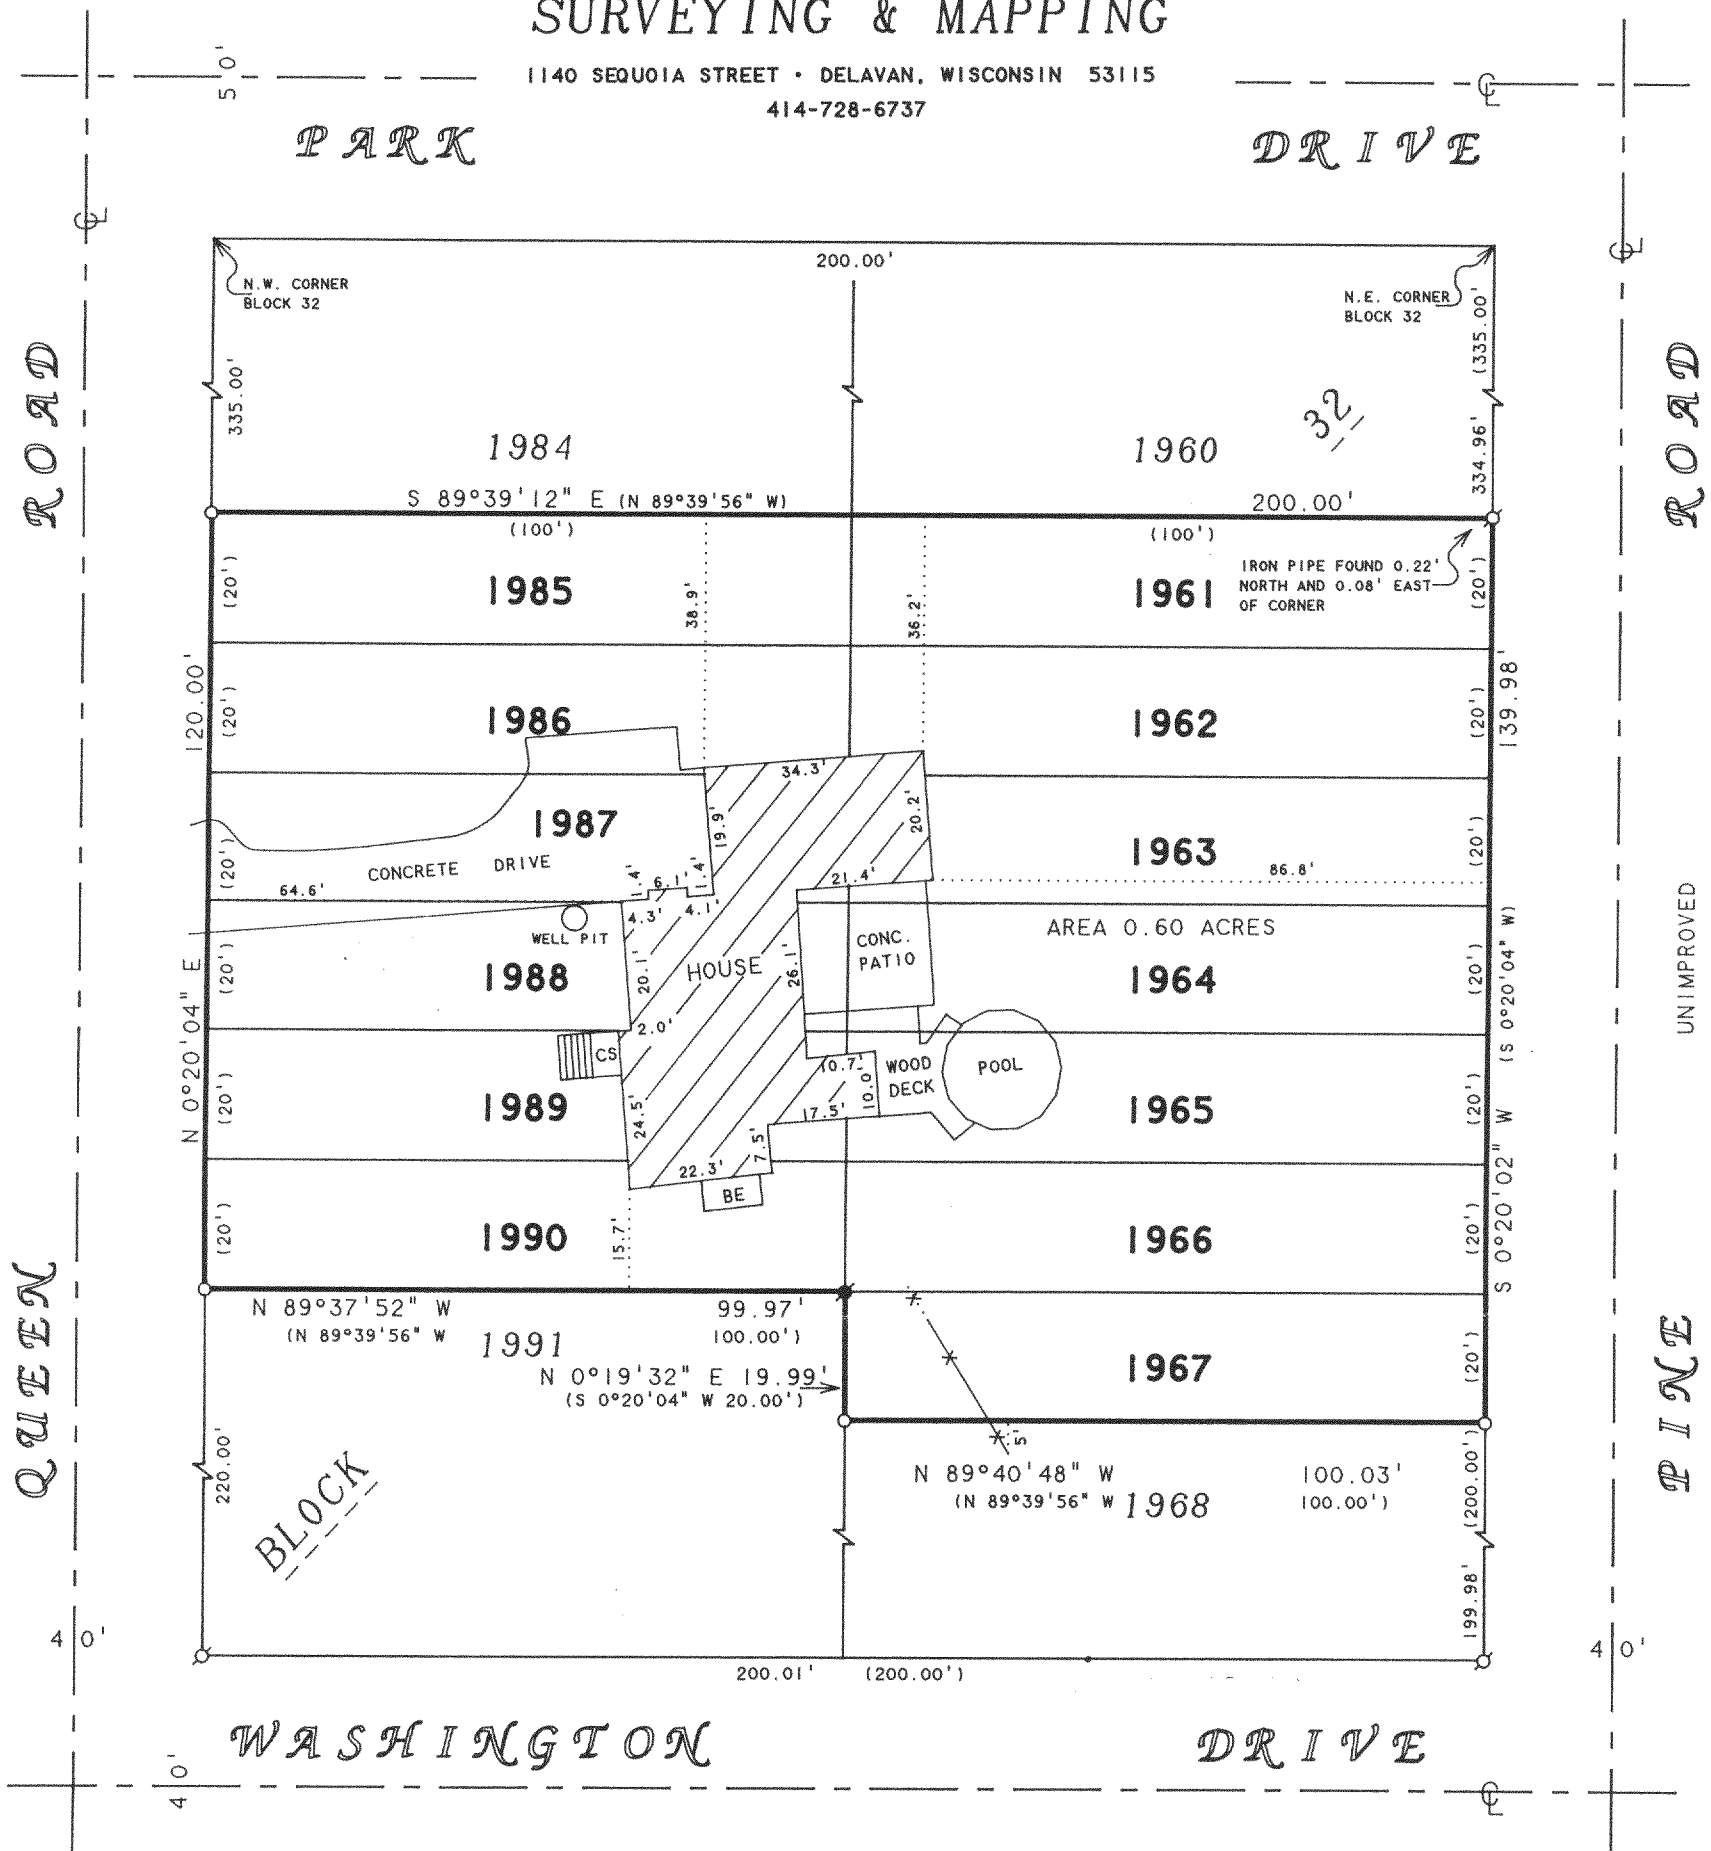

NOTE: BEARINGS ARE REFERENCED TO THE
RECORDED SUBDIVISION PLAT.

PLAT OF SURVEY OF

ORDERED BY: JOHN D. BAERE
N3342 QUEEN ROAD
LAKE GENEVA, WI 53147

LOTS 1961-1967 AND 1985-1990, BLOCK 32,
LAKE COMO BEACH SUBDIVISION, LOCATED IN
T2N, R17E, WALWORTH COUNTY, WISCONSIN.


N



SCALE 1"=30'

LEGEND

- - IRON PIPE FOUND
- - IRON ROD FOUND
- - 1" DIA. IRON PIPE SET
- BE - BASEMENT ENTRY
- CS - CONCRETE STOOP
- * - WOOD FENCE
- () - RECORDED AS

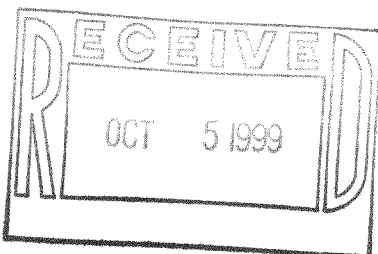

I, DAVID F. ABELL, DO HEREBY CERTIFY THAT I HAVE SURVEYED THE PROPERTY HEREON
DESCRIBED ACCORDING TO THE OFFICIAL RECORDS AND THAT THE PLAT HEREON IS A
CORRECT REPRESENTATION OF THE PROPERTY LINES TO THE BEST OF MY KNOWLEDGE AND
BELIEF.

David F. Abell

DAVID F. ABELL
WISCONSIN REGISTERED LAND SURVEYOR, S-1596

August 20, 1999

DATE JOB NUMBER - 99105
NOTE: THIS IS NOT A CERTIFIED COPY UNLESS SEALED.

217-1813*
JLCB-326