
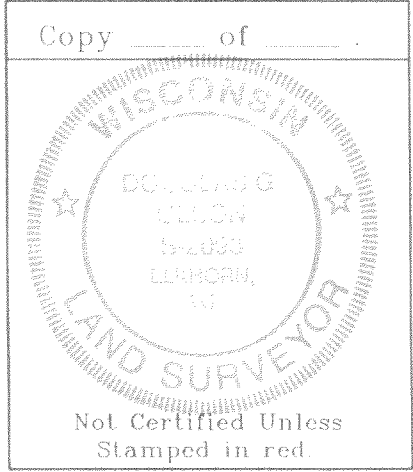
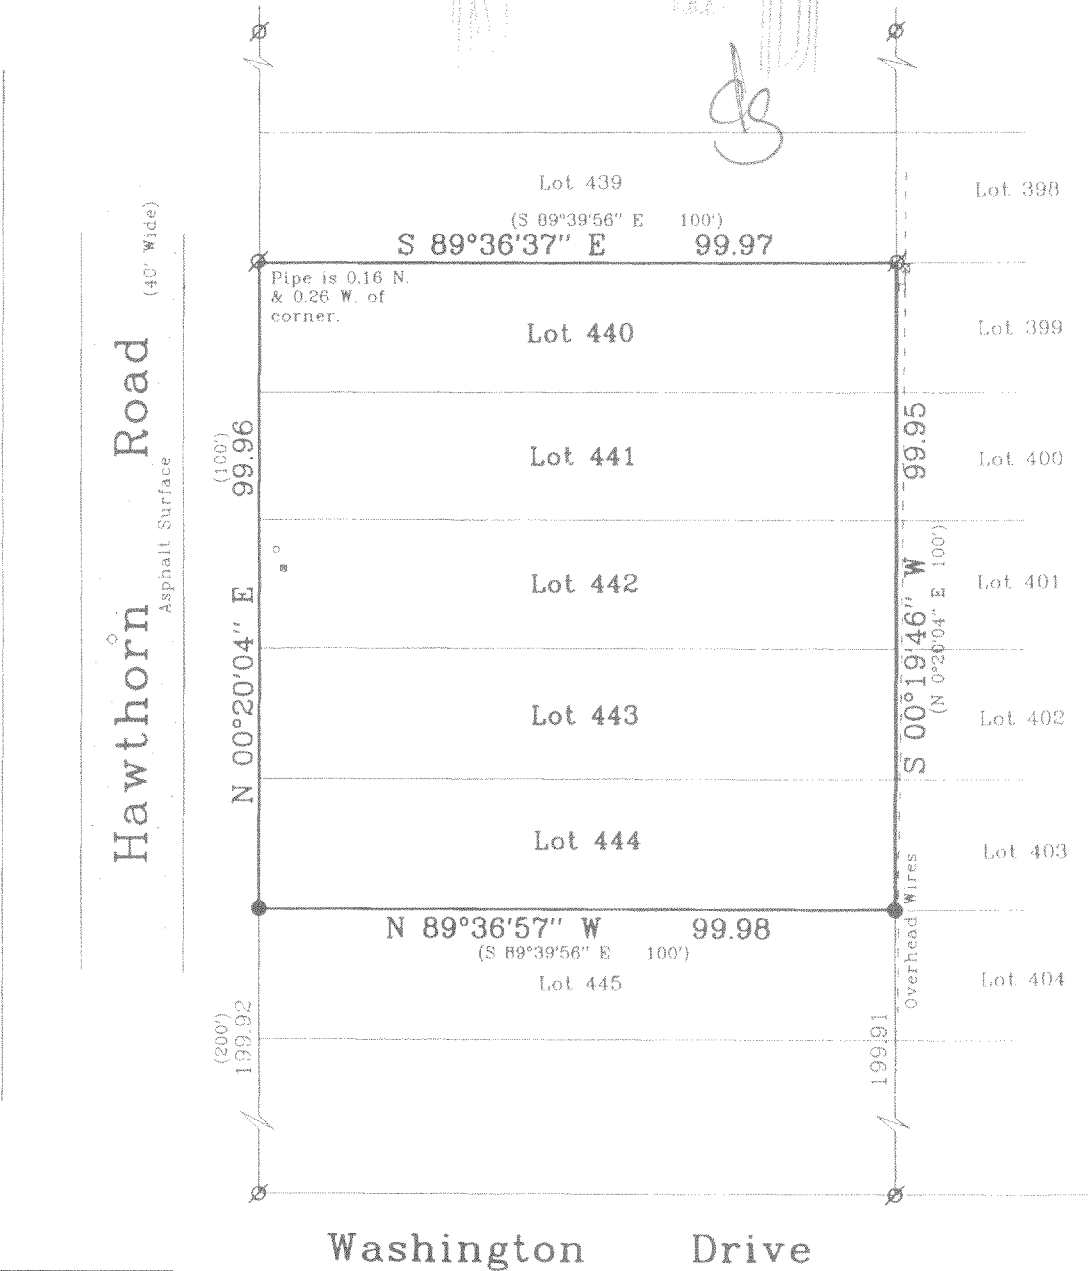


Plat of Survey

of
Lots 440 through 444 of Block 8 of the
Third Map of Lake Como Beach,
a subdivision located in the Southeast 1/4 of Section 22, Town 2
North, Range 17 East, Town of Geneva, Walworth County, Wisconsin.

Surveyed for: **Olm & Associates**
162 West Main Street
P.O. Box 37
Whitewater, Wisconsin, 53190

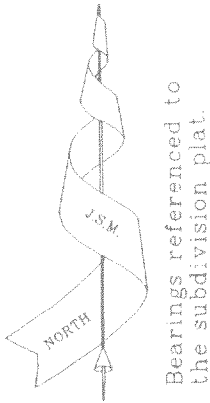

Note: This survey is subject to Wisconsin lien laws. This Plat of Survey is the notice of intent to file lien. Lien waiver required.

Note: This survey plat is not certified unless signed and sealed in red ink.

Copyright © 1999 by Jensen & Olson Land Surveying, LLC

All rights reserved. No part of this survey plat may be reproduced or transmitted in any form by any means - graphic, electronic, or mechanical, including photocopying, tracing, or information storage and retrieval systems - without permission in writing from Douglas G. Olson, Jensen & Olson Land Surveying, LLC.

I, Douglas G. Olson, Wisconsin Registered Land Surveyor, do hereby certify that this survey was performed by me, or under my direction in full compliance with the owner's / agent's instructions and Chapter A-E 7 of the Wisconsin Administrative Code "Minimum Standards for Property Surveys"; and that this map is as accurate representation thereof to the best of my knowledge and belief

Date: 10-7-99

Douglas G. Olson R.L.S. 2093

Legend

- Found Iron Pipe
- Set Iron Rod, 3/4" dia
- Recorded Information
- Utility Pole
- Utility Pedestal
- Manhole
- Water Valve
- Wood Post (Possible location of sewer lateral)

Jensen & Olson Land Surveying, LLC
45 South Wisconsin Street P.O. Box 322
Elkhorn, Wisconsin, 53121
Telephone: (262) 723-3434
Facsimile: (262) 723-8044

Mapping Date: Oct. 7, 1999.
Revisions:
Sheet 1 of 1 Sheets
Job Reference No.
1999.110



JLCB-60 217-1822