

FARRIS, HANSEN, & ASSOCIATES, INC.

ENGINEERING, ARCHITECTURE, SURVEYING

7 RIDGWAY COURT - P.O. BOX 437, ELKHORN, WISCONSIN, 53121

PHONE: (414) 723-2098 FAX: (414) 723-5886

PLAT OF SURVEY

THE NORTH 1/2 OF LOT 10143 & LOTS 10144 THRU 10148 OF BLOCK 185


LAKE COMO BEACH SUBDIVISION

LOCATED IN THE TOWN OF GENEVA

WALWORTH COUNTY, WISCONSIN

— WORK ORDERED BY —
JOE KOMPARE
8601 WAUKEGAN ROAD
MORTON GROVE, IL. 60053-2295

SURVEYED AREA = 7000 S.F.
TAX PARCELS
JLCB-2191
JLCB-2192

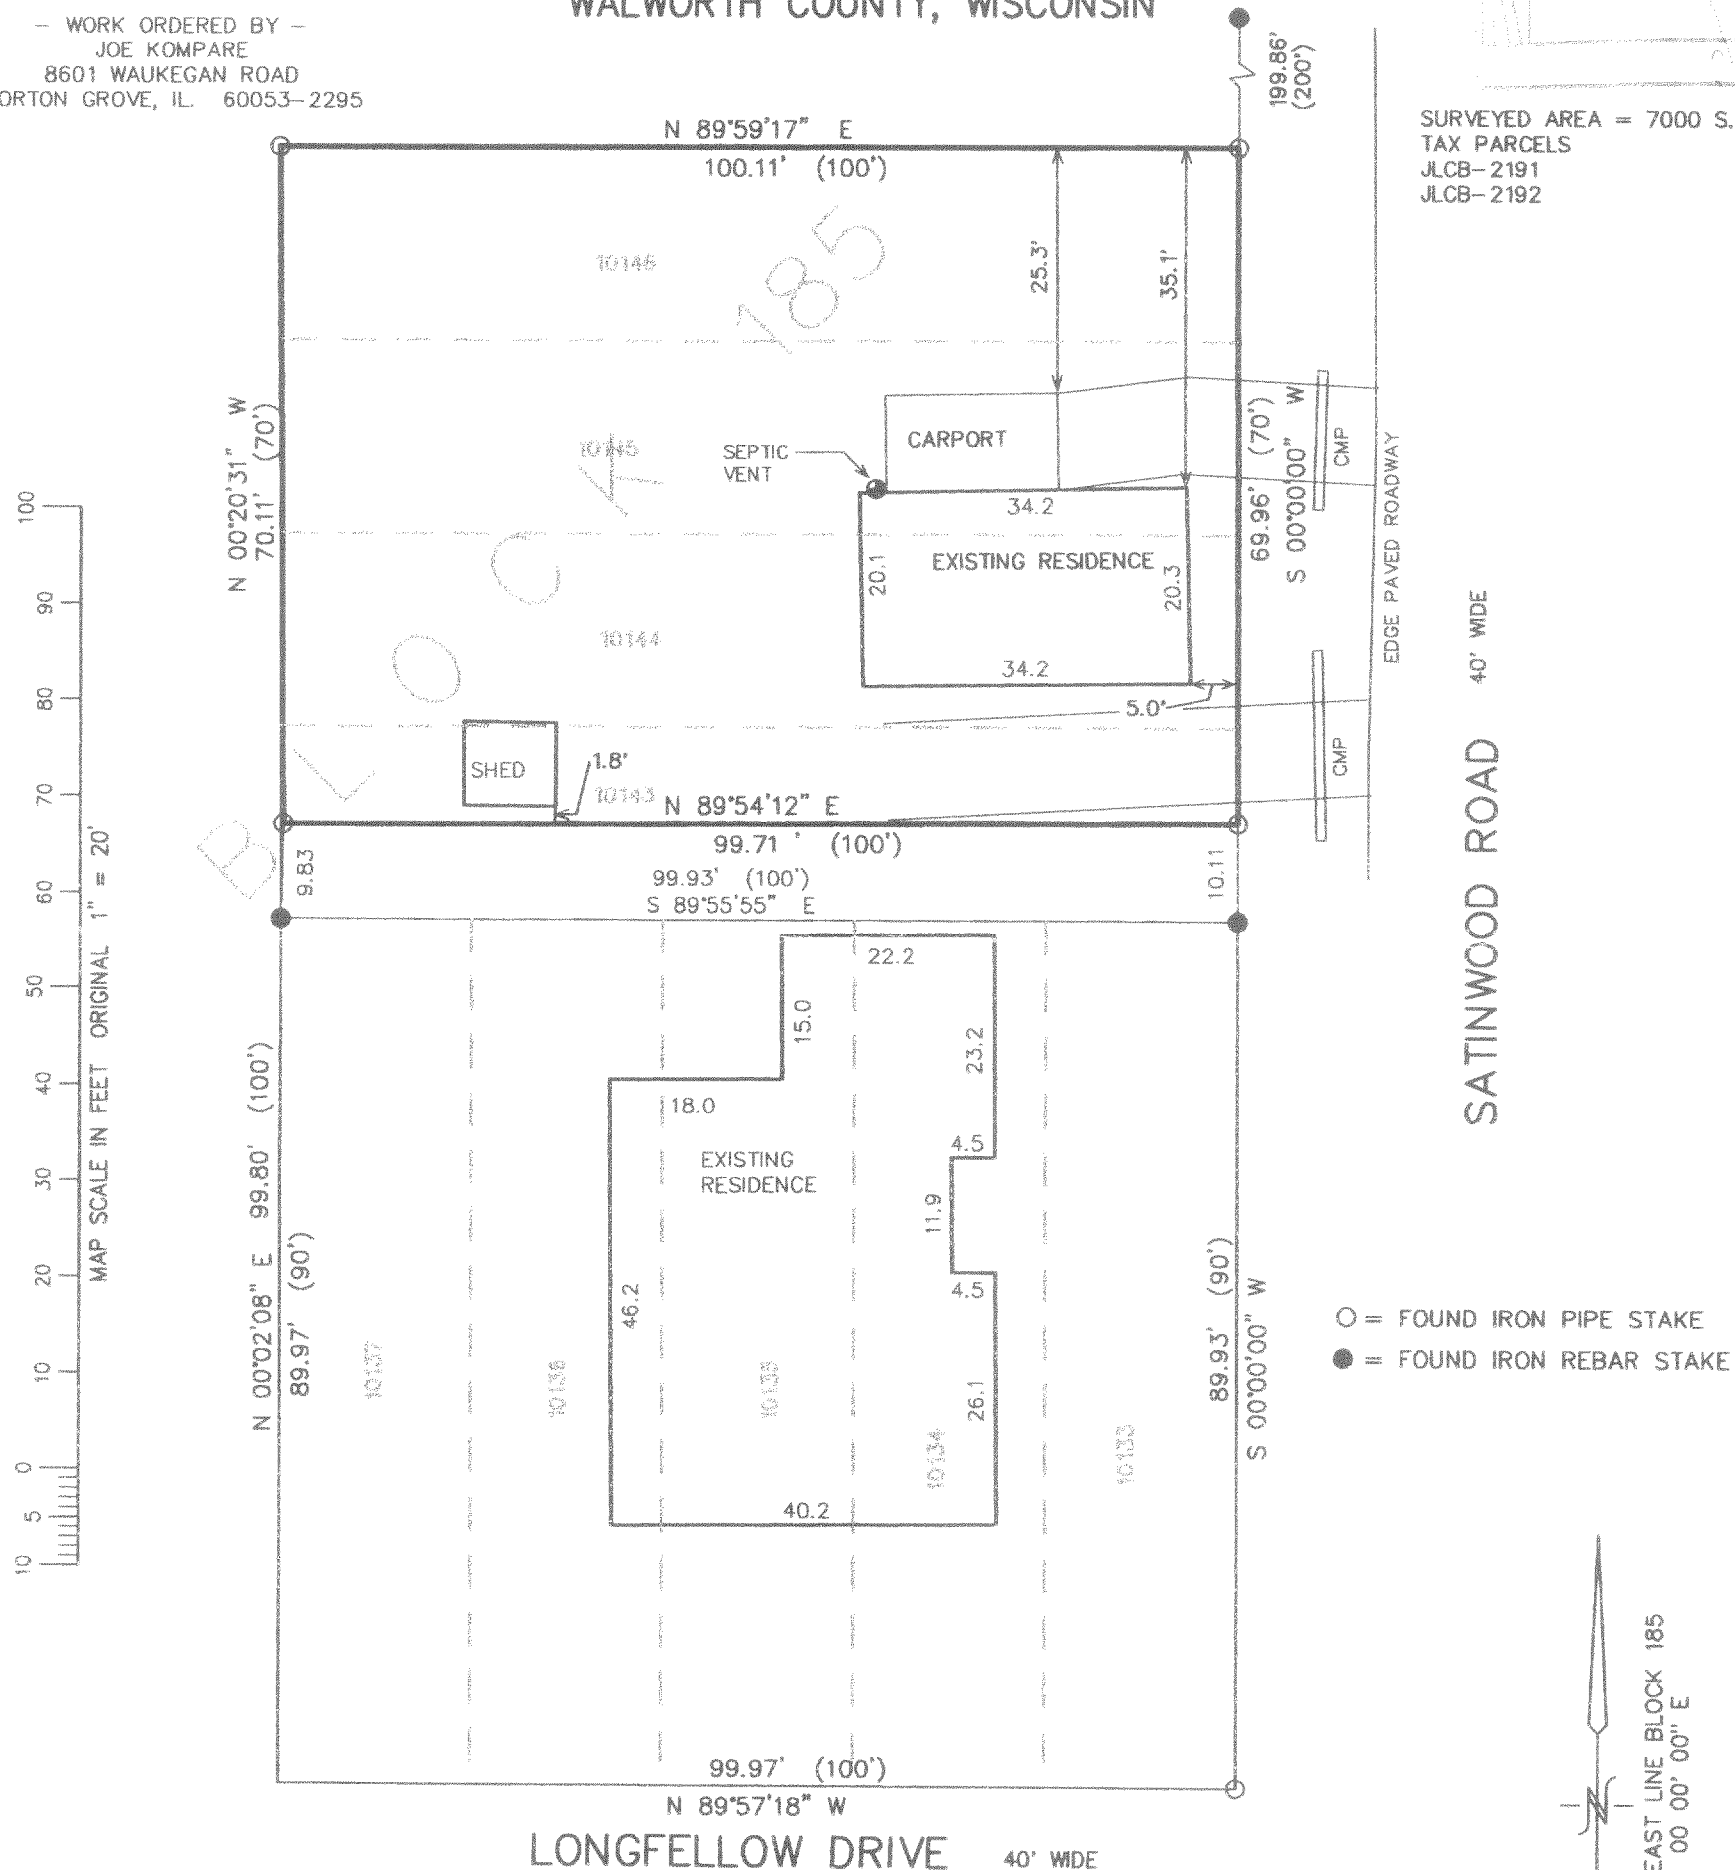

NOTE: COPIES OF THIS MAP TO WHICH THE FOLLOWING CERTIFICATE WILL APPLY SHOW SURVEYOR'S ORIGINAL SEAL AND SIGNATURE IN RED INK. COPIES BY ANY OTHER MEANS MAY HAVE ALTERATIONS WHICH DO NOT REPRESENT THE SURVEYOR'S WORK PRODUCT.

I HEREBY CERTIFY THAT THE ABOVE DESCRIBED PROPERTY HAS BEEN SURVEYED UNDER MY DIRECTION AND THAT THE ABOVE MAP IS A TRUE REPRESENTATION THEREOF AND SHOWS THE SIZE AND LOCATION OF THE PROPERTY AND ITS EXTERIOR BOUNDARIES. THIS SURVEY IS MADE FOR THE USE OF THE PRESENT OWNERS OF THE PROPERTY, AND ALSO THOSE WHO PURCHASE, MORTGAGE, OR GUARANTEE THE TITLE THERETO WITHIN ONE YEAR FROM THE DATE HEREOF.

DATED: 10/20/99

PETER S. GORDON R.L.S. 2101

PROJECT 5419
DATE: 10-12-99
SHEET 1 OF 1

JLCB-2191
JLCB-2192
217-1823