


FARRIS, HANSEN, & ASSOCIATES, INC.  
ENGINEERING, ARCHITECTURE, SURVEYING  
7 RIDGWAY COURT — P.O. BOX 437, ELKHORN, WISCONSIN, 53121  
PHONE: (414) 723-2098 FAX: (414) 723-5886

PLAT OF SURVEY  
THE NORTH 1/2 OF LOT 10143 & LOTS 10144 THRU 10146 OF BLOCK 185  
LAKE COMO BEACH SUBDIVISION  
LOCATED IN THE TOWN OF GENEVA  
WALWORTH COUNTY, WISCONSIN

— WORK ORDERED BY —  
JOE KOMPARE  
8130 W. 45th PLACE  
LYONS, IL 60534

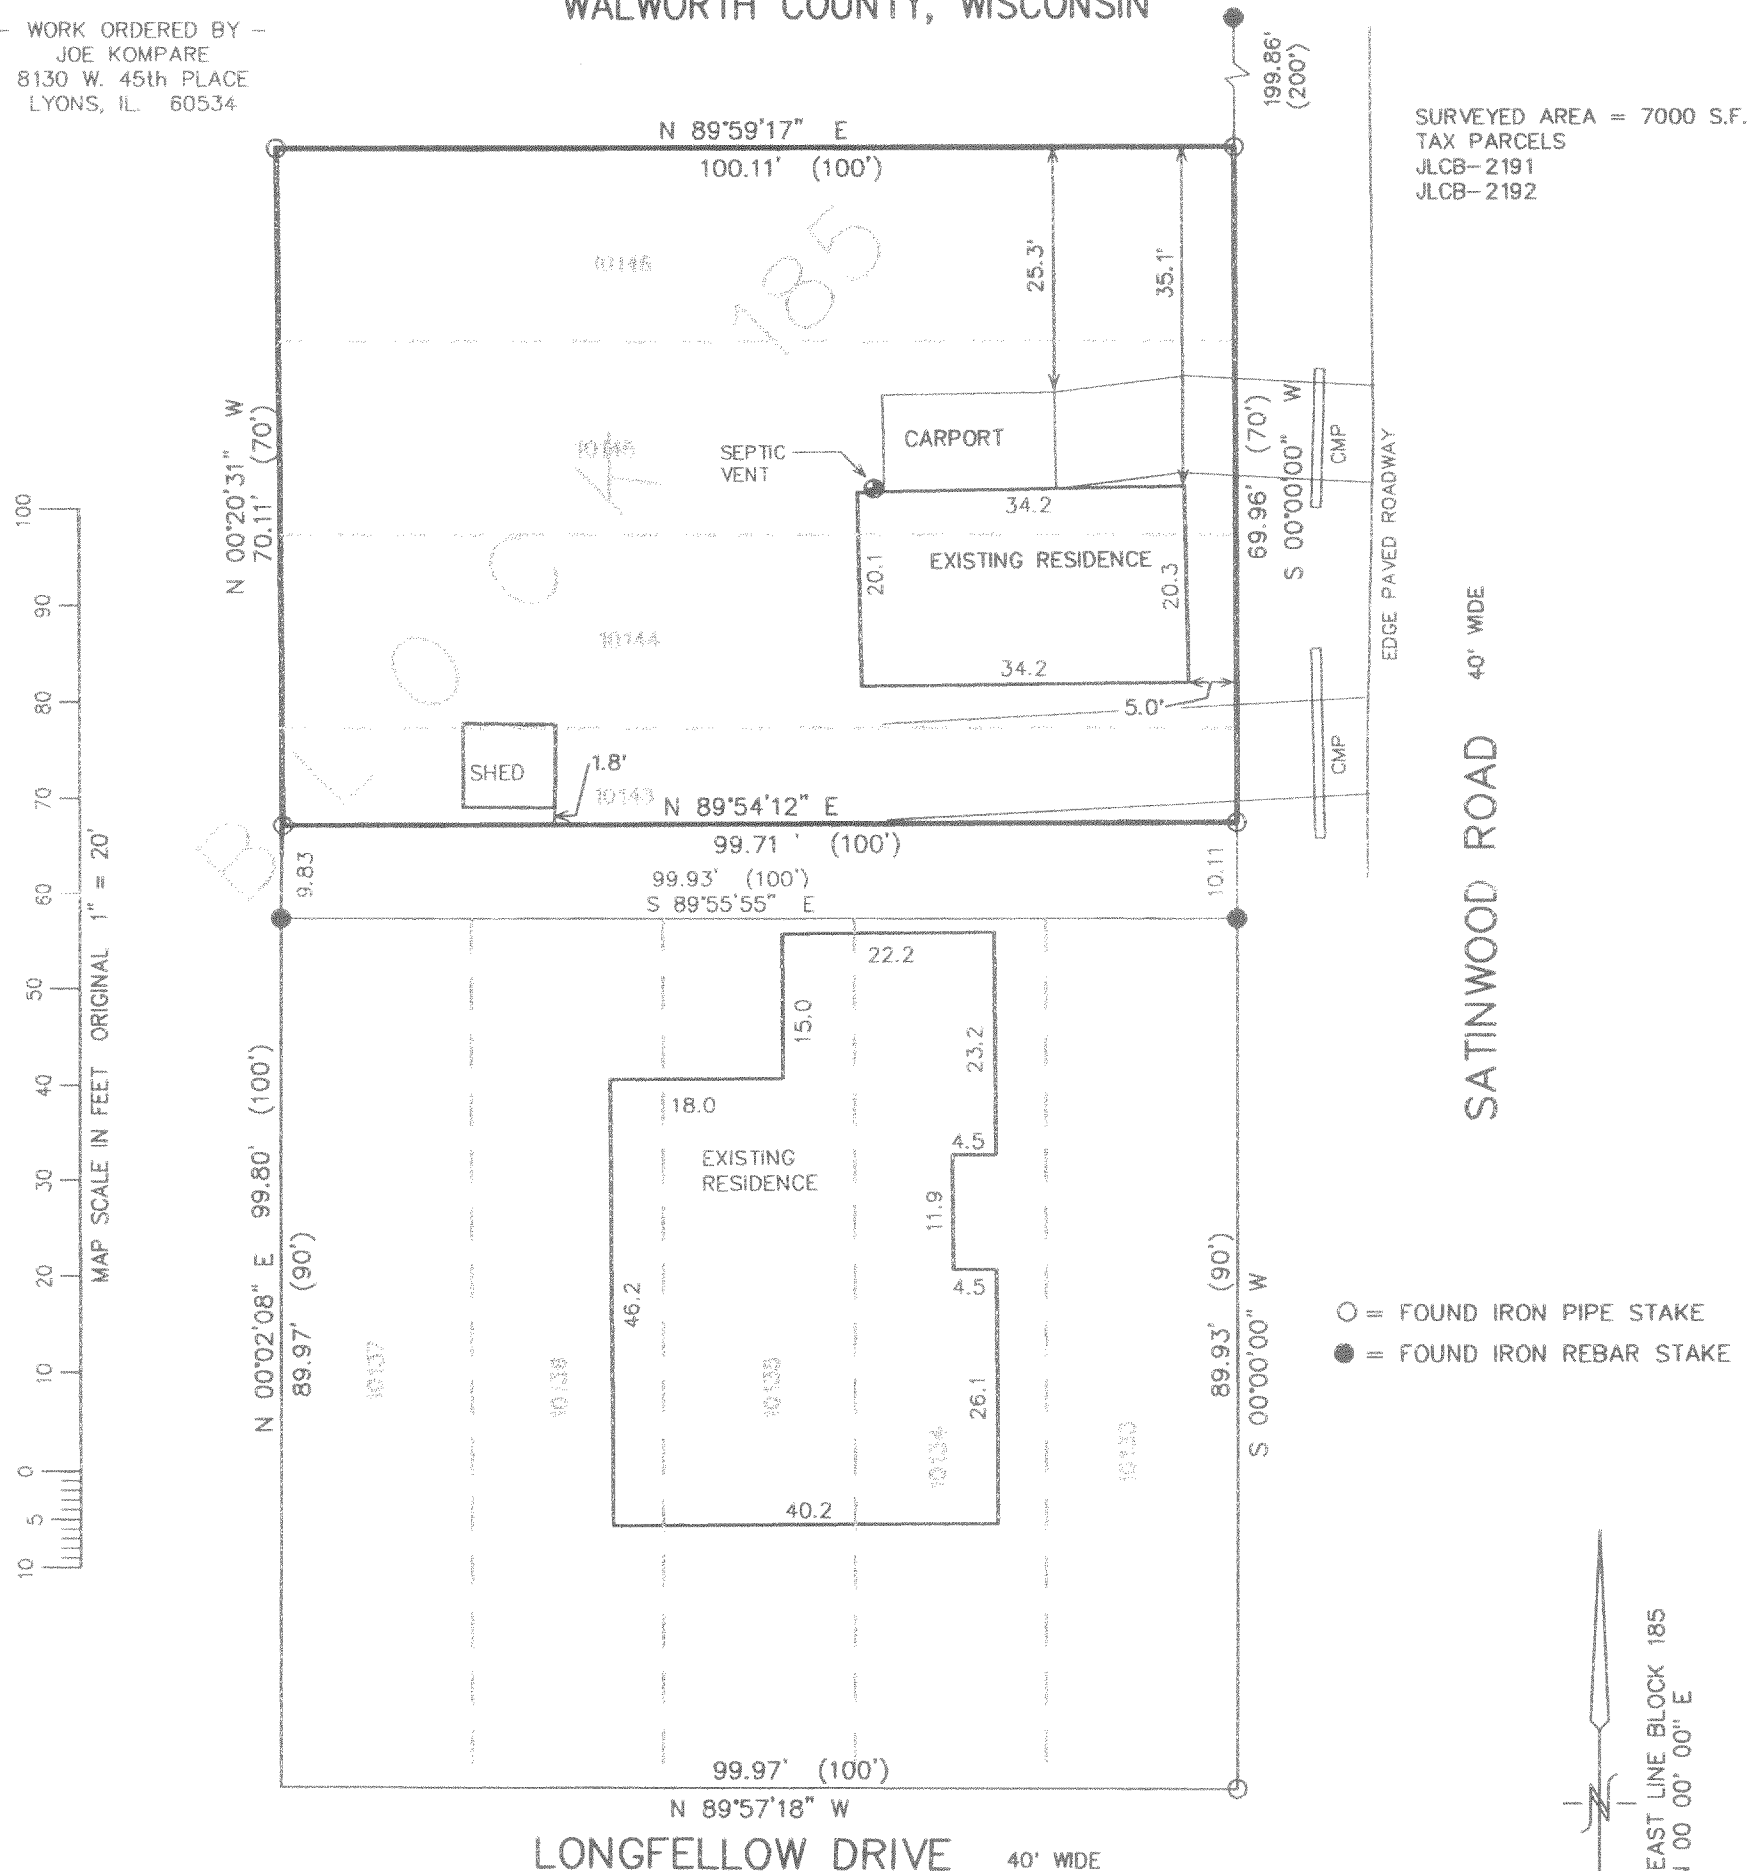


NOTE: COPIES OF THIS MAP TO WHICH THE FOLLOWING CERTIFICATE WILL APPLY SHOW  
SURVEYOR'S ORIGINAL SEAL AND SIGNATURE IN RED INK. COPIES BY ANY OTHER MEANS MAY HAVE ALTERATIONS  
WHICH DO NOT REPRESENT THE SURVEYOR'S WORK PRODUCT.

I HEREBY CERTIFY THAT THE ABOVE DESCRIBED PROPERTY HAS BEEN SURVEYED UNDER MY DIRECTION AND THAT THE  
ABOVE MAP IS A TRUE REPRESENTATION THEREOF AND SHOWS THE SIZE AND LOCATION OF THE PROPERTY AND ITS  
EXTERIOR BOUNDARIES. THIS SURVEY IS MADE FOR THE USE OF THE PRESENT OWNERS OF THE PROPERTY, AND  
ALSO THOSE WHO PURCHASE, MORTGAGE, OR GUARANTEE THE TITLE THERETO WITHIN ONE YEAR FROM THE DATE  
HEREOF.

DATED: 10/20/99

REVISED 10/29/99  
CONNECT ADDRESS + LOGAL DESC.

PETER S. GORDON R.L.S. 2101

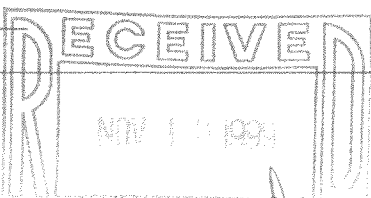

PROJECT 5419  
DATE: 10-12-99  
SHEET 1 OF 1

JLCB-2191  
209 2 9 1999

217-1833