


AMBIT LAND SURVEYING
P. O. Box 42
Bassett, WI. 53101

PLAT OF SURVEY OF

PHONE 414-537-4874
FAX 414-537-4221


Lots 4460 and 4461 as designated and delineated on the map entitled "Second Map of Lake Camp Beach, Walworth County, Wisconsin" and recorded in the Office of the Register of Deeds in and for the County of Walworth, State of Wisconsin, on the 1st day of May, 1926.

LEGAL DESCRIPTION AS PROVIDED.

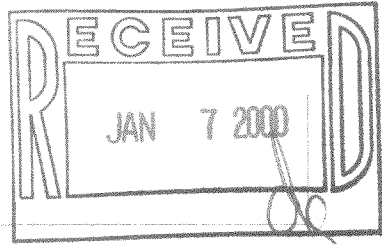

LAKEVIEW

DRIVE

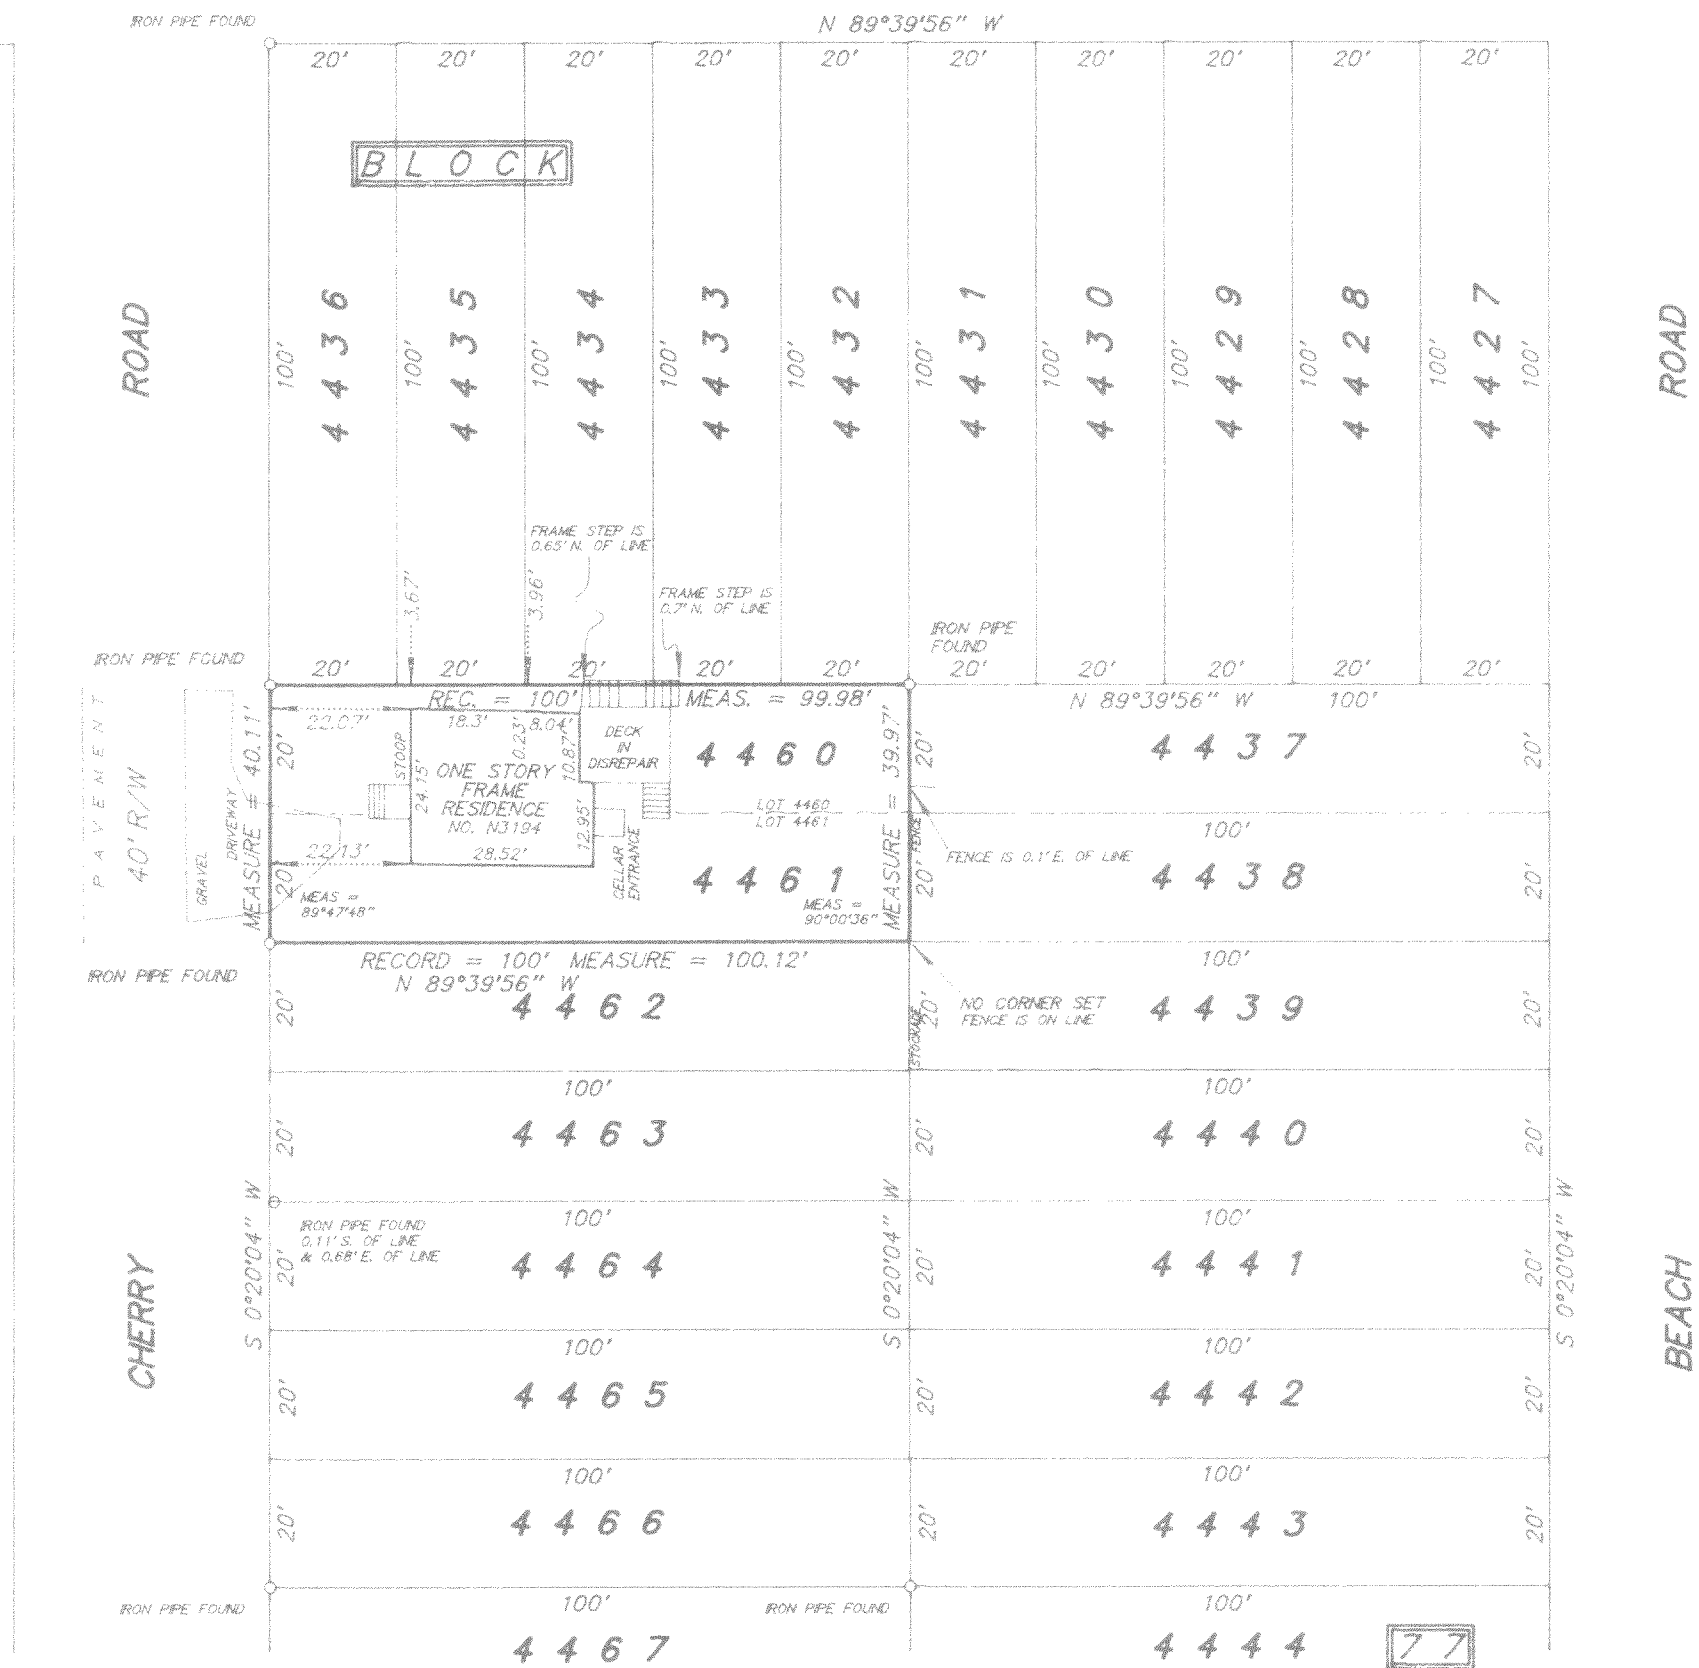

SCALE

1 inch = 30 feet

ORDERED BY D. Schiltz / Davison, Mulligan & Schiltz, Ltd.

JOB NO. 99086

I hereby certify that I have surveyed the above described property and the above plat is a true representation thereof and shows the size and location of the property, its exterior boundaries, the location and dimensions of all visible structures thereon, boundary fences, apparent easements and roadways and visible encroachments, if any.

This survey is made for the exclusive use of the present owners of the property, and also those who purchase, mortgage, or guarantee the title thereto within one year from the date hereof.

Dated at Bassett, Wisconsin this _____ day of _____ 1999.

Mark A. Bolender
Wisconsin Registered Land Surveyor S - 1784

JLCB-878

217-1847