

Kenneth B. Abernathy Jr.
Wisconsin Registered Land Surveyor S-1594



Rt. 3, Box 273
Elkhorn, Wisconsin 53121
Phone: (414) 723-4260 (office)
(414) 723-4813 (residence)

PLAT OF SURVEY

LOTS 10168 THRU 10177, BLOCK 185,
LAKE COMO BEACH SUBDIVISION,
LOCATED IN SECTION 28, TOWN 2
NORTH, RANGE 17 EAST, GENEVA
TOWNSHIP, WALWORTH COUNTY,
WISCONSIN.

OWNER: EUGENE VALLANGO
48 RIVERVIEW DR.
FOX LAKE, IL. 60020

TAMARACK ROAD 40' WIDE

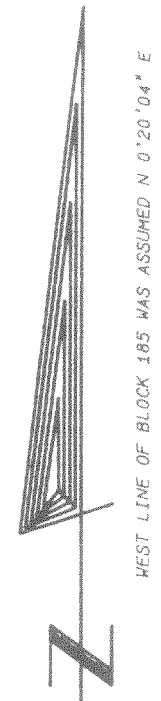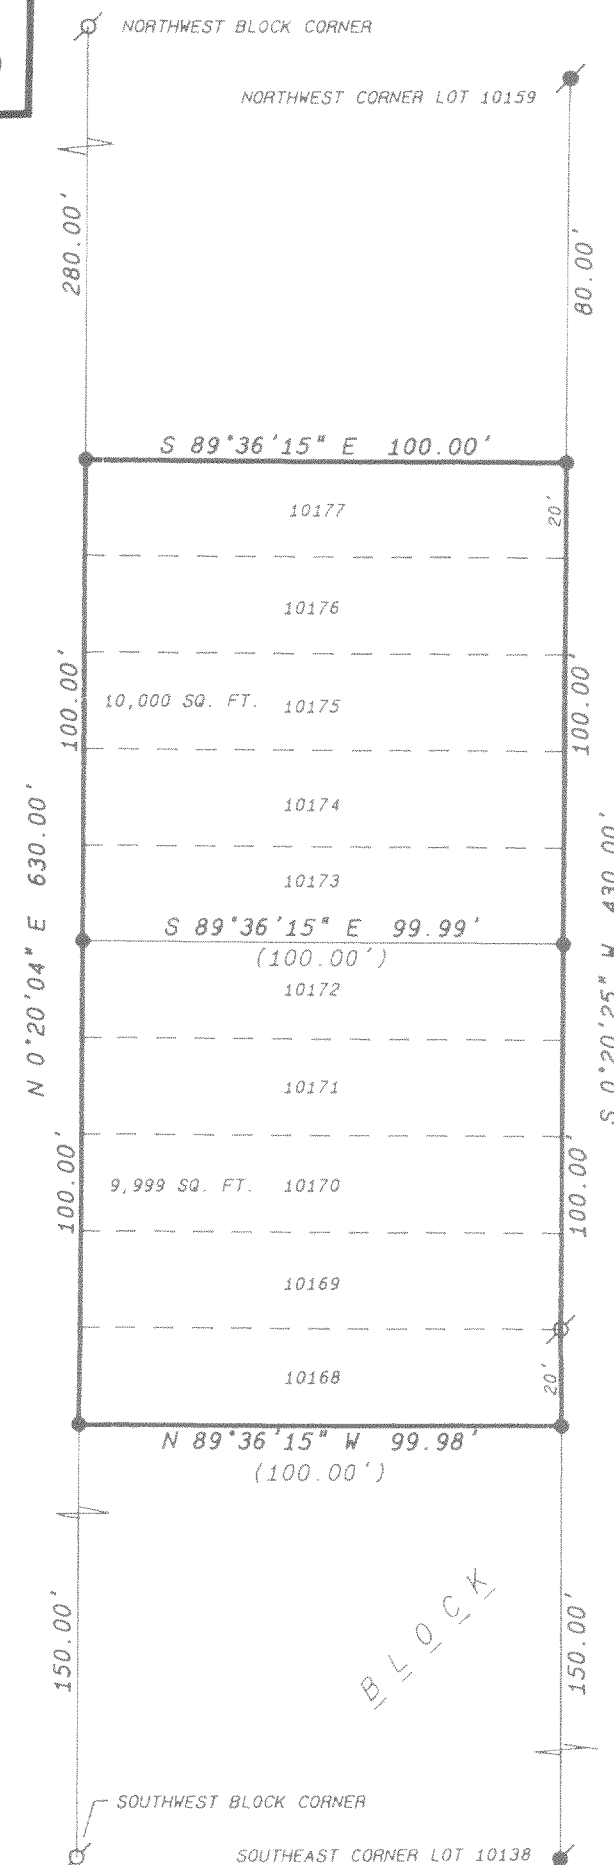

SCALE: 1"=40 FEET

Legend

- * FOUND IRON PIPE
 ● FOUND IRON ROD
 □ FOUND BRASS CAPPED MONUMENT
 ⊗ FOUND CONCRETE MONUMENT
 + CHISEL CUT IN CONCRETE
 ● SET IRON ROD, 24" LONG, WEIGHING
 1.5 LBS./LINEAL FT., 3/4" DIA.
 ● SET IRON ROD, 30" LONG, WEIGHING
 4.5 LBS./LINEAL FT., 1-11/16" DIA.
 (xx) RECORDED AS DIMENSION
 —X—X— EXISTING FENCE

"I hereby certify that I have surveyed the above described property and that the above map is a true representation thereof and shows the size and location of the property, its exterior boundaries, the location of all visible structures and dimensions of all principal buildings thereon, boundary fences, apparent easements, roadways and visible encroachments, if any."

"This survey is made for the use of the present owners of the property, and also those who purchase, mortgage, or guarantee the title thereto within one year from date hereof."

KENNETH B. ABERNATHY, JR.
WISCONSIN REGISTERED LAND SURVEYOR,

Date: NOV. 19 1999 Job No: 99.1106

JLCB-2198

217-1859