
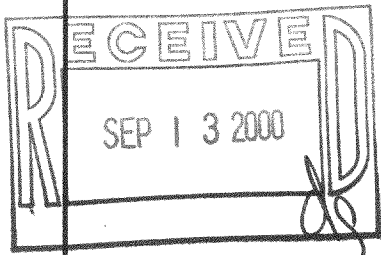


ABELL
SURVEYING & MAPPING

1140 SEQUOIA STREET • DELAVAN, WISCONSIN 53115
262-728-6737

BEAVER DRIVE

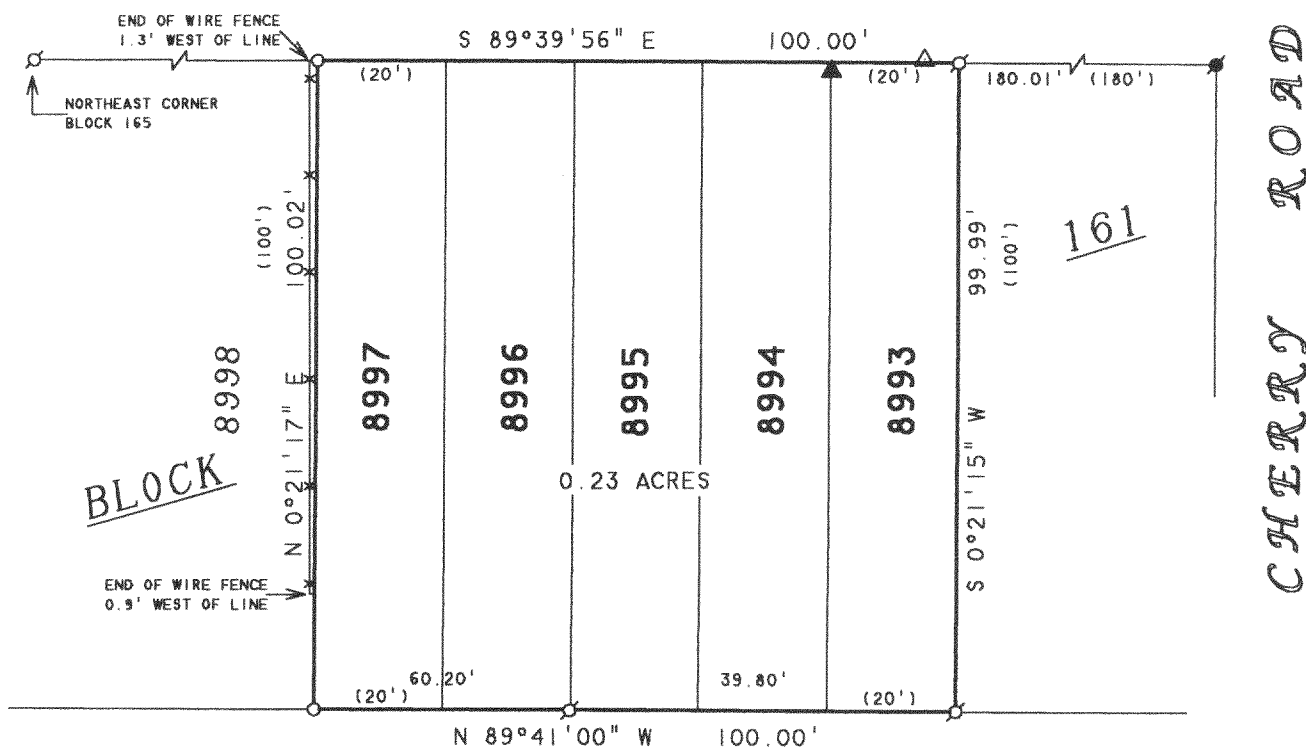

PLAT OF SURVEY OF

LOTS 8993-8997, BLOCK 161, LAKE COMO BEACH
SUBDIVISION, T2N, R17E, WALWORTH COUNTY,
WISCONSIN.

ORDERED BY: COREEN WENZEL
367 OAK TERRACE
APT. D
LAKE GENEVA, WI 53147

NOTE: BEARINGS ARE REFERENCED TO
EXISTING SURVEY RECORDS.

N



SCALE 1"=30'

LEGEND

- - IRON PIPE FOUND
- - IRON ROD FOUND
- - 1" DIA. IRON PIPE SET
- x—x— - WIRE FENCE
- △ - UTILITY POLE
- ▲ - WATER BOX
- () - RECORDED AS

I, DAVID F. ABELL, DO HEREBY CERTIFY THAT I HAVE SURVEYED THE PROPERTY HEREON
DESCRIBED ACCORDING TO THE OFFICAL RECORDS AND THAT THE PLAT HEREON IS A
CORRECT REPRESENTATION OF THE PROPERTY LINES TO THE BEST OF MY KNOWLEDGE AND
BELIEF.

David F. Abell

DAVID F. ABELL
WISCONSIN REGISTERED LAND SURVEYOR, S-1596

September 6, 2000

DATE: September 6, 2000 JOB NUMBER - 00141
NOTE: THIS IS NOT A CERTIFIED COPY UNLESS SEALED.

JLCB-1933

217-1964