
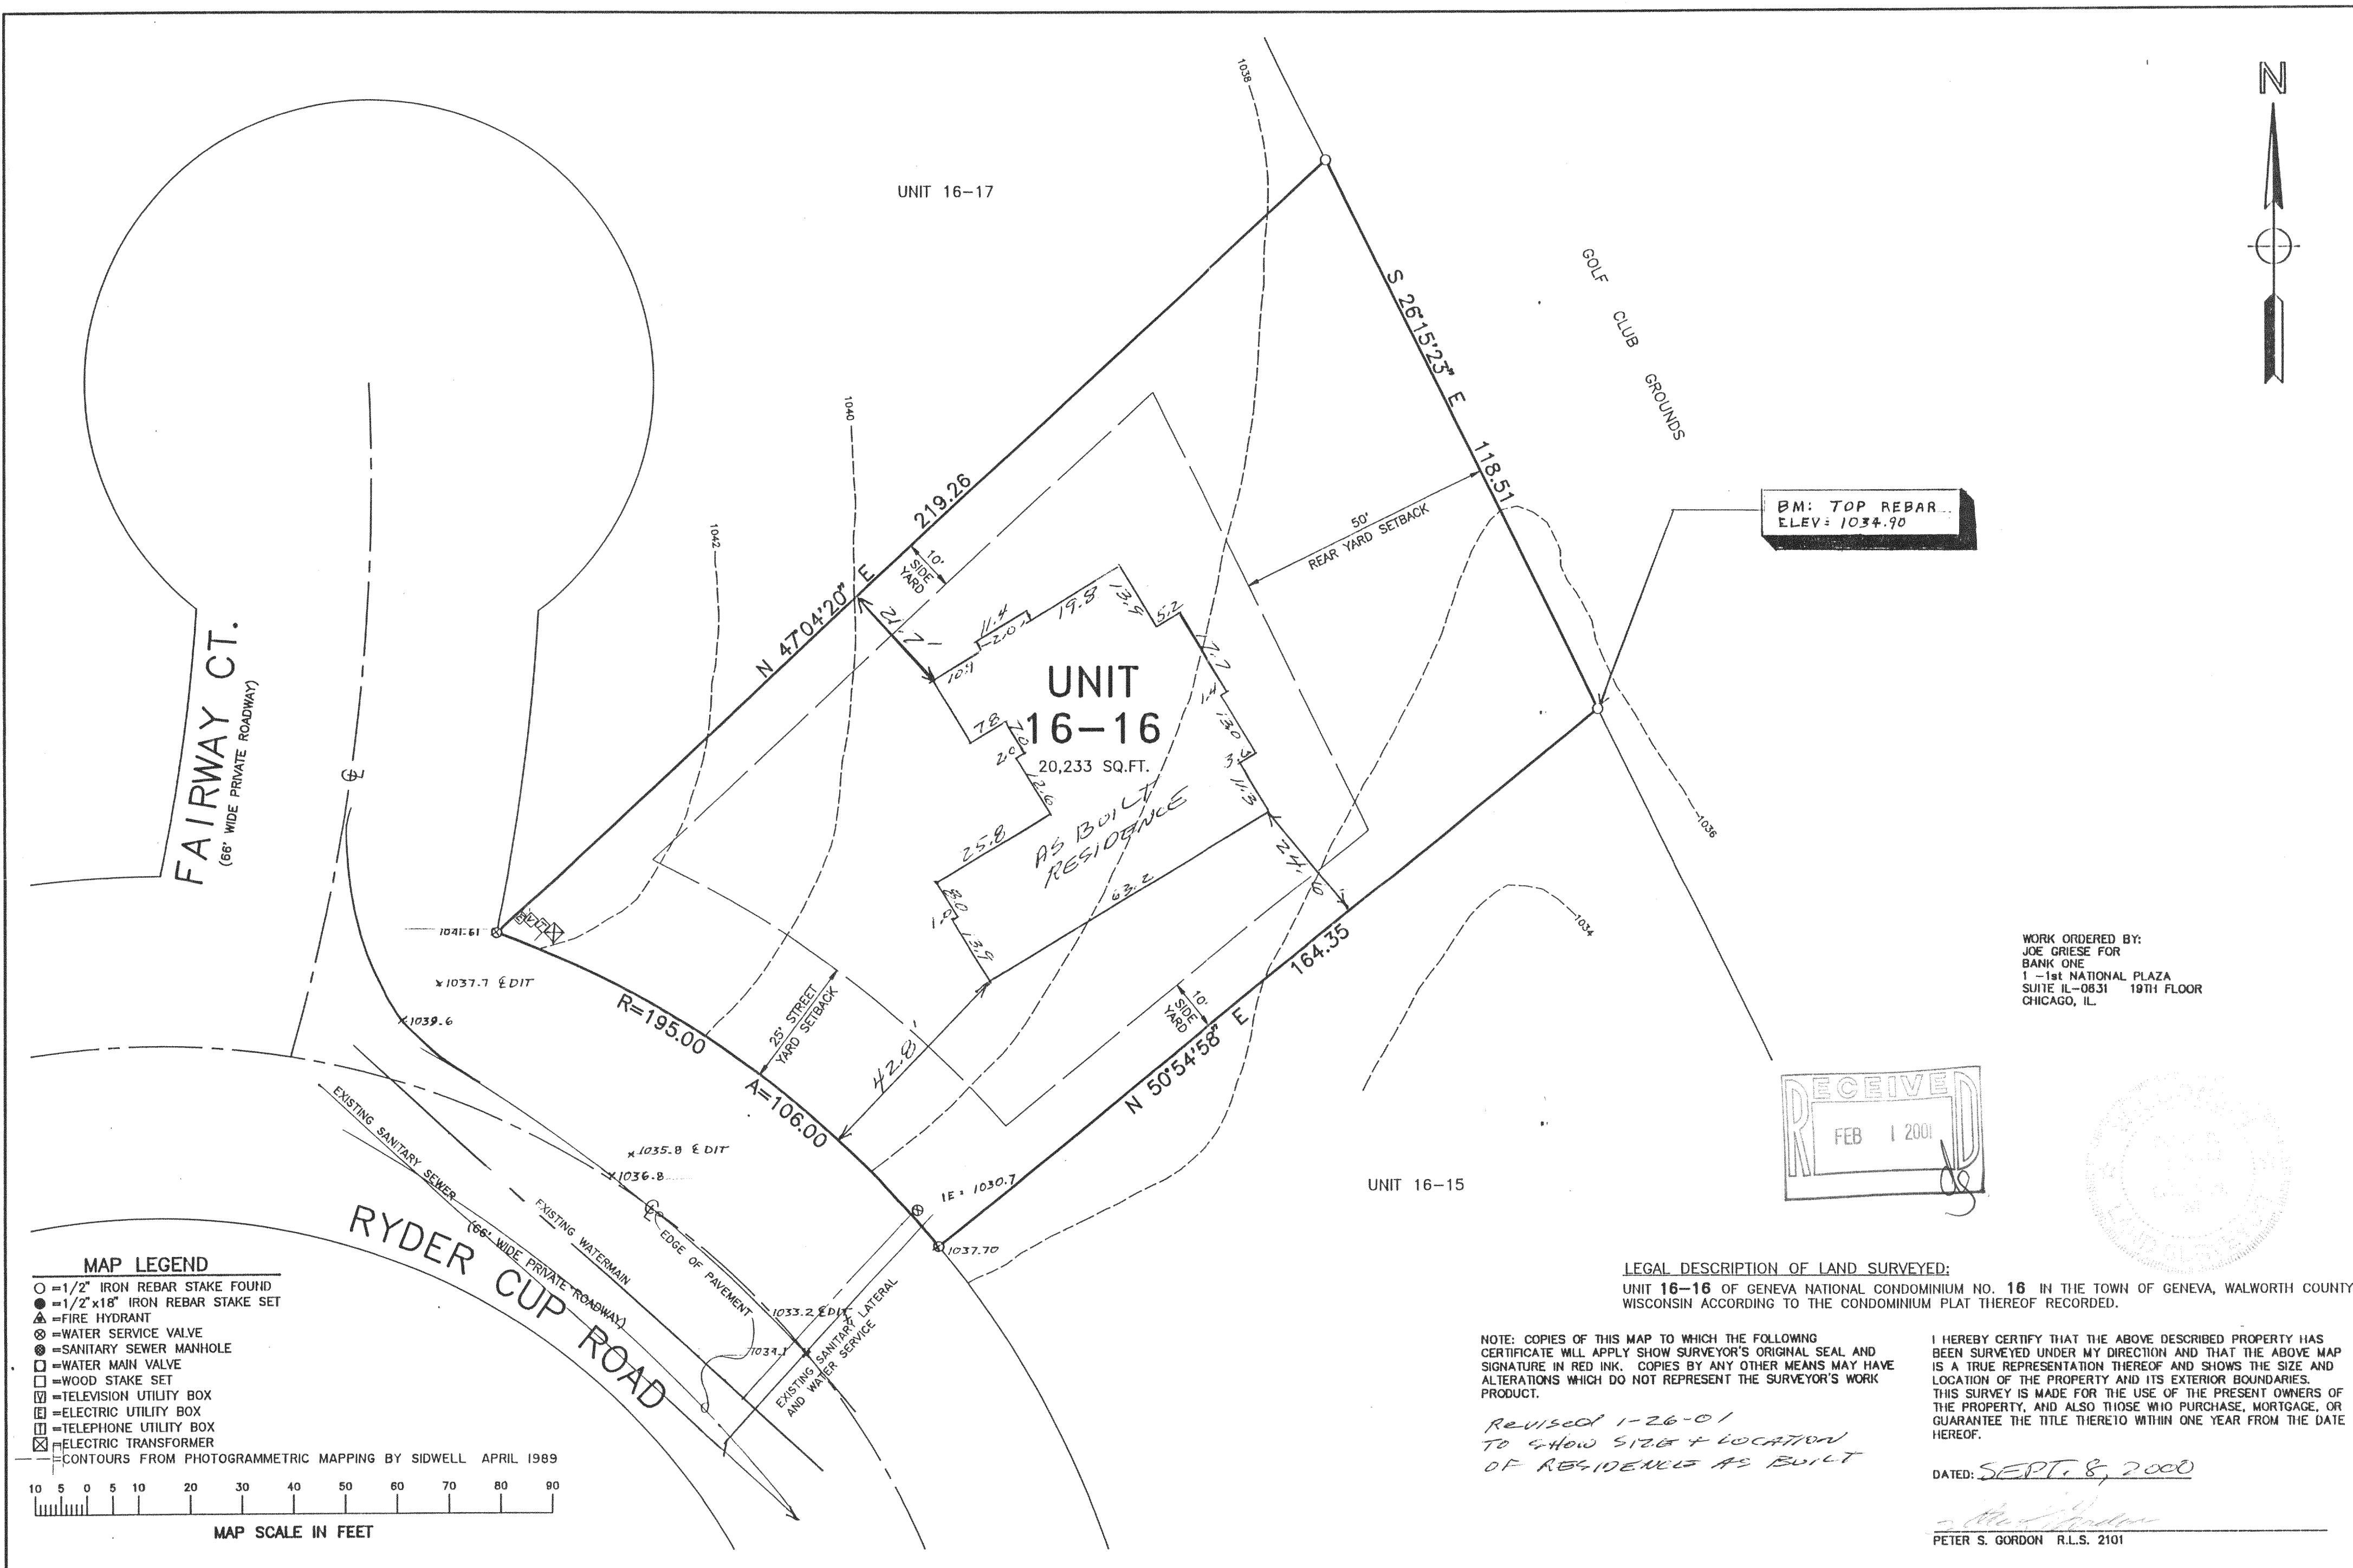


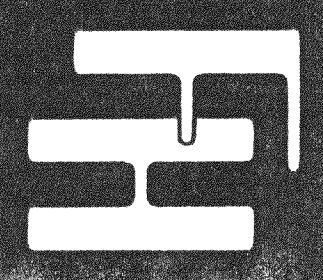

16-16 1 of 1	PROJECT NO. 3269	FARRIS, HANSEN & ASSOCIATES, INC. Engineering, Architecture, Surveying 7 Ridgway Court P.O. Box 437 ELKHORN, WISCONSIN 53121 Office: (414) 723-2098 Fax: (414) 723-5886	PLAT OF SURVEY	 GENEVA NATIONAL UNIT 16-16 1620 Ryder Cup Road Town of Geneva, Walworth Co., Wisconsin	
	DATE 08-27-91				