
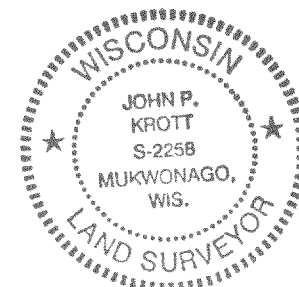
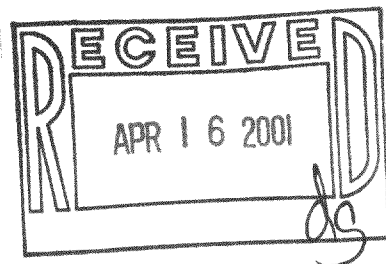


PLAT OF SURVEY

J.K. SURVEYING INC.
N3705 WILLOWBEND LANE
LAKE GENEVA, WI, 53147
262-248-3697

- OF -

PARCEL "B" LOTS 2897 THRU 2900 ALL INCLUSIVE BLOCK 50 LAKE COMO BEACH SUBDIVISION
LOCATED IN TOWN 2 NORTH, RANGE 17 EAST, WALWORTH COUNTY, WISCONSIN.

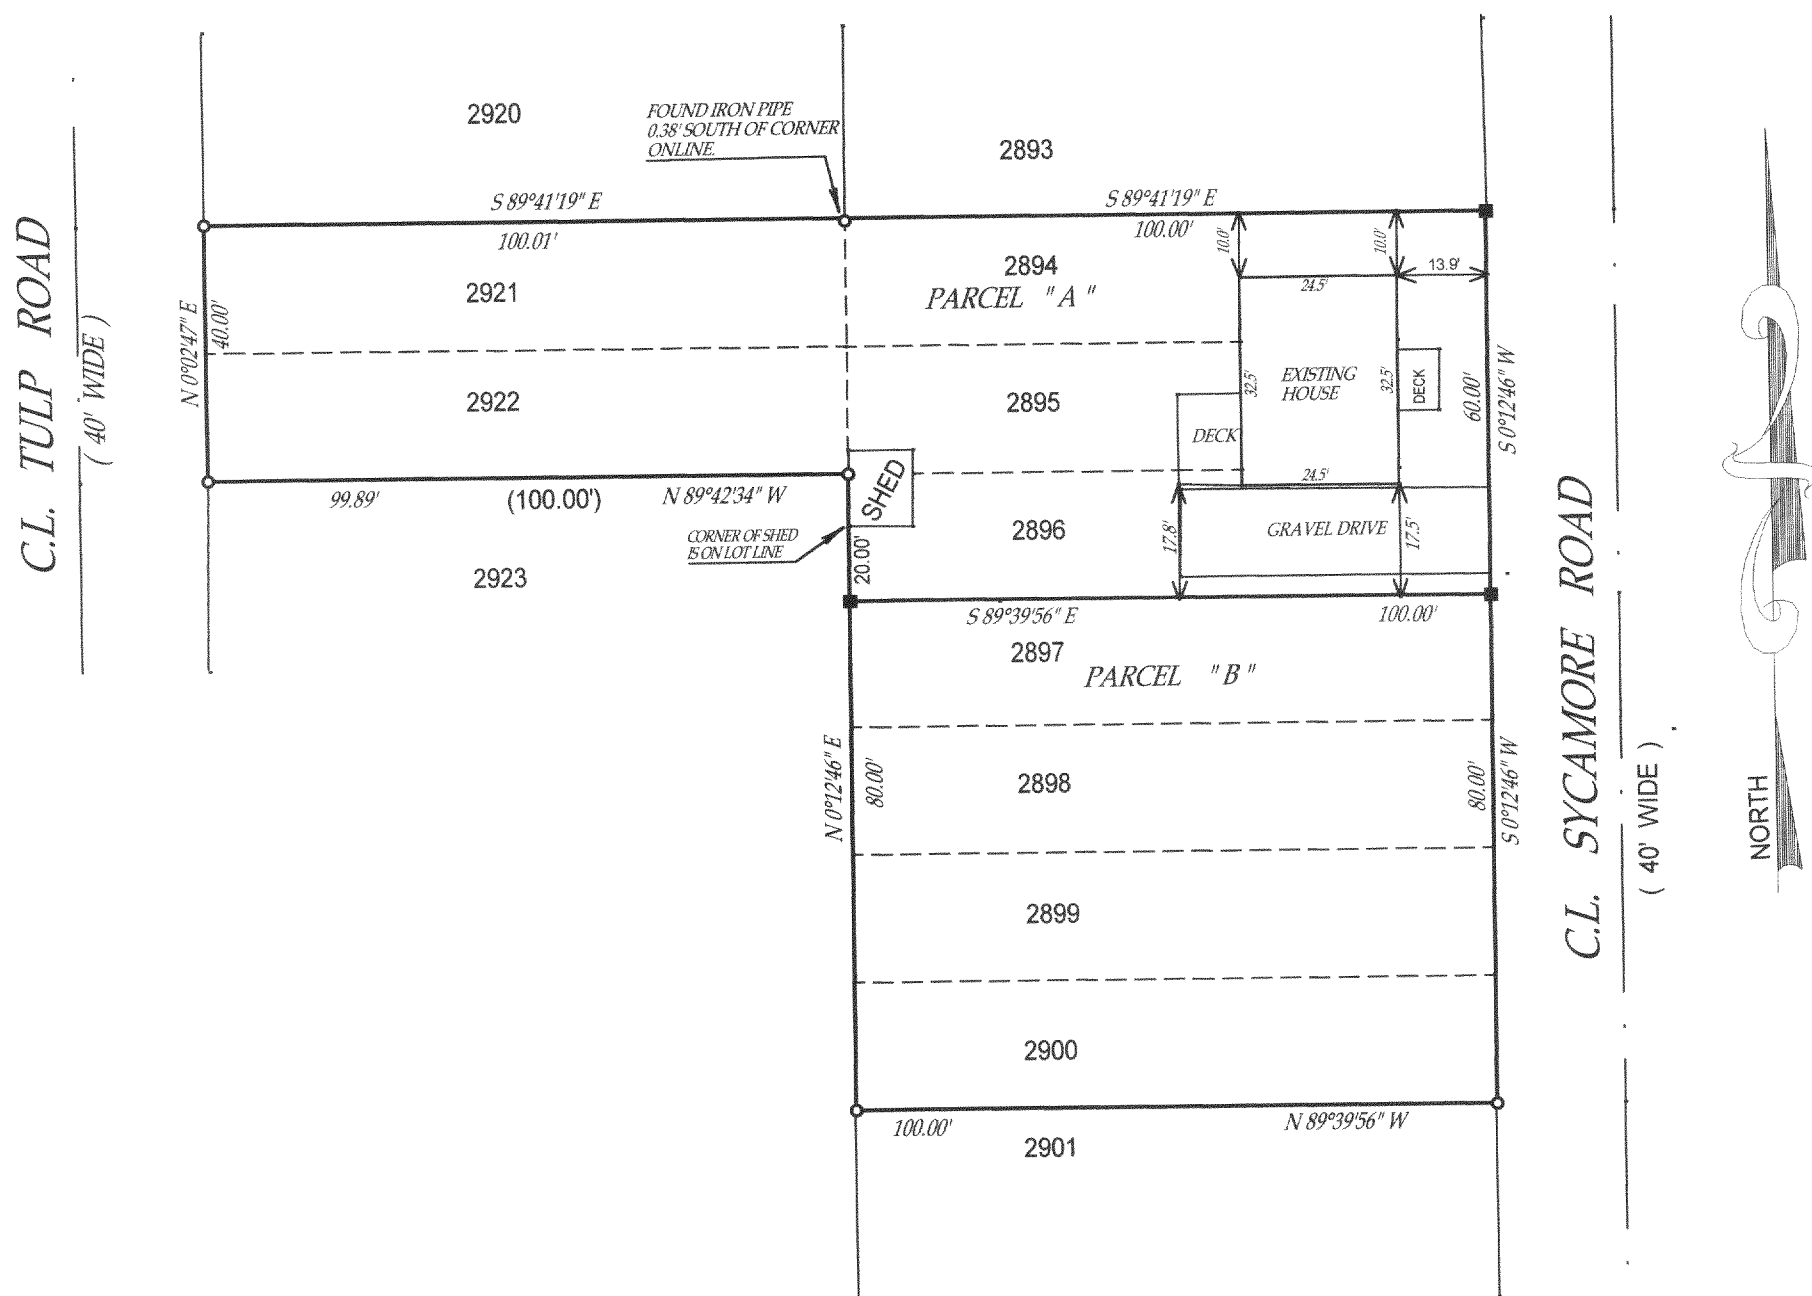

TAX ID # JLCB 00512

DATED THIS 5 TH, DAY OF MARCH 20 01.

JOHN KROTT S - 2258
Wisconsin Registered Land Surveyor
(original if signed in red)

JLCB-512

217-2061