


48

Survey for Albert Janota, 6/13/31.
 consumers Sub. 1910 Leavitt St
 Chicago, Ill.

plat of survey of Lots 74, 75 & 76
 consumers subdivision on south
 shore of Como Lake, Walworth
 County Wisconsin, made for
 Albert Janota by J. G. Skeels surveying
 and engineering Co, June 13, 1931,
 J. G. Skeels C. E.,
 & S. M. Palmer, Asst

Iron stks found at X coors
 " " set at ox " North
 All distances O.K.
 Scale 50 ft. to 1 inch.

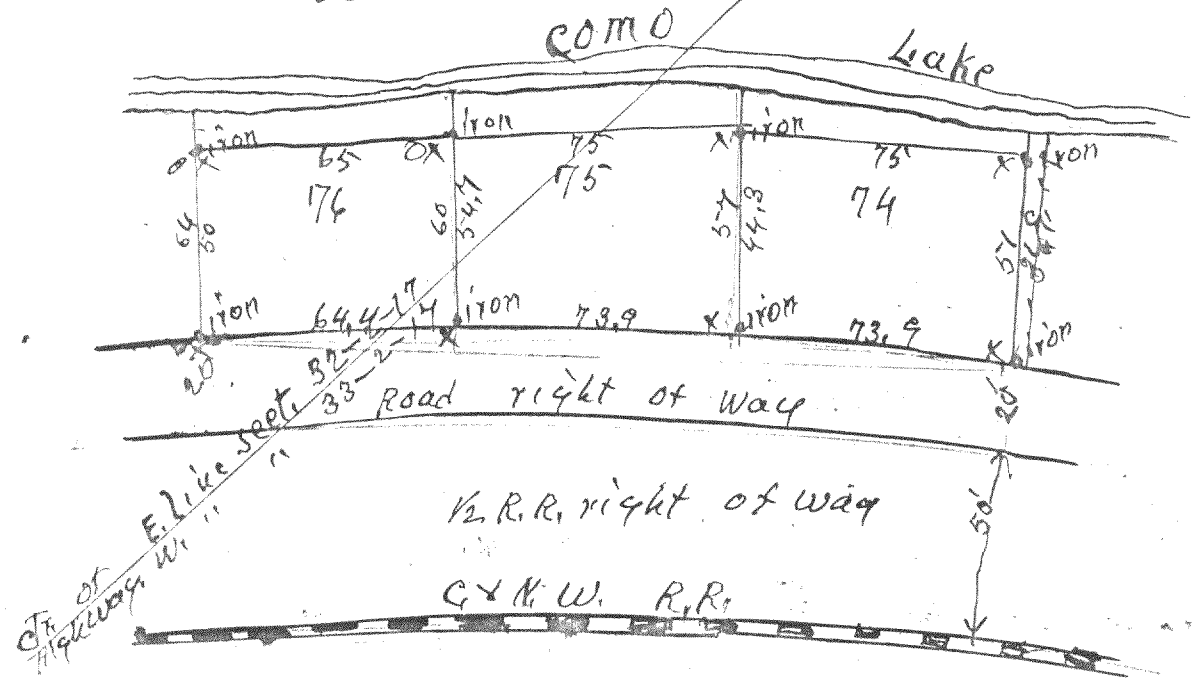

Consumer's Co. Subd Lots 74, 75 & 76

217-207 Sh