


PLAT OF SURVEY
LOTS 9427 THRU 9431, & LOT 9437
BLOCK 170
LAKE COMO BEACH SUBDIVISION

LOCATED IN PART OF SECTION 21
TOWN 2 NORTH, RANGE 17 EAST
WALWORTH COUNTY, WISCONSIN

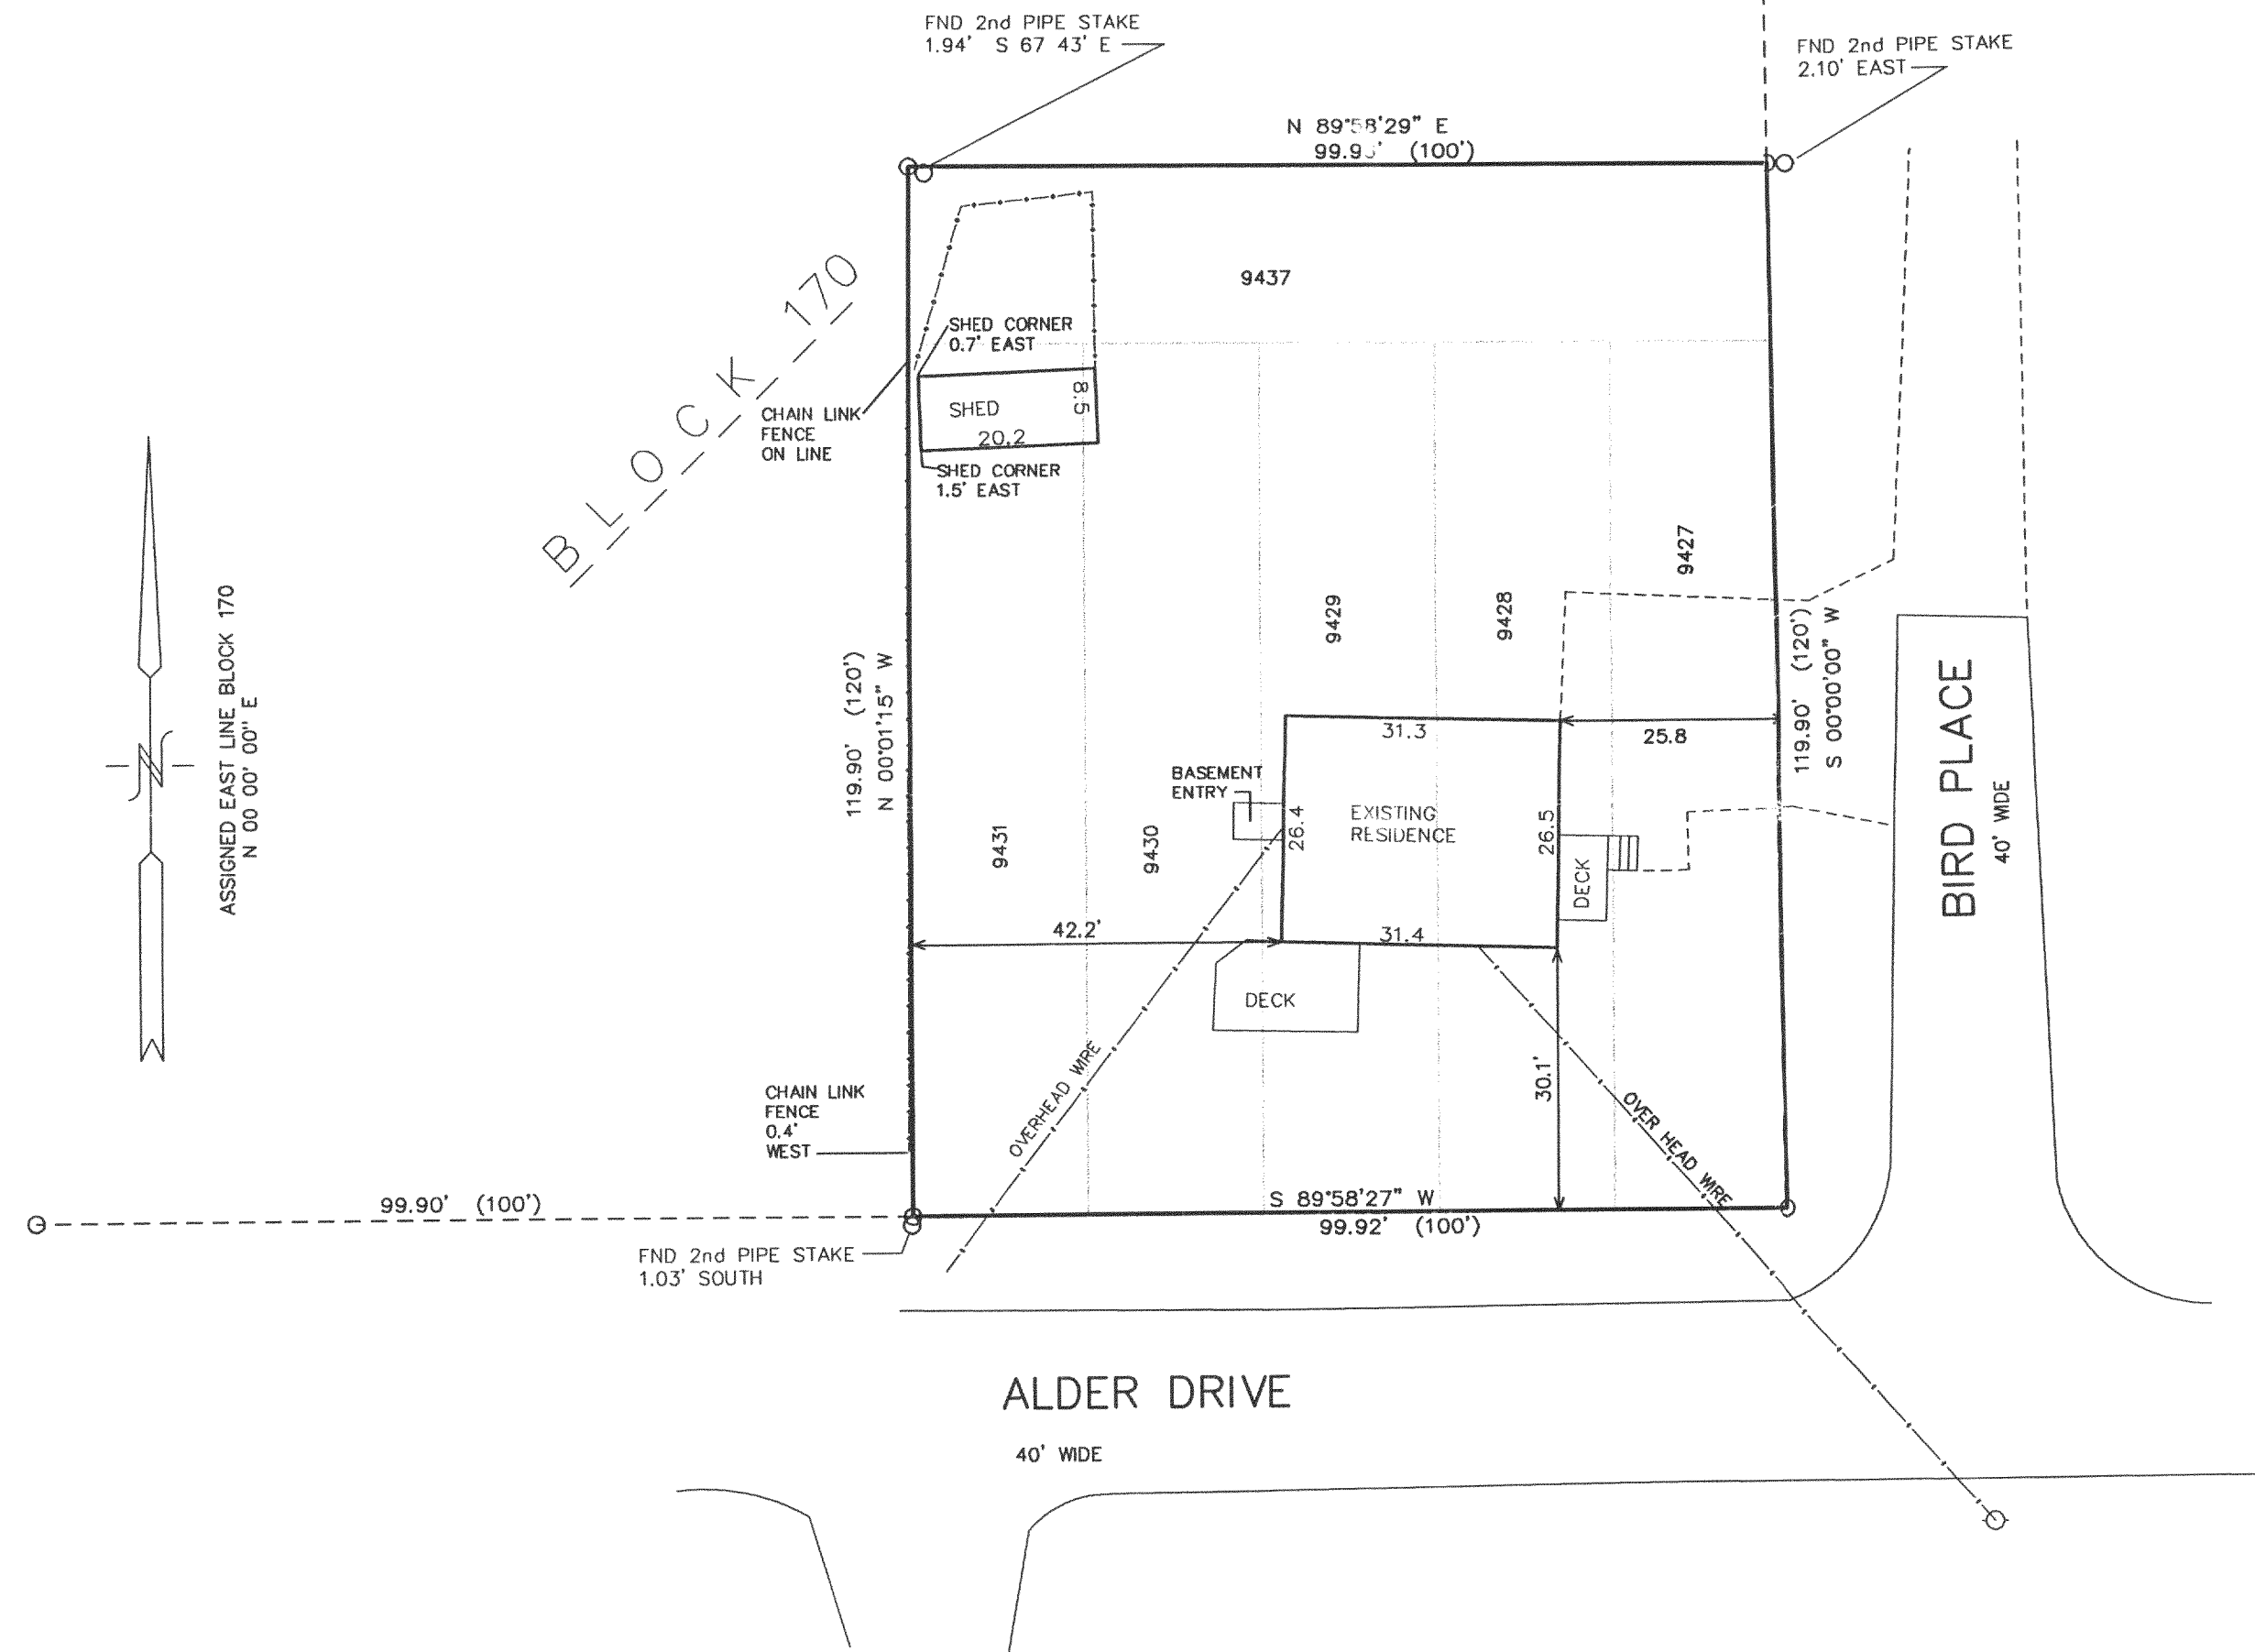


LEGEND
O = FOUND IRON PIPE STAKE
= FOUND IRON REBAR STAKE
(xxx) = RECORDED AS

NOTE: COPIES OF THIS MAP TO WHICH THE FOLLOWING
CERTIFICATE WILL APPLY SHOW SURVEYOR'S ORIGINAL SEAL
AND SIGNATURE IN RED INK. COPIES BY ANY OTHER MEANS
MAY HAVE ALTERATIONS WHICH DO NOT REPRESENT THE
SURVEYOR'S WORK PRODUCT.

I HEREBY CERTIFY THAT THE ABOVE DESCRIBED PROPERTY HAS
BEEN SURVEYED UNDER MY DIRECTION AND THAT THE ABOVE MAP
IS A TRUE REPRESENTATION THEREOF AND SHOWS THE SIZE AND
LOCATION OF THE PROPERTY AND ITS EXTERIOR BOUNDARIES.
THIS SURVEY IS MADE FOR THE USE OF THE PRESENT OWNERS
OF THE PROPERTY, AND ALSO THOSE WHO PURCHASE, MORTGAGE,
OR GUARANTEE THE TITLE THERETO WITHIN ONE YEAR FROM THE
DATE HEREOF.

DATED: MARCH 28, 2001
PETER S. GORDON R.L.S. 2101

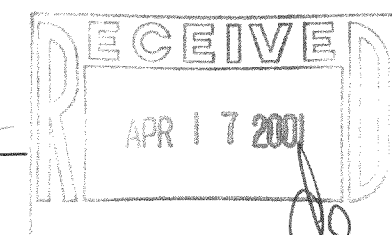

WORK ORDERED BY:
ERIC SEAVER
N3456 STH "H"
LAKE GENEVA, WI. 53147

FARRIS, HANSEN & ASSOCIATES, INC.
Engineering, Architecture, Surveying
7 Ridgway Court P.O. Box 437
ELKHORN, WISCONSIN 53121
Office: (414) 723-2098
Fax: (414) 723-5896

REVISIONS

PROJECT NO.
5761
DATE:
03-26-01
SHEET NO.
1 OF 1

MAP SCALE IN FEET ORIGINAL 1" = 20'

MAR 29 2001

217-2082
JLCB-2032