


BOUNDARY AND TOPOGRAPHIC MAPPING

LOTS 12144 - 12148 OF BLOCK 216 OF LAKE COMO BEACH
SUBDIVISION, TOWN OF GENEVA, WALWORTH COUNTY, WISCONSIN

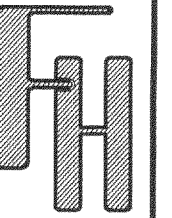


WORK ORDERED BY: JIM O'MALLEY
6835 W. HIGGINS AVENUE
CHICAGO, IL 60656

FARRIS, HANSEN & ASSOCIATES, INC.
ENGINEERING - ARCHITECTURE - SURVEYING
7 RIDGWAY COURT P.O. BOX 437
ELKHORN, WISCONSIN 53121
OFFICE: (262) 723-2098 FAX: (262) 723-5886

REVISIONS

PROJECT NO.
5461
DATE:
12/28/99
SHEET NO.
1 OF 1

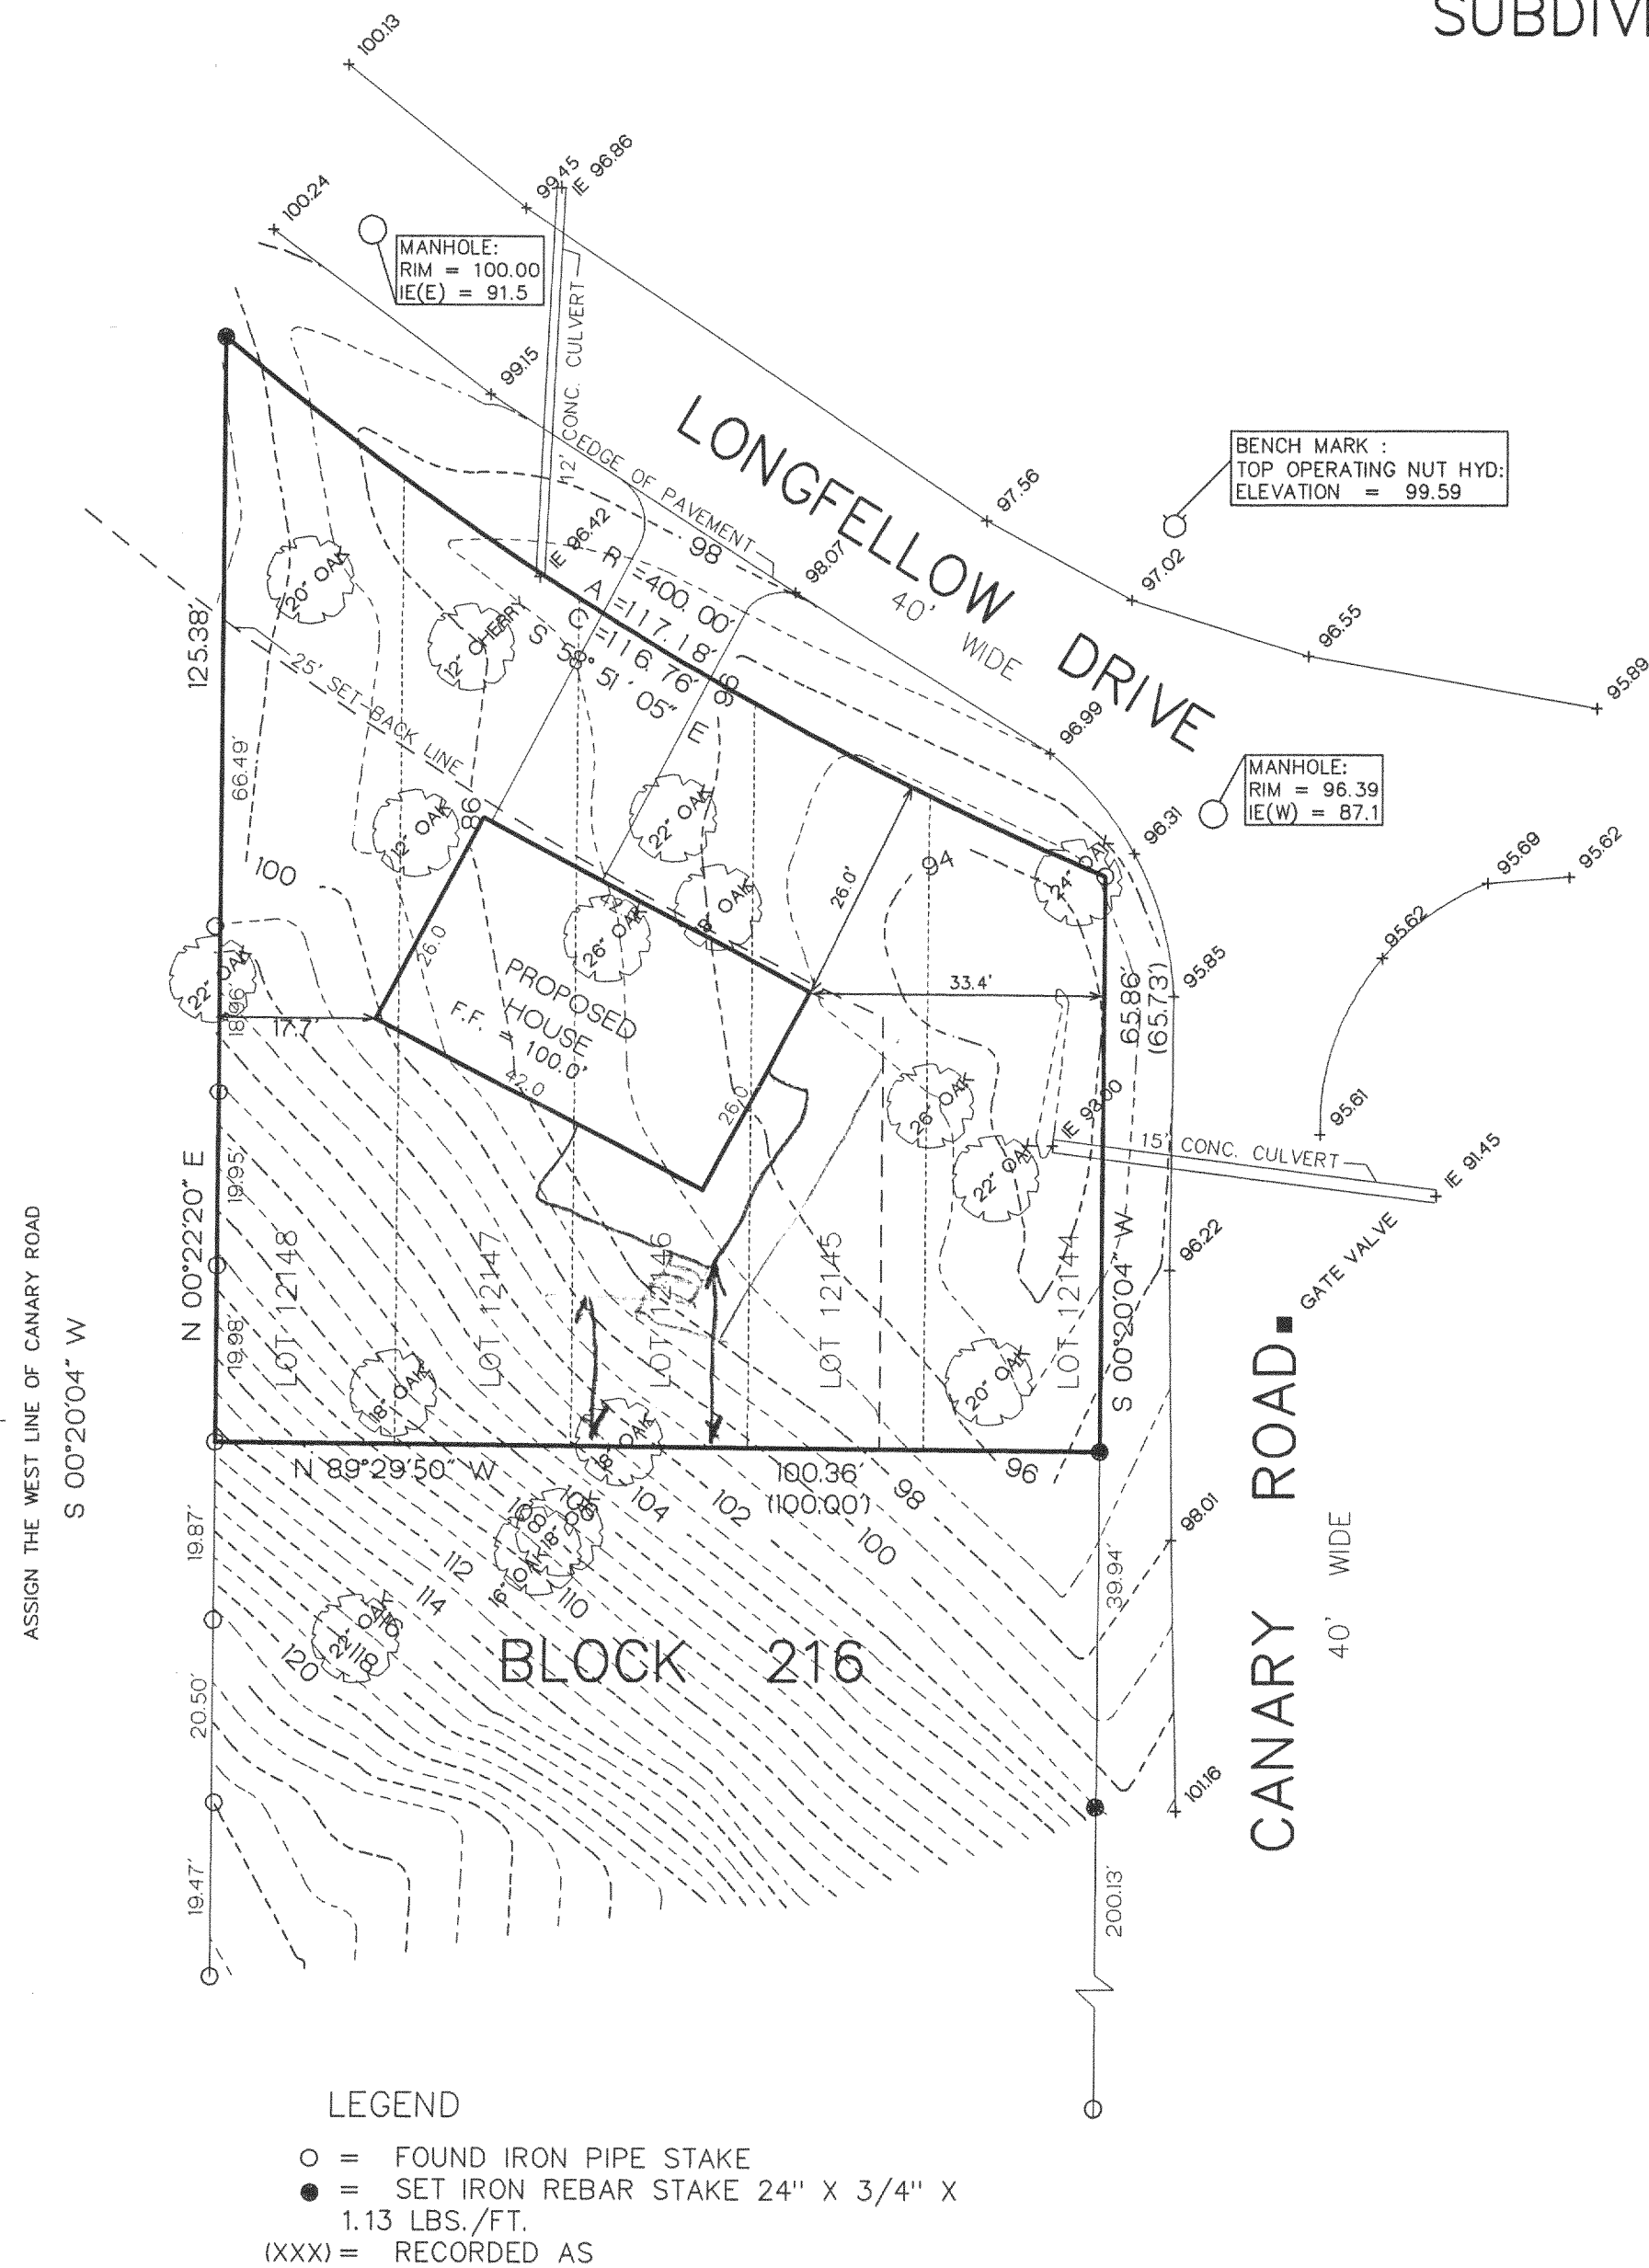

NOTE: COPIES OF THIS MAP TO WHICH THE FOLLOWING CERTIFICATE WILL APPLY SHOW SURVEYOR'S ORIGINAL SEAL AND SIGNATURE IN RED INK. COPIES BY ANY OTHER MEANS MAY HAVE ALTERATIONS WHICH DO NOT REPRESENT THE SURVEYOR'S WORK PRODUCT.


I HEREBY CERTIFY THAT THE ABOVE DESCRIBED PROPERTY HAS BEEN SURVEYED UNDER MY DIRECTION AND THAT THE ABOVE MAP IS A TRUE REPRESENTATION THEREOF AND SHOWS THE SIZE AND LOCATION OF THE PROPERTY AND ITS EXTERIOR BOUNDARIES. THIS SURVEY IS MADE FOR THE USE OF THE PRESENT OWNERS OF THE PROPERTY, AND ALSO THOSE WHO PURCHASE, MORTGAGE, OR GUARANTEE THE TITLE THERETO WITHIN ONE YEAR FROM THE DATE HEREOF.

DATED: 12-28-99

Peter S. Gordon
PETER S. GORDON R.L.S. 2101

REVISED 01-06-2000
REVISE PRO RES. LOC.

*To show size + location
of ASISOLT improvements*

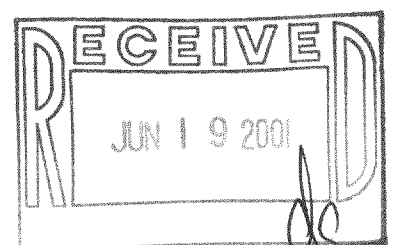

JAN 06 2000

JLB-2643 217-2116