


PLAT OF SURVEY

LEGAL DESCRIPTION

AS FOUND IN VOL. 537, PAGE 124, JOC #218445 OF WALWORTH COUNTY RECORDS


LOT 47 AND LOT 48 OF CONSUMERS COMPANY SUBDIVISION, LOCATED IN PARTS OF SECTIONS 28, 32 AND 33, ALL IN TOWN 2 NORTH, RANGE 17 EAST, GENEVA TOWNSHIP, WALWORTH COUNTY, WISCONSIN. ALL THAT PORTION OF THE NORTH 85 FEET OF THE CHICAGO AND NORTHWESTERN RAILROAD RIGHT-OF-WAY DESCRIBED AS FOLLOWS: BEGIN AT THE SW CORNER OF LOT 48, CONSUMERS COMPANY SUBDIVISION, THENCE CONTINUE SOUTH ON A LINE THAT IS PERPENDICULAR TO THE CENTERLINE OF THE RAILROAD RIGHT-OF-WAY 20 FEET TO THE POINT OF BEGINNING; CONTINUE THENCE SOUTH ON THIS LINE TO THE SOUTH LINE OF THE RIGHT-OF-WAY; THENCE EAST ALONG SAID SOUTH LINE OF THE RAILROAD RIGHT-OF-WAY, TO A POINT THAT IS APPROXIMATELY 105 FEET ON A LINE FROM THE SE CORNER OF LOT 47, WHICH LATTER LINE IS ALSO PERPENDICULAR TO THE CENTERLINE OF THE RIGHT-OF-WAY; THENCE NORTH ON THE SAID LAST DESCRIBED LINE TO THE NORTH BOUNDARY OF SAID RAILROAD RIGHT-OF-WAY; THENCE WEST TO THE POINT OF BEGINNING.

OWNER:
WILLIAM STACK
P.O. BOX 267
LAKE GENEVA, WI. 53147

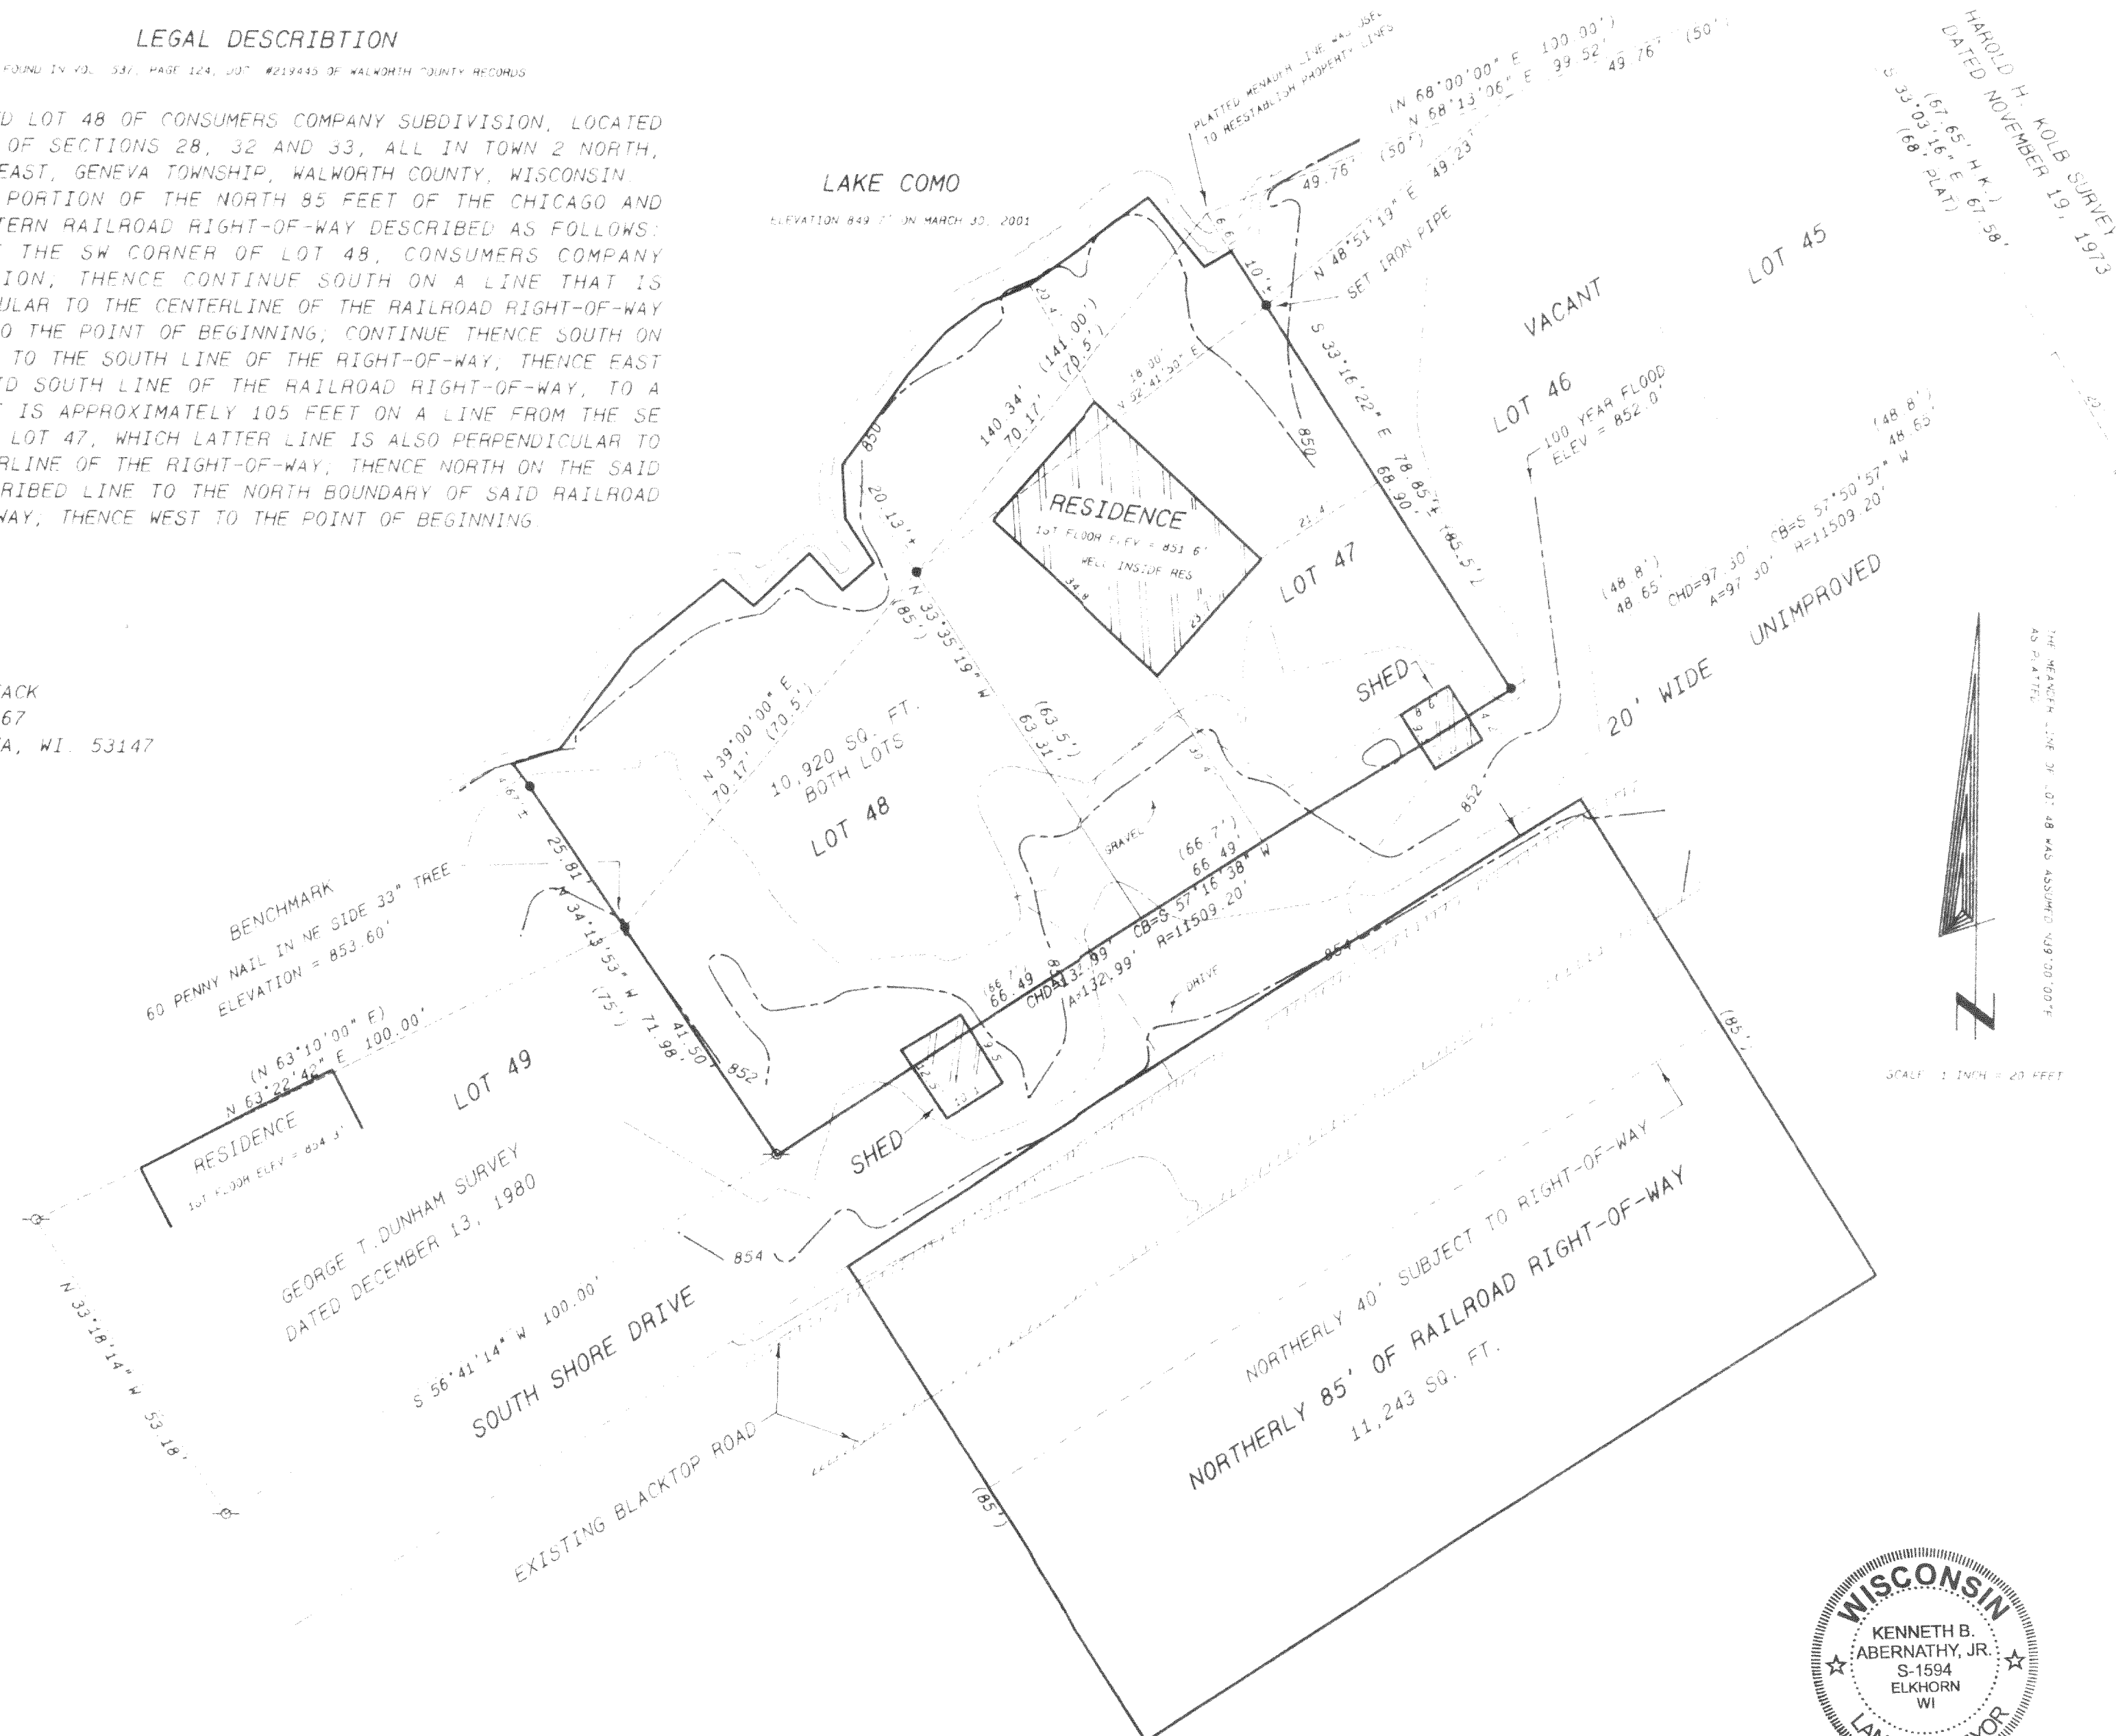


Legend

- FOUND IRON PIPE
● FOUND IRON ROD
● FOUND BRASS TAPPED MONUMENT
X FOUND CONCRETE MONUMENT
* CHISEL CUT IN CONCRETE
● SET IRON ROD (NO LONG WEIGHING
15 LBS LINEAL FT. DIA)
● SET IRON ROD (NO LONG WEIGHING
15 LBS LINEAL FT. DIA)
TAX RECORDED AS DIMENSION
EXISTING FENCE

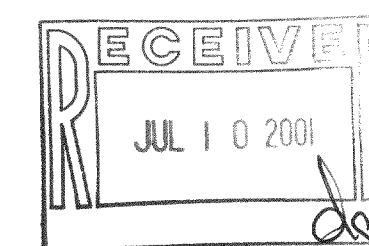

SCALE 1" = 20 FEET

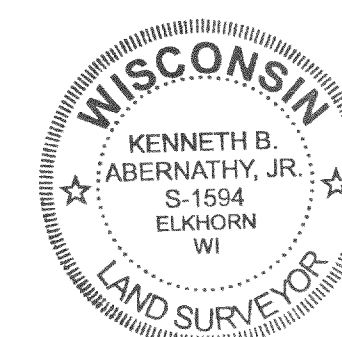

Kenneth B. Anthony

KENNETH B. ABERNATHY, JR.
WISCONSIN REGISTERED LAND SURVEYOR

Date JUNE 9 2001 Job No. 01.30

JCON-24
JCON-25

217-2128