

PROPERTY SURVEY


PREPARED FOR: **Fran & Laura Zappitelli**
Westridge Builders, Inc.

LOCATION: **W. 3211 Lake Forest Lane (Town of Geneva)**

DESCRIPTION OF PROPERTY

Lot 1 in LAKE FOREST ESTATES, a subdivision located in the NW, SW, and SE 1/4's of the SW 1/4 of Section 26, the SE and the NE 1/4's of the SE 1/4 of Section 27, and the NE 1/4 of the NW 1/4 of Section 35, all in Town 2 North, Range 17 East, Town of Geneva, Walworth County, Wisconsin.

(148,207 sq.ft.)

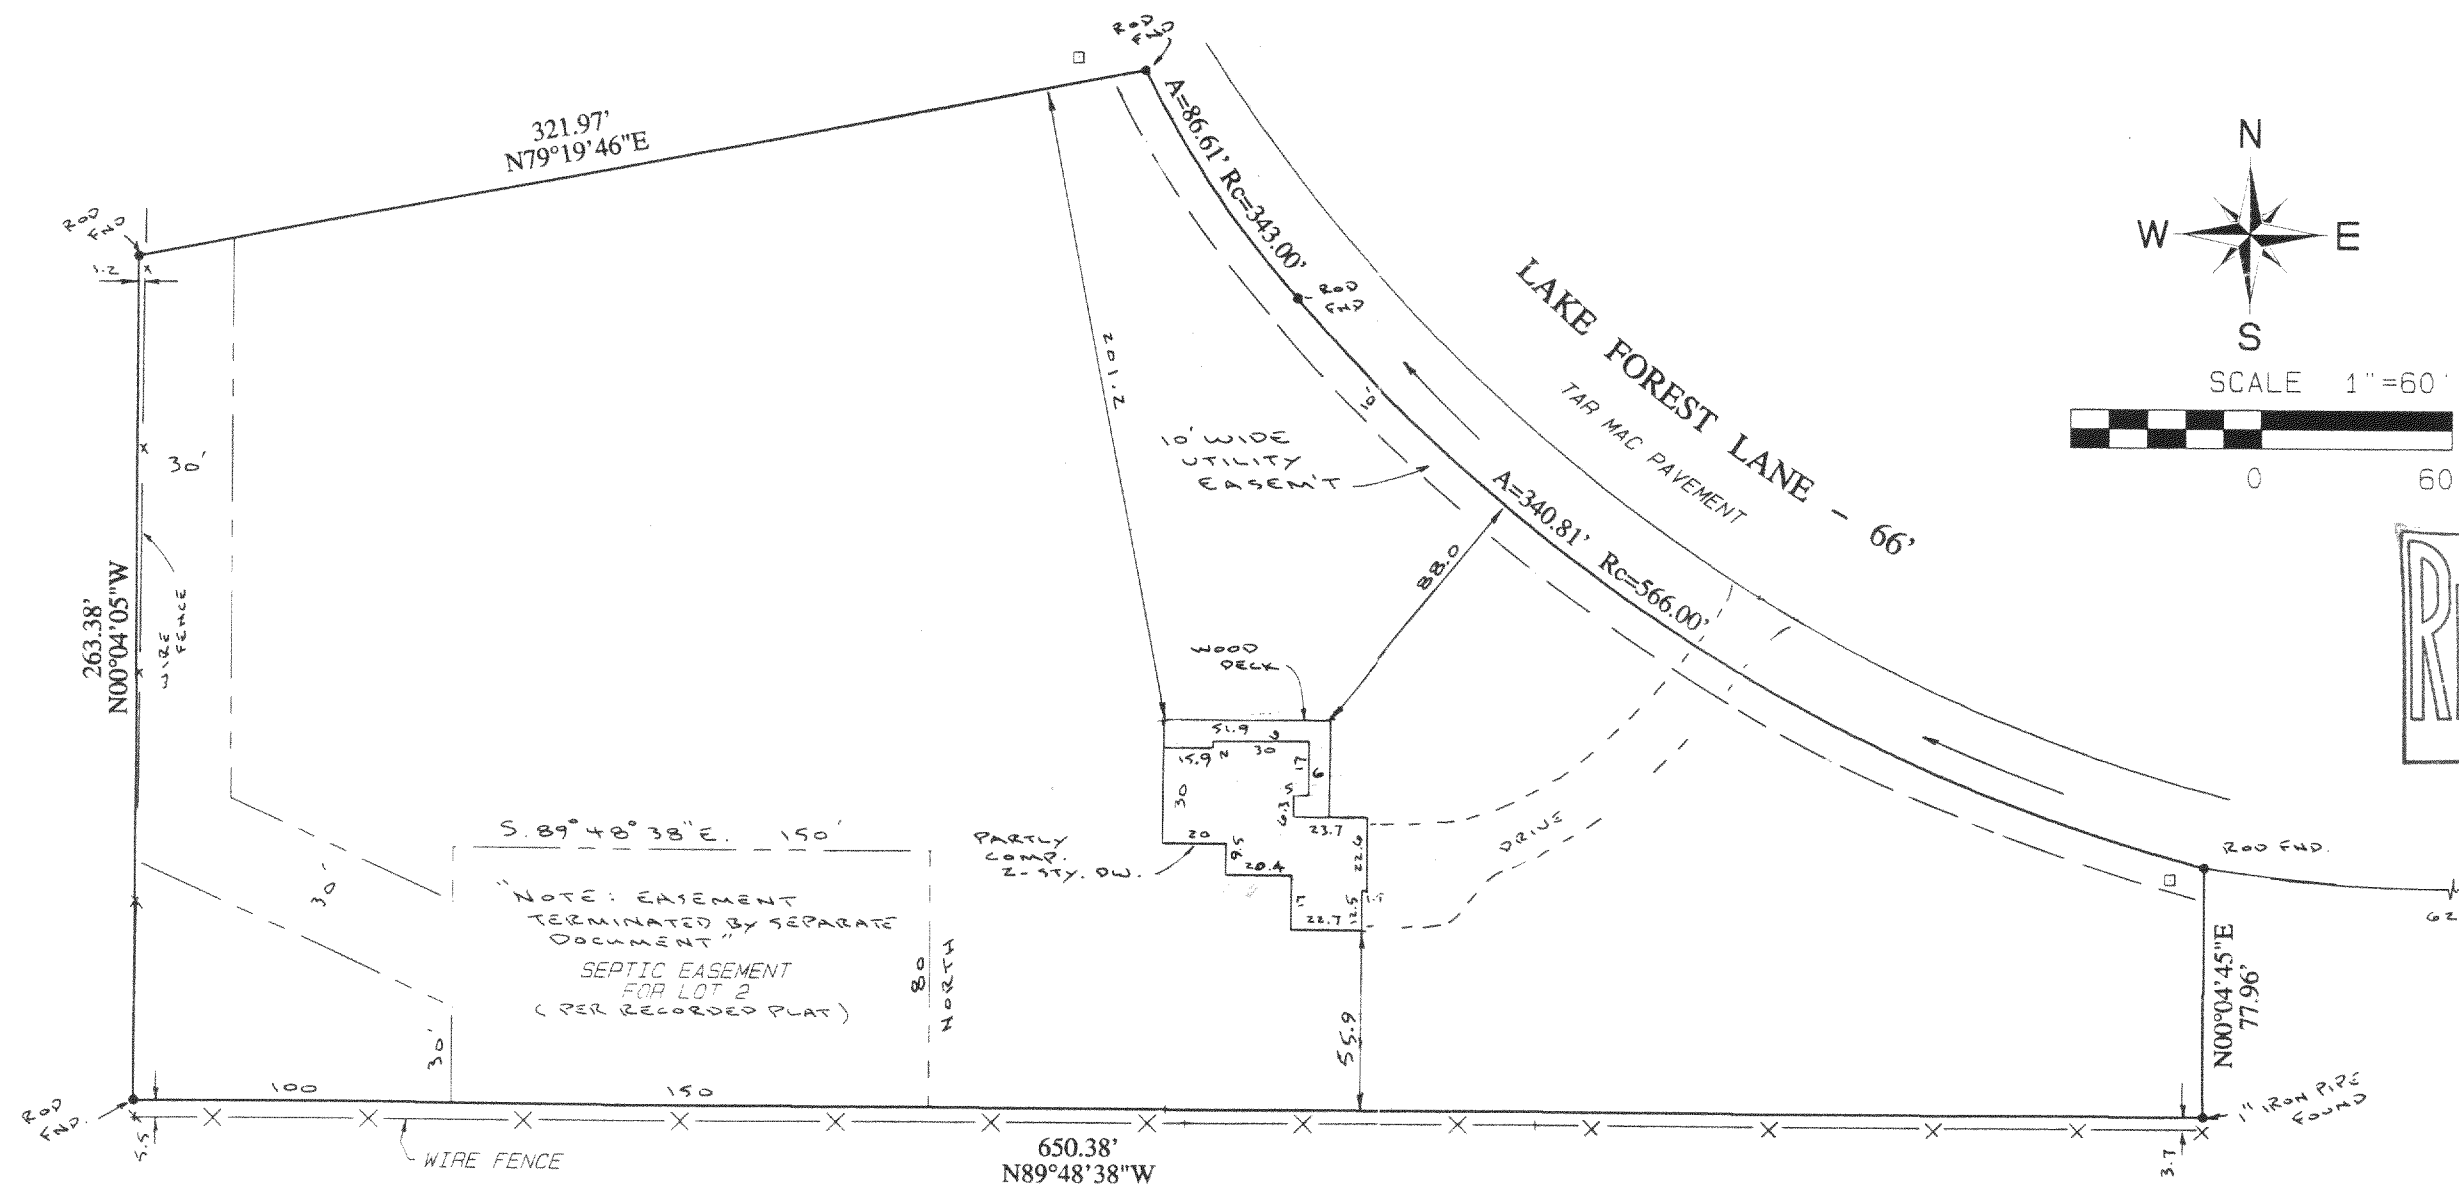

LAND SURVEYORS
KUOKKANEN & ASSOCIATES, INC.
910 ELM GROVE ROAD
ELM GROVE, WI 53122
PHONE: 262-782-8690
FAX: 262-782-1770



SURVEY CERTIFICATE
I have surveyed the above-described property and the above map is a true representation thereof and shows the size and location of the property, its exterior boundaries, the location and dimensions of all visible structures thereon, fences, apparent easements and roadways and visible encroachments, if any.
This survey is made for the exclusive use of the present owners of the property, and also those who purchase, mortgage, or guarantee the title thereto within one year from date hereof.
Date MAY 12, 2000
REV. 8-30-00
RECERTIFICATION 1-05-01
[Signature]
Kit Kuokkanen
Registered Land Surveyor
S-1177

00-696-438

JLFE-1

217-2140

PROPERTY SURVEY


PREPARED FOR: **Fran Zappitelli & Laura Wickersham /**
Westridge Builders, Inc.

LOCATION: **Lake Forest Lane (Town of Geneva)**

DESCRIPTION OF PROPERTY

Lot 1 in LAKE FOREST ESTATES, a subdivision located in the NW, SW, and SE 1/4's of the SW 1/4 of Section 26, the SE and the NE 1/4's of the SE 1/4 of Section 27, and the NE 1/4 of the NW 1/4 of Section 35, all in Town 2 North, Range 17 East, Town of Geneva, Walworth County, Wisconsin.

(148,207 sq.ft.)

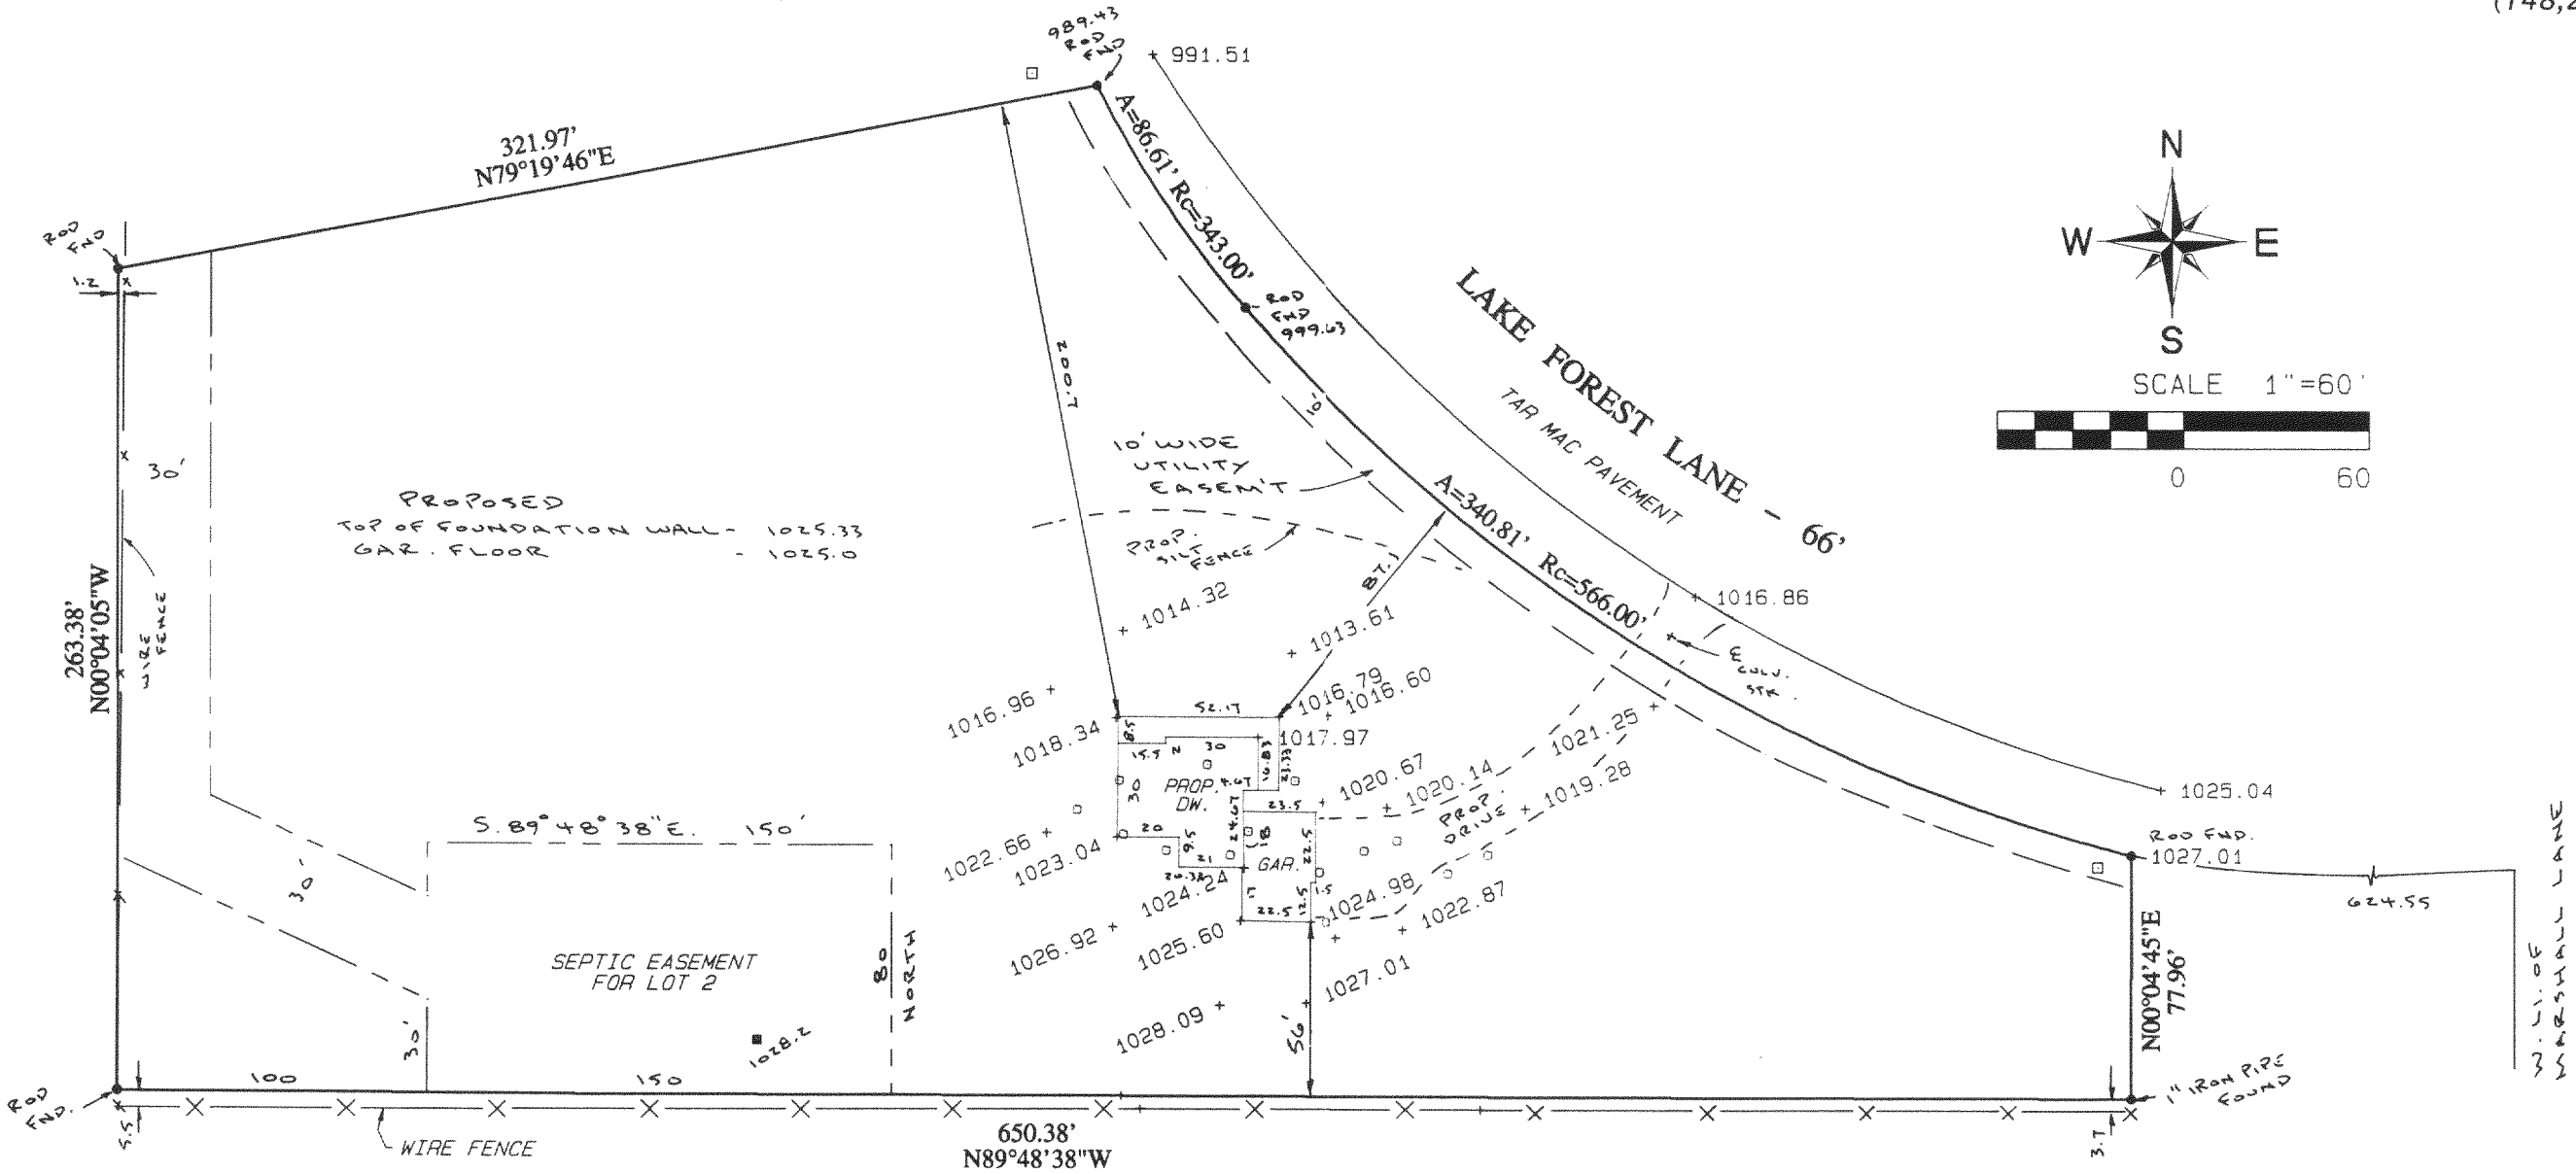

LAND SURVEYORS
KUOKKANEN & ASSOCIATES, INC.
910 ELM GROVE ROAD
ELM GROVE, WI 53122
PHONE: 262-782-8690
FAX: 262-782-1770



SURVEY CERTIFICATE
I have surveyed the above-described property and the above map is a true representation thereof and shows the size and location of the property, its exterior boundaries, the location and dimensions of all visible structures thereon, fences, apparent easements and roadways and visible encroachments, if any.
This survey is made for the exclusive use of the present owners of the property, and also those who purchase, mortgage, or guarantee the title thereto within one year from date hereof.
Date MAY 12, 2000
[Signature]
Kit Kuokkanen
Registered Land Surveyor
S-1177

00-696-438