



PLAT OF SURVEY

WORK ORDERED BY -
SCOTT LOWELL
LOWELL MANAGEMENT
P.O. BOX 926
LAKE GENEVA, WI. 53147

FARRIS, HANSEN & ASSOCIATES, INC.
ENGINEERING - ARCHITECTURE - SURVEYING
7 RIDGWAY COURT P.O. BOX 437
ELKHORN, WISCONSIN 53121
OFFICE: (262) 723-2098 FAX: (262) 723-5886

REVISIONS



PROJECT NO.
3269.19-02
DATE:
06/22/2001
SHEET NO.
1 OF 1

PLAT OF SURVEY
UNIT 19-02 OF GENEVA NATIONAL
CONDOMINIUM NO. 19

LOCATED IN TOWN 2, RANGE 17 EAST, WALWORTH COUNTY, WISCONSIN

LEGEND

- = FOUND IRON REBAR STAKE
- {xxx} = RECORDED AS

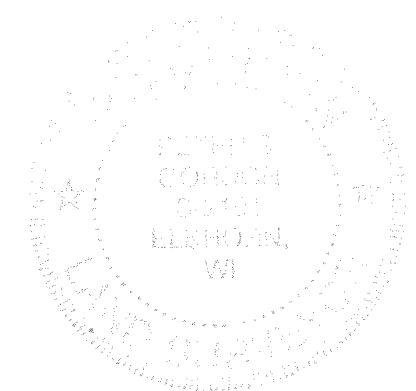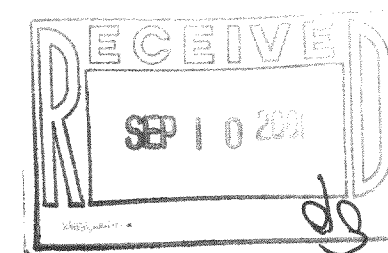

NOTE: COPIES OF THIS MAP TO WHICH THE FOLLOWING CERTIFICATE WILL APPLY SHOW THE SURVEYOR'S ORIGINAL SEAL AND SIGNATURE IN RED INK. COPIES BY ANY OTHER MEANS MAY HAVE ALTERATIONS WHICH DO NOT REPRESENT THE SURVEYOR'S WORK PRODUCT.

I HEREBY CERTIFY THAT THE ABOVE DESCRIBED PROPERTY HAS BEEN SURVEYED UNDER MY DIRECTION AND THAT THE ABOVE MAP IS A TRUE REPRESENTATION THEREOF AND SHOWS THE SIZE AND LOCATION OF THE PROPERTY AND ITS EXTERIOR BOUNDARIES. THIS SURVEY IS MADE FOR THE USE OF THE PRESENT OWNERS OF THE PROPERTY, AND ALSO THOSE WHO PURCHASE, MORTGAGE, OR GUARANTEE THE TITLE THERETO WITHIN ONE YEAR FROM THE DATE HEREOF.

DATED: 06/22/01

PETER S. GORDON R.L.S. 2101



BEARINGS PER CONDOMINIUM NO. 19 PLAT

CONDOMINIUM NO. 14

GOLF CLUB GROUNDS

WOODS

UNIT 19-03

UNIT 19-01

PRESTWICK DRIVE
66' WIDE R.O.W.

BENCH MARK
N. RIM MANHOLE
ELEV. = 1054.99'
{E. = 1042.4}

MAP SCALE IN FEET ORIGINAL 1" = 20'

JUN 22 2001

J6N-19-2 217-2154