


PLAT OF SURVEY

UNIT 03-16
GENEVA NATIONAL CONDOMINIUM
NO. 03
LOCATED IN TOWN 2 NORTH, RANGE 17 EAST
WALWORTH COUNTY, WISCONSIN

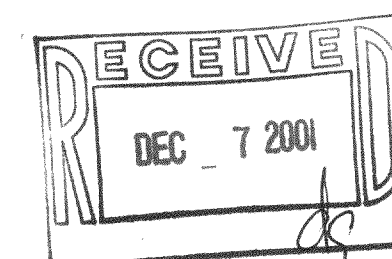


WORK ORDERED BY
COLDWELL BANKER PRIMUS
623 WEST MAIN STREET
LAKE GENEVA, WI. 53147

FARRIS, HANSEN & ASSOCIATES, INC.
Engineering, Architecture, Surveying
7 Ridgeway Court P.O. Box 437
ELKHORN, WISCONSIN 53121
Office: (414) 723-2098
Fax: (414) 723-5886

REVISIONS
11/15/01
CORRECT
SIDE YD

PROJECT NO.
3269.16-03
DATE:
11-10-01
SHEET NO.
1 OF 1

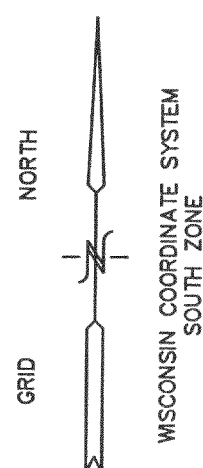

GOLF CLUB GROUNDS

UNIT 03-16
18,458 S.F.

UNIT 03-17

SARATOGA LANE
66' WIDE PRIVATE ROADWAY

BENCH MARK
CHIZ "X" RIM MANHOLE
EL. = 991.00'
IE = 977.20'


(E = 973.1)

NOTE: COPIES OF THIS MAP TO WHICH THE FOLLOWING CERTIFICATE WILL APPLY SHOW SURVEYOR'S ORIGINAL SEAL AND SIGNATURE IN RED INK. COPIES BY ANY OTHER MEANS MAY HAVE ALTERATIONS WHICH DO NOT REPRESENT THE SURVEYOR'S WORK PRODUCT.

I HEREBY CERTIFY THAT THE ABOVE DESCRIBED PROPERTY HAS BEEN SURVEYED UNDER MY DIRECTION AND THAT THE ABOVE MAP IS A TRUE REPRESENTATION THEREOF AND SHOWS THE SIZE AND LOCATION OF THE PROPERTY AND ITS EXTERIOR BOUNDARIES. THIS SURVEY IS MADE FOR THE USE OF THE PRESENT OWNERS OF THE PROPERTY, AND ALSO THOSE WHO PURCHASE, MORTGAGE, OR GUARANTEE THE TITLE THERETO WITHIN ONE YEAR FROM THE DATE HEREOF.

DATED: NOVEMBER 14, 2001

PETER S. GORDON R.L.S. 2101

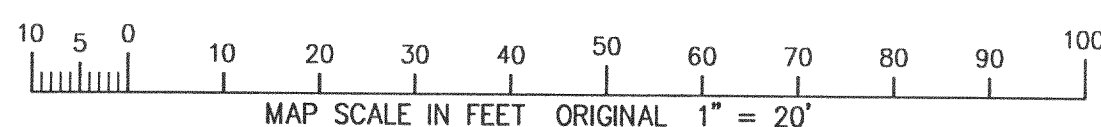

JGN 3-16 217-2202