

PLAT OF SURVEY



J.K. SURVEYING, INC.
FORMERLY KOLB LAND CONSULTING
N3705 WILLOW BEND LANE LAKE GENEVA, WI
(262) 248-3697

ORDERED BY: JOSEPH WULF
123 S. ROUTE 12
FOX LAKE, IL. 60020

DATE: 5/26/1998
DATE OF LAST REVISION: 1 / 02 / 2002

DESCRIPTION:

LOTS 3848 TO 3858, BOTH INCLUSIVE, BLOCK 66 IN LAKE COMO BEACH SUBDIVISION
GENEVA TOWNSHIP, WALWORTH COUNTY, WISCONSIN.

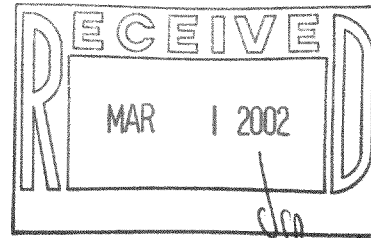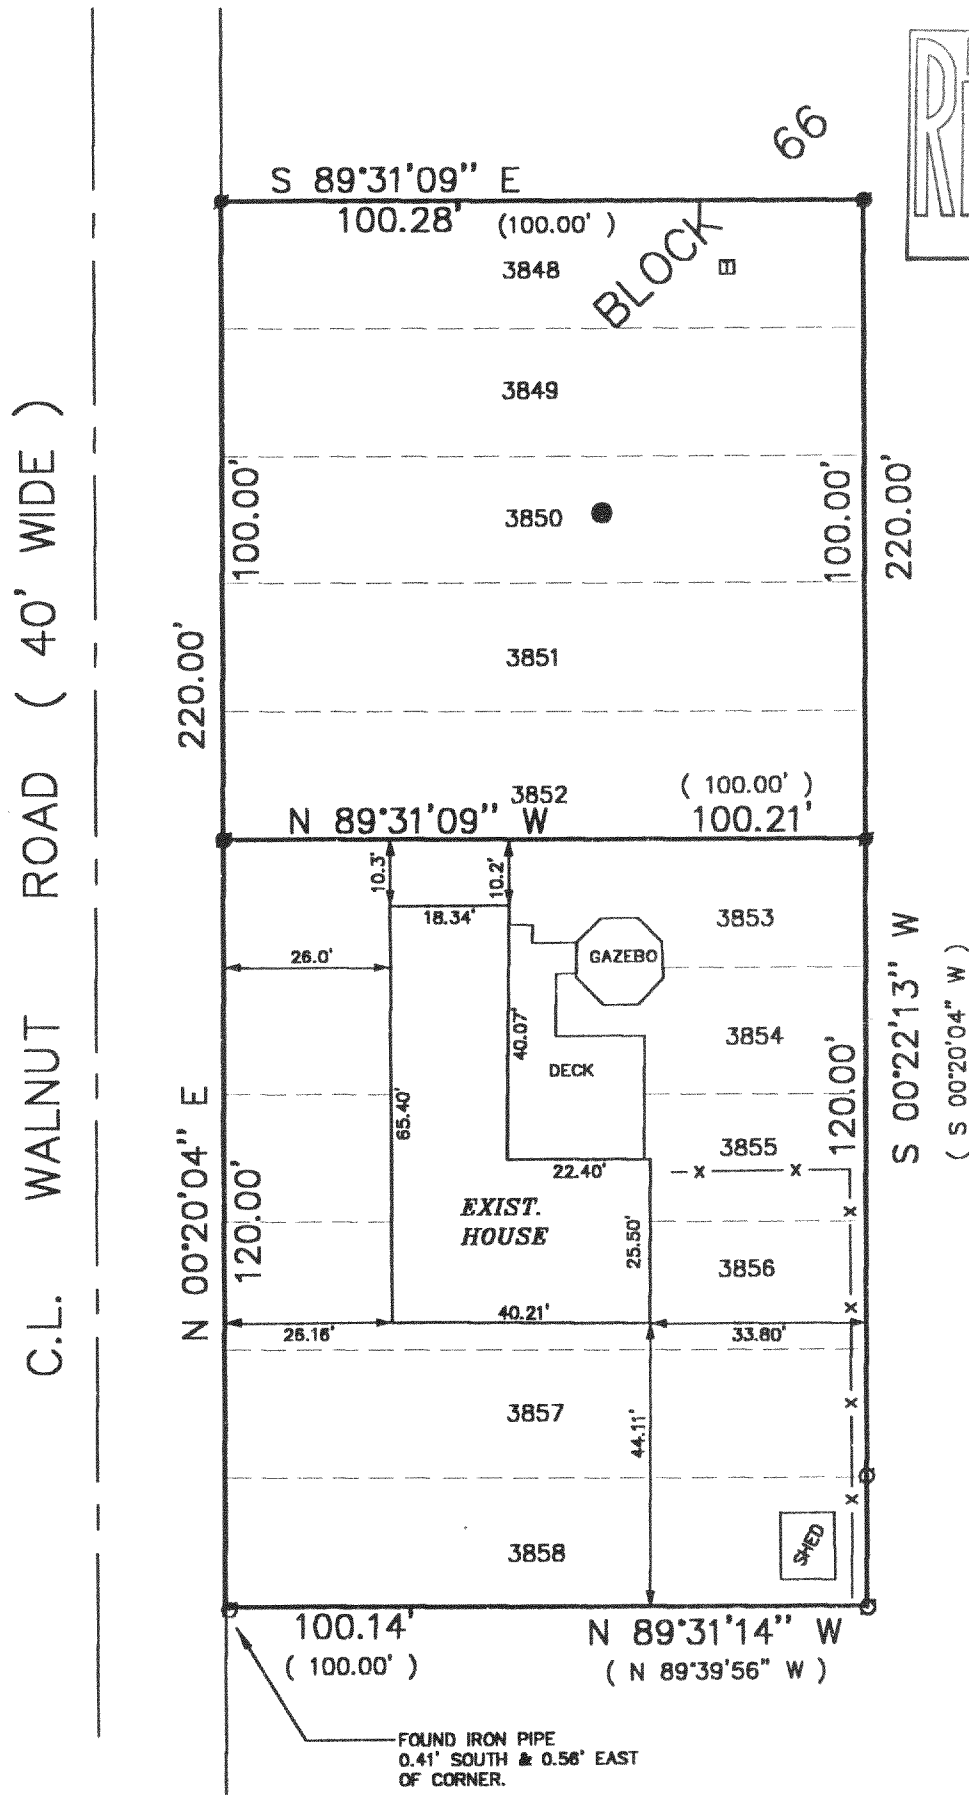

SCALE 1" = 30"


LEGEND

- FOUND IRON PIPE
- SET 1" DIA. IRON PIPE
- MANHOLE
- ▣ TELEPHONE PEDISTAL
- WELL
- (XXXX) RECORDED AS

THE ABOVE MAP IS A TRUE REPRESENTATION THEREOF AND
SHOWS THE SIZE AND LOCATION OF ALL THE PROPERTY,
EXTERIOR BOUNDARIES, THE LOCATION OF ALL VISIBLE
BOUNDARY FENCES, APPARENT EASEMENTS, ROADWAYS
AND VISIBLE ENCROACHMENTS, IF ANY

THIS SURVEY IS MADE FOR THE USE OF THE PRESENT
OWNERS OF THE PROPERTY, AND ALSO THOSE WHO
PURCHASE, MORTGAGE OR GUARANTEE TITLE THERETO
WITHIN ONE (1) YEAR FROM DATE HERETO.

JOHN P. KROTT, R.L.S. 2258

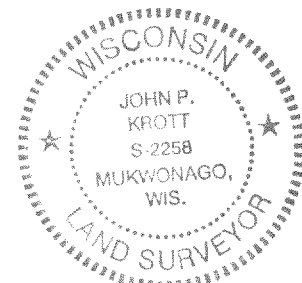

NOTE: THIS IS NOT A CERTIFIED COPY
UNLESS SEAL IS IN RED.
JOB NUMBER 98085 2-17-JLCB-00734

JLCB-734
217-2228