

JOE SAVAGE  
N3233 POPLAR RD.  
LAKE GENEVA WI. 53147

PLAT OF SURVEY



J.K. SURVEYING INC.  
N3705 WILLOWBEND LANE  
LAKE GENEVA, WI, 53147  
262-248-3697

- OF -

PARCEL "A" LOTS 10723 THRU 10727 ALL INCLUSIVE BLOCK 194 LAKE COMO BEACH A SUBDIVISION LOCATED IN T.2.N., R.17.E. WALWORTH COUNTY, WISCONSIN.

PARCEL "B" LOTS 10718 THRU 10722 ALL INCLUSIVE BLOCK 194 LAKE COMO BEACH A SUBDIVISION LOCATED IN T.2.N., R.17.E. WALWORTH COUNTY, WISCONSIN.

NOTE : THIS IS A PARCEL SPLIT

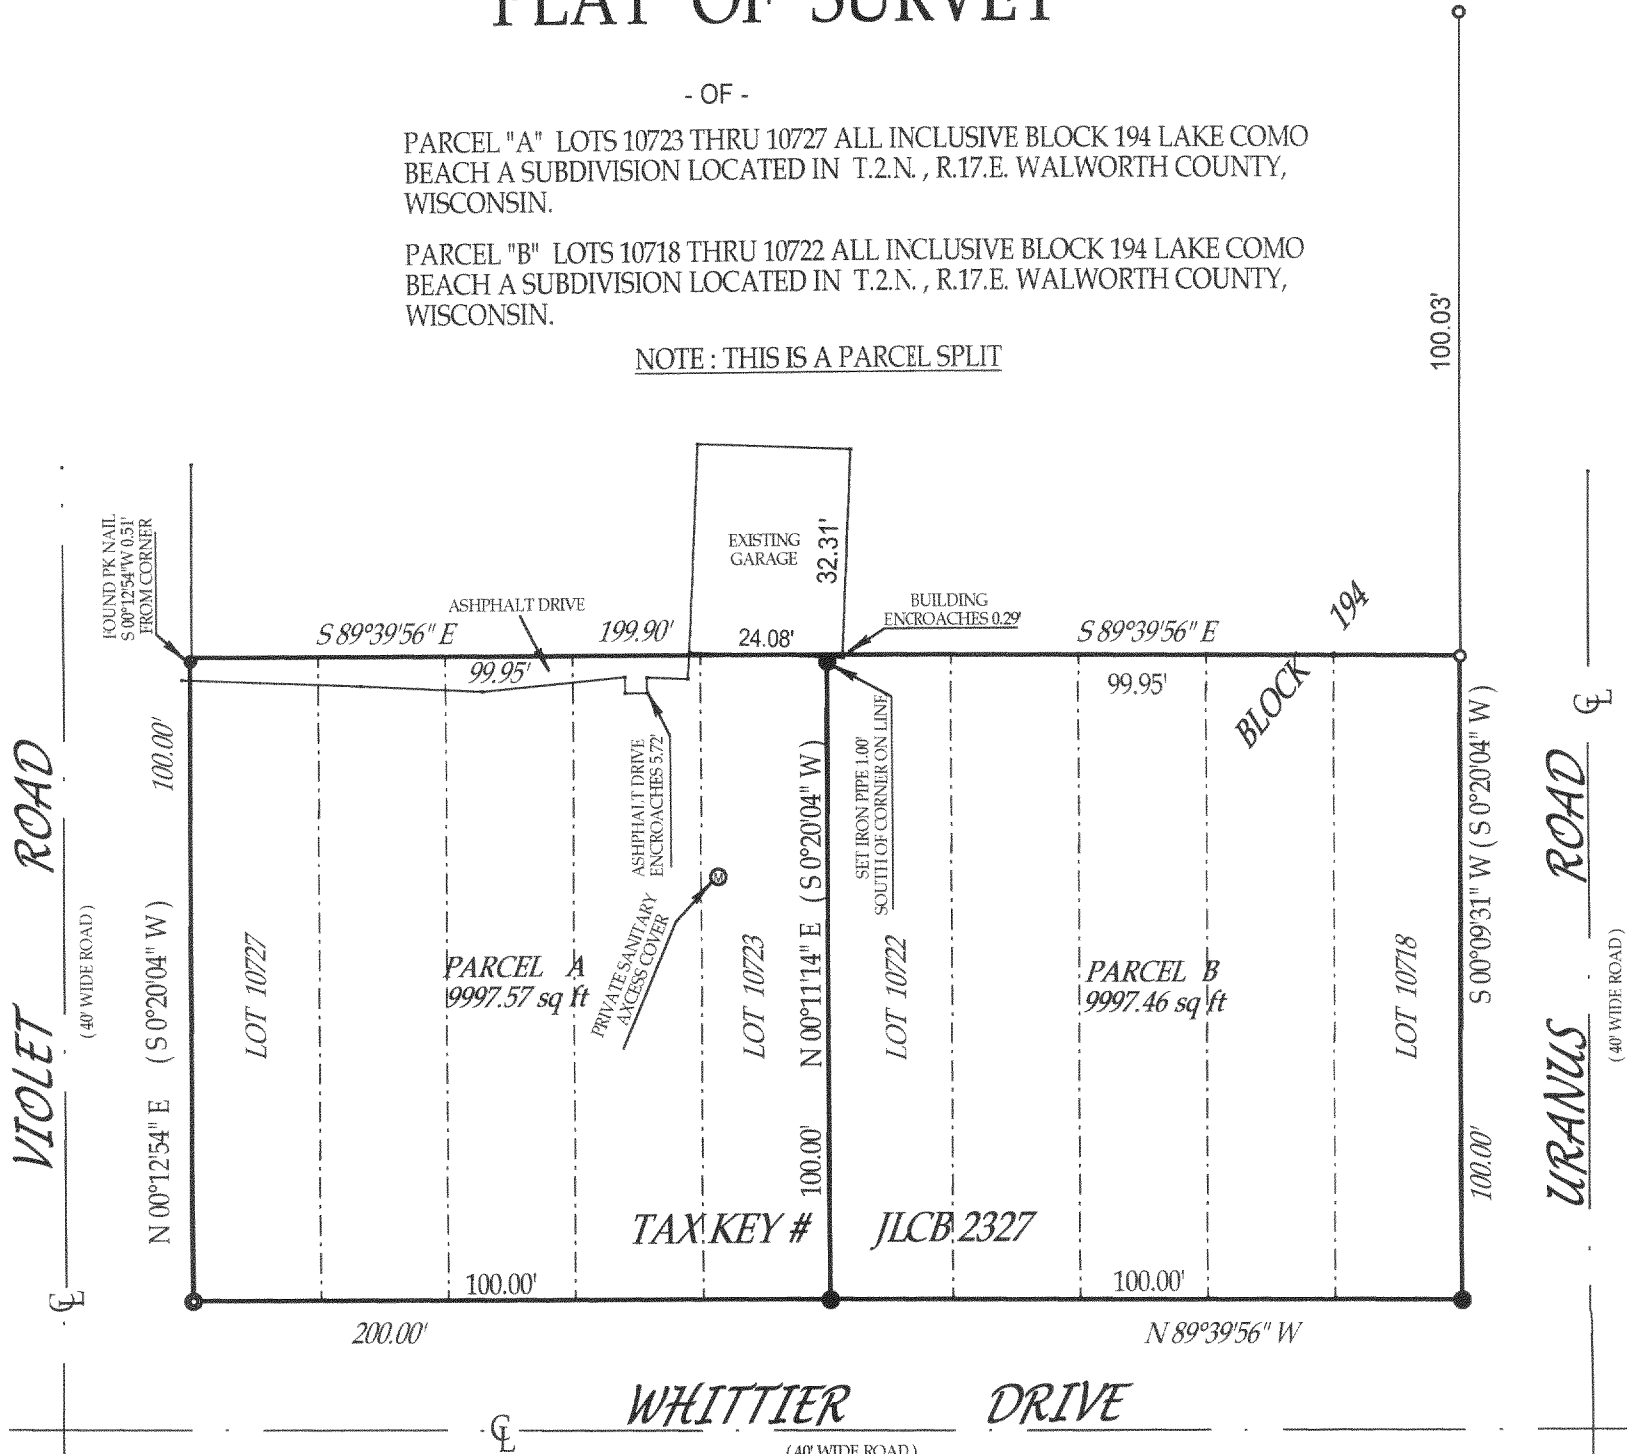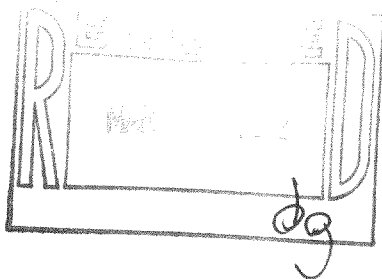

- ( ) = recorded as
- = found iron bar
- = found iron pipe
- = set iron pipe
- = set iron bar


SCALE 1" = 30'

JOB # 01-539

TAX ID # JLCB 2327

COMPARE LEGAL DESCRIPTION ABOVE AND DRAWING WITH DEED. FOR BUILDING RESTRICTIONS AND EASEMENTS NOT SHOWN, REFER TO DEED. ABSTRACT SOURCES AND LOCAL MUNICIPAL CODES. NOTIFY THE SURVEYOR IMMEDIATELY OF ANY DISCREPANCY.

"I hereby certify that I have surveyed the above described property and that the above map is a true representation thereof and shows the size and location of all visible structures, apparent easements and encroachments if any."  
This survey is made for the present owners of the property, and those who purchase, mortgage, or guarantee the title thereto, within one year from the date hereof.  
DATED THIS THE 28th OF FEBRUARY 2002

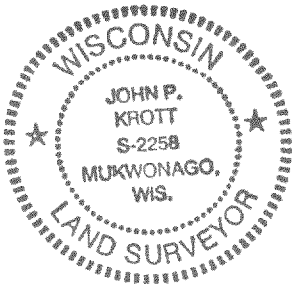

*John P. Krott*  
JOHN KROTT S - 2258  
Wisconsin Registered Land Surveyor  
( original if signed in red )

JLCB-2327 217-2243