



MAR 05 2002

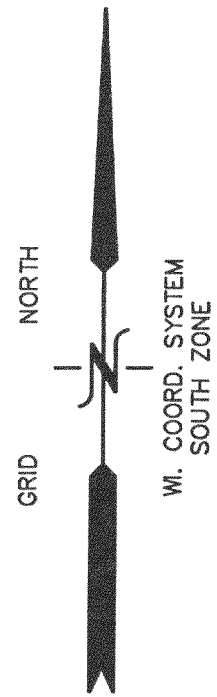

PLAT OF SURVEY
UNIT 23-03
GENEVA NATIONAL CONDOMINIUM NO. 23

LOCATED IN TOWN 2 NORTH, RANGE 17 EAST, WALWORTH COUNTY, WISCONSIN

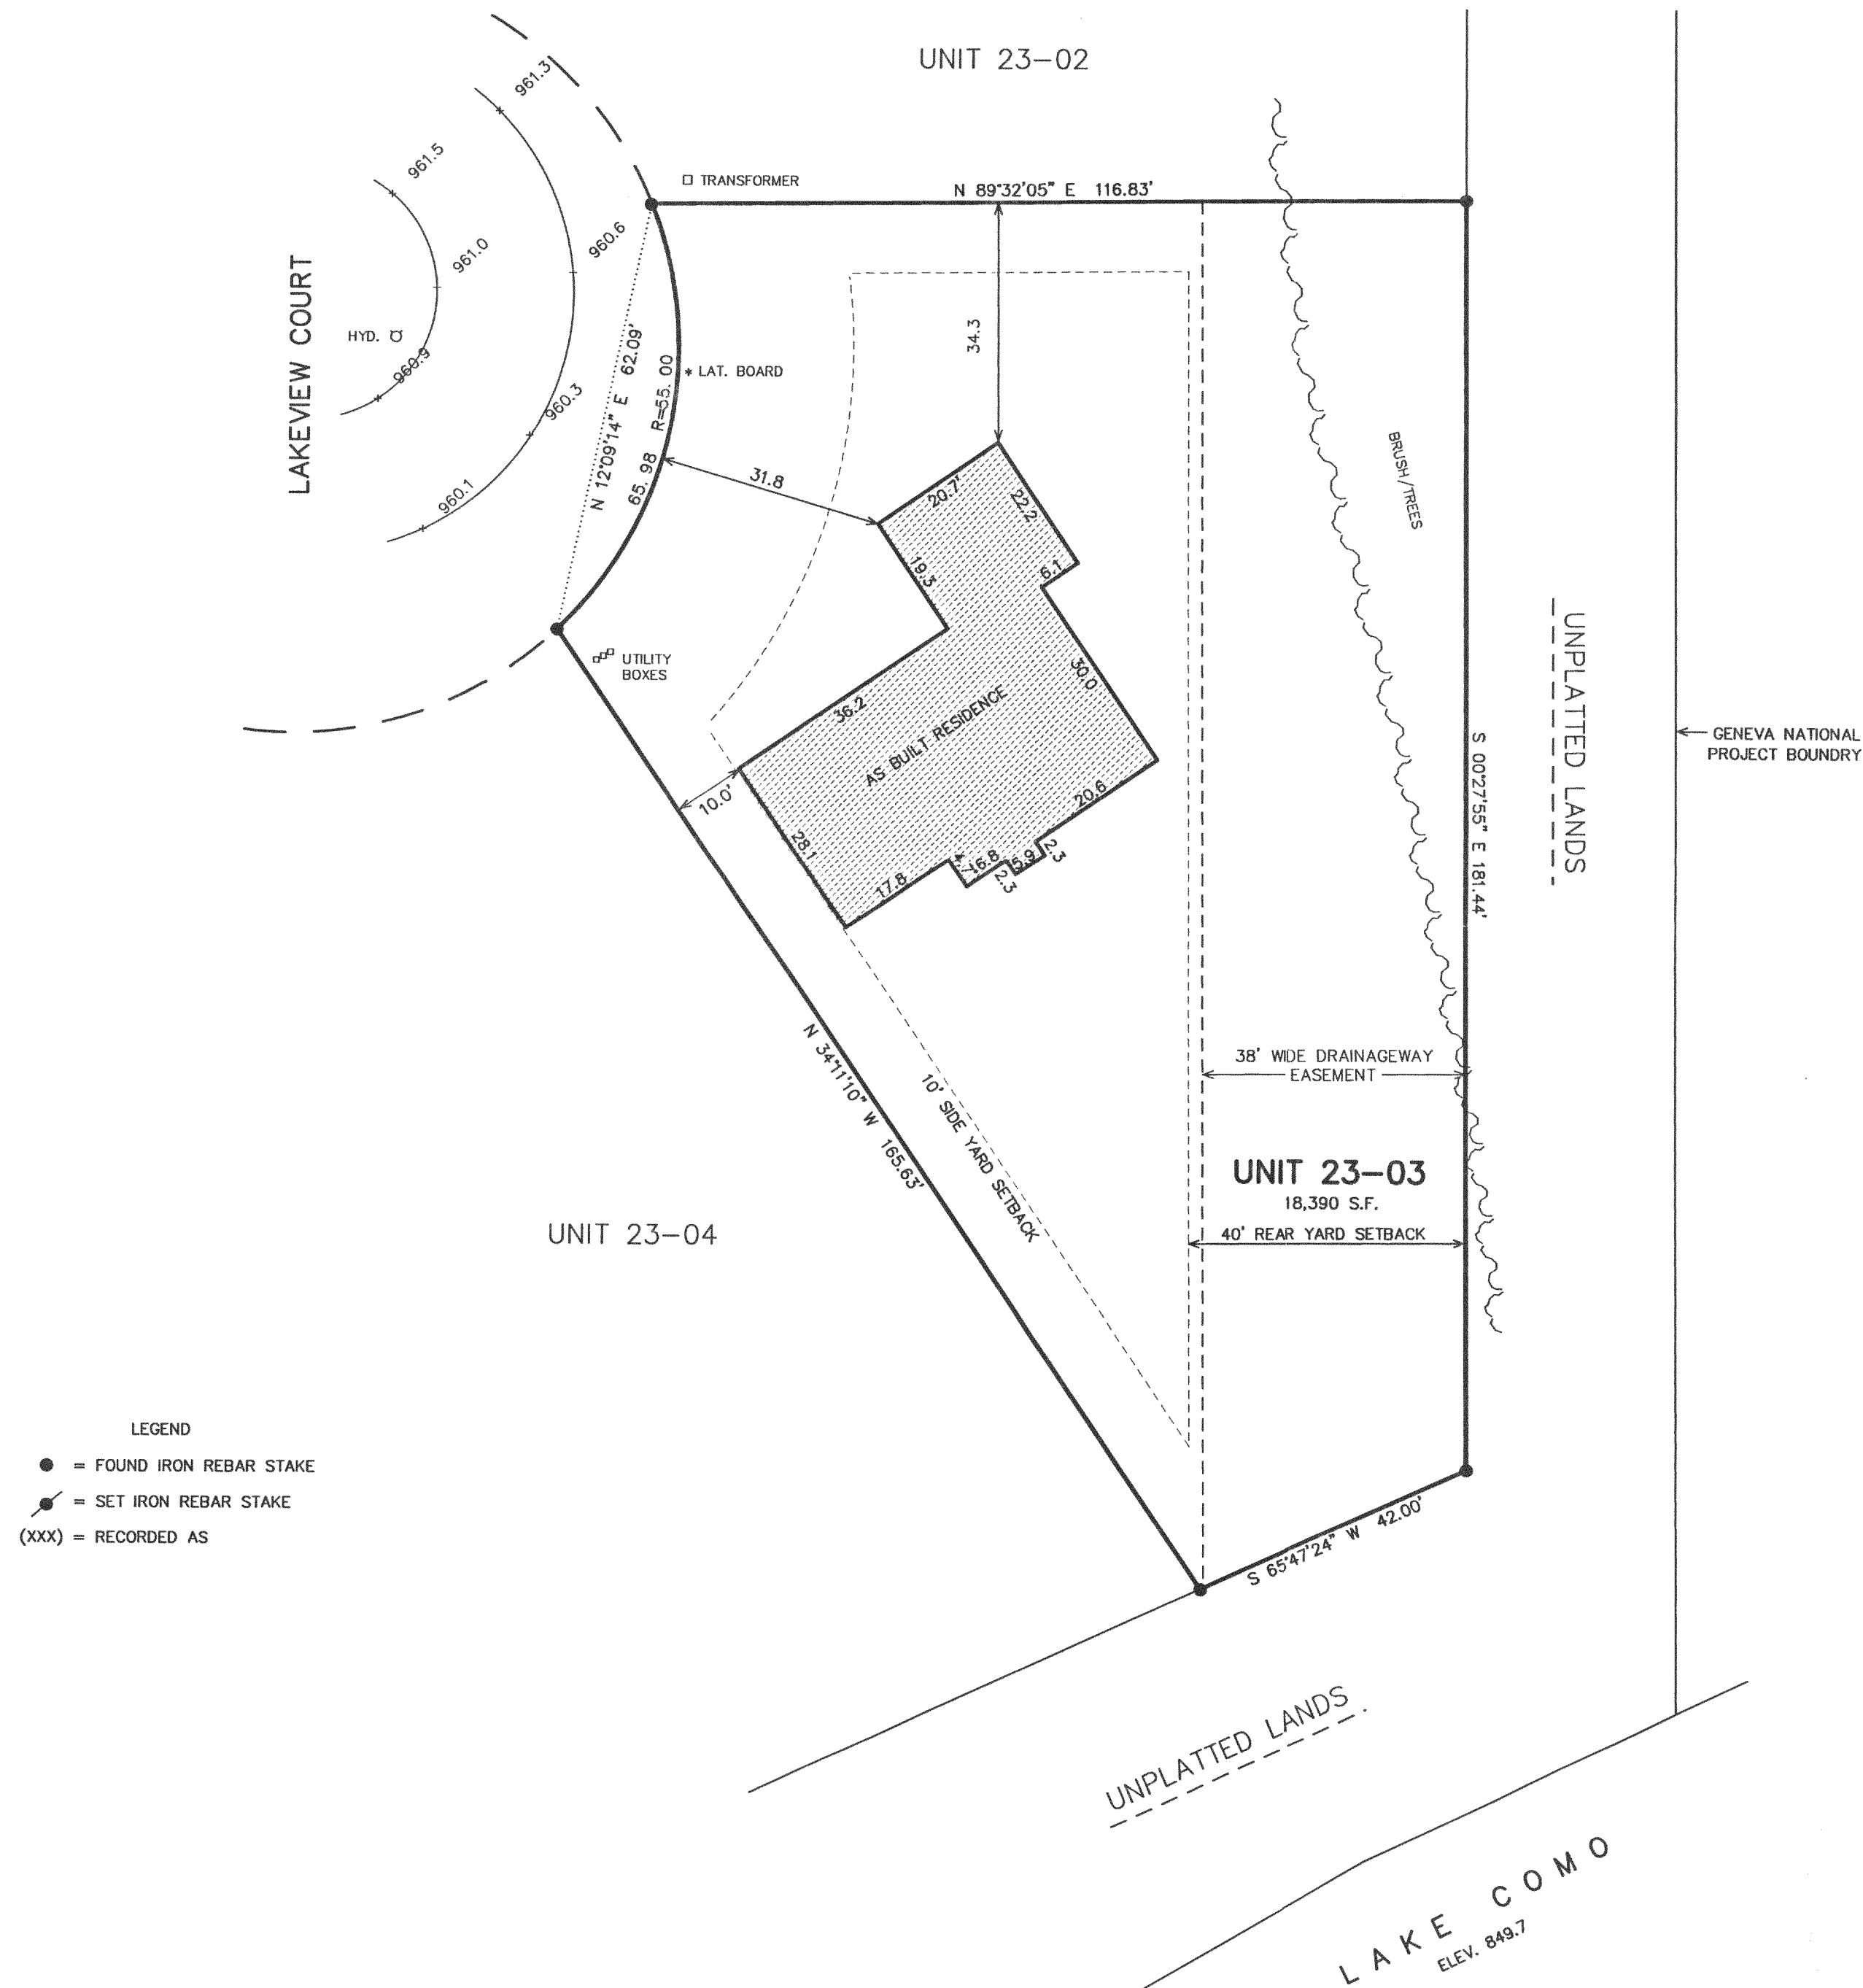

- WORK ORDERED BY - BILL DALLMANN ANVAN CONSTRUCTION COMPANY 1901 S. MEYERS ROAD, SUITE 220 OAKBROOK TERRACE, IL 60181	
FARRIS, HANSEN & ASSOCIATES, INC. ENGINEERING - ARCHITECTURE - SURVEYING 7 RIDGWAY COURT P.O. BOX 437 ELKHORN, WISCONSIN 53121 OFFICE: (262) 723-2098 FAX: (262) 723-5886	
REVISIONS 2/12/01 - SURVEY/TOPO CONNECTED TO SITE PLAN 5/24/01 - EASEMENT ADJUSTMENTS 7/19/2001 - REVISED LAYOUT	
PROJECT NO. 3269.23-03	DATE: 02/08/2001
SHEET NO. 1 OF 1	

NOTE: COPIES OF THIS MAP TO WHICH THE FOLLOWING CERTIFICATE WILL APPLY SHOW SURVEYOR'S ORIGINAL SEAL AND SIGNATURE IN RED INK. COPIES BY ANY OTHER MEANS MAY HAVE ALTERATIONS WHICH DO NOT REPRESENT THE SURVEYOR'S WORK PRODUCT.

I HEREBY CERTIFY THAT THE ABOVE DESCRIBED PROPERTY HAS BEEN SURVEYED UNDER MY DIRECTION AND THAT THE ABOVE MAP IS A TRUE REPRESENTATION THEREOF AND SHOWS THE SIZE AND LOCATION OF THE PROPERTY AND ITS EXTERIOR BOUNDARIES. THIS SURVEY IS MADE FOR THE USE OF THE PRESENT OWNERS OF THE PROPERTY, AND ALSO THOSE WHO PURCHASE, MORTGAGE, OR GUARANTEE THE TITLE THERETO WITHIN ONE YEAR FROM THE DATE HEREOF.

REVISD 03-06-2002
TO SHOW SIZE &
LOCATION OF AS BUILT
RESIDENCE

DATED: 2-12-2001

PETER S. GORDON R.L.S. 2101

217-2252 JGN 23-03