

ABERNATHY and ASSOCIATES

Kenneth B. Abernathy Jr.

Wisconsin Registered Land Surveyor S-1594

Rt. 3, Box 273  
Elkhorn, Wisconsin 53121  
Phone: (414) 723-4260 (office)  
(414) 723-7209 (FAX)


PLAT OF SURVEY

LOTS 1884 - 1888 INCLUSIVE  
AND 1908 AND 1909 OF BLOCK  
31 OF THE 3RD MAP OF LAKE  
COMO BEACH SUBDIVISION,  
LOCATED IN THE TOWN 2  
NORTH, RANGE 17 EAST, TOWN  
OF GENEVA, WALWORTH  
COUNTY, WISCONSIN.

OWNER: DARRYL VINCENTI JR.  
N3418 QUEENS RD.  
LAKE GENEVA, WI. 53147

LEGAL DESCRIPTION REFERENCE: WARRANTY DEED  
FROM LAKE GENEVA ENTERTAINMENT, INC. TO  
DARRYL VINCENTI JR. DATED 9/11/93 VOL. 630  
P. 7001 DOC. NO. 287290.



QUEEN ROAD 40' WIDE

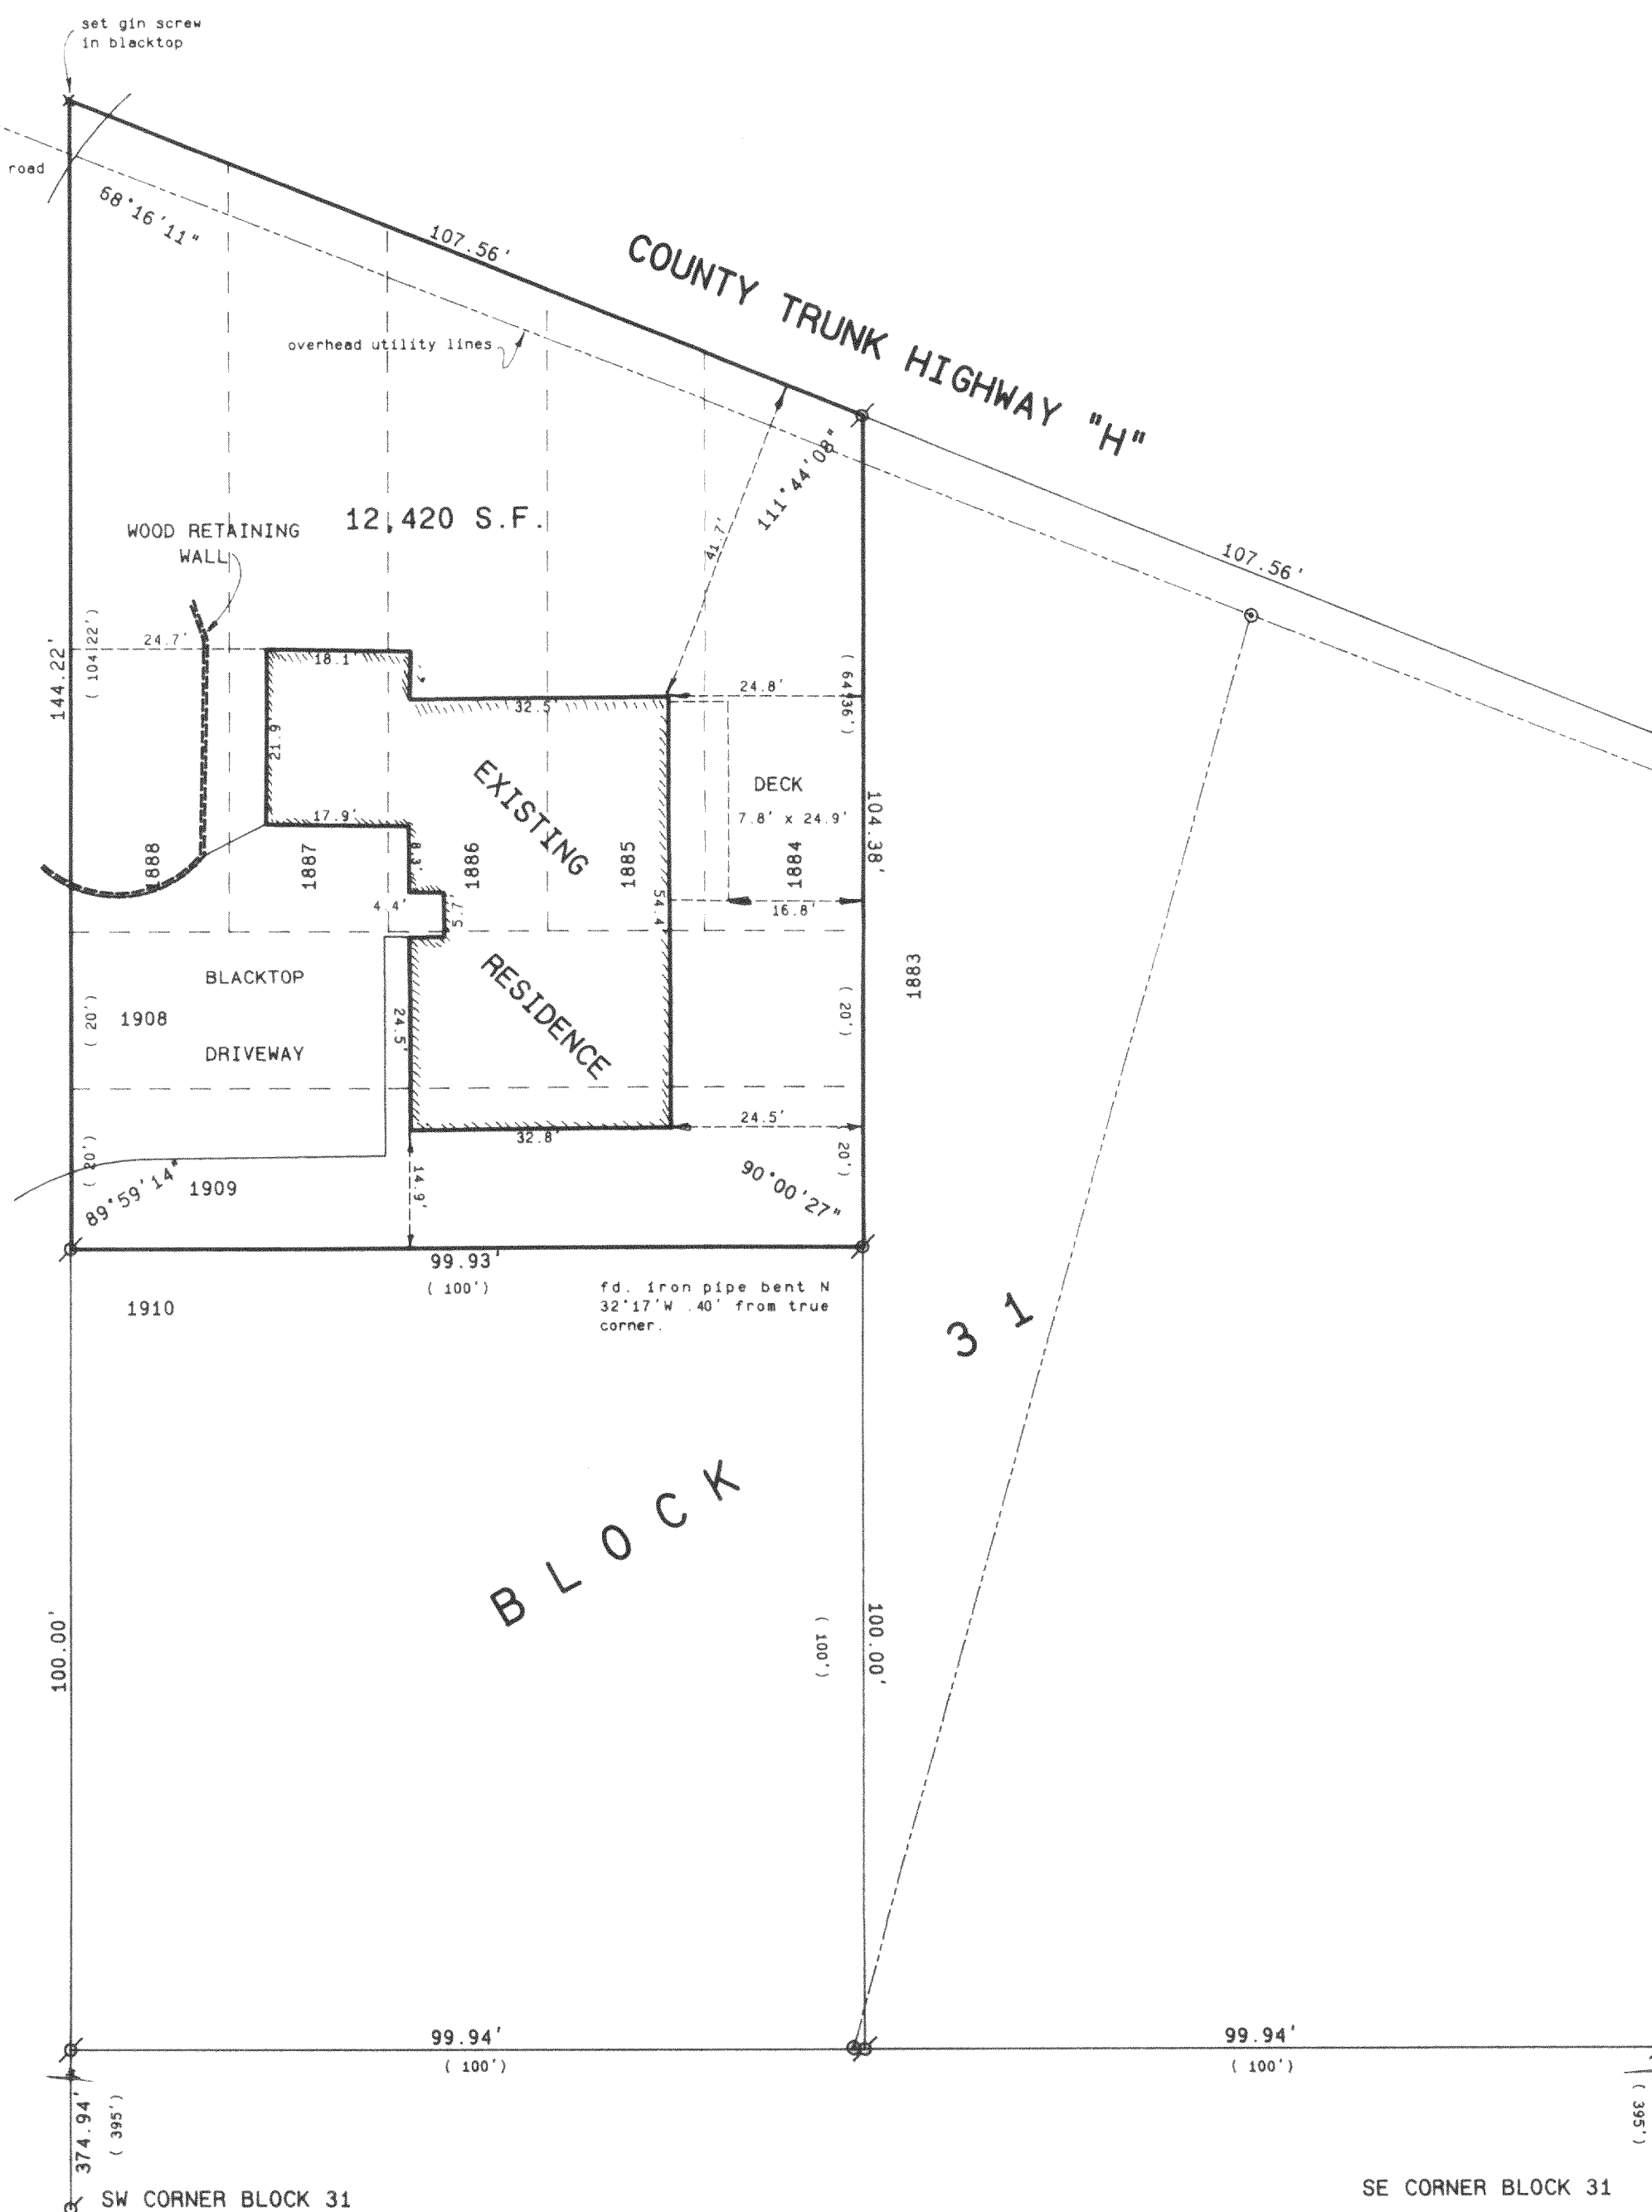

SCALE 1" = 20 FEET

Legend

- FOUND IRON PIPE
- FOUND IRON ROD
- FOUND BRASS CAPPED MONUMENT
- FOUND CONCRETE MONUMENT
- CHISEL CUT IN CONCRETE
- SET IRON ROD, 24" LONG, WEIGHING 1.5 LBS./LINEAL FT., 3/4" DIA.
- SET IRON ROD, 30" LONG, WEIGHING 4.5 LBS./LINEAL FT., 1-11/16" DIA.
- RECORDED AS DIMENSION
- EXISTING FENCE

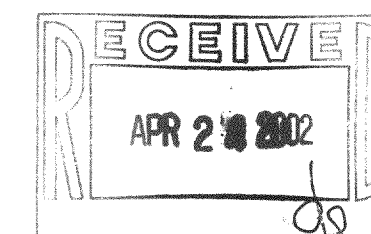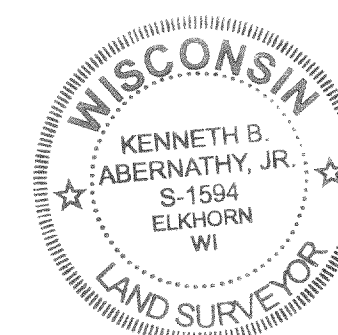

SCALE: 1" = 20 FEET

"I hereby certify that the above described property has been surveyed by me or under my direction and that the above map is a true representation thereof and shows the size and location of the property, its exterior boundaries, the location of all visible structures and dimensions of all principal buildings thereon, boundary fences, apparent easements, roadways and visible encroachments, if any."

"This survey is made for the use of the present owners of the property, and also those who purchase, mortgage, or guarantee the title thereto within one year from date hereof."

Kenneth B. Abernathy, Jr.  
KENNETH B. ABERNATHY, JR.  
WISCONSIN REGISTERED LAND SURVEYOR,  
S-1594  
Date: 4-24-95 Job No. 95420

JLCB-308A 217-2262