


HAROLD H. KOLB

REGISTERED PROFESSIONAL LAND SURVEYOR
LAKE GENEVA, WISCONSIN

Washington Dr.

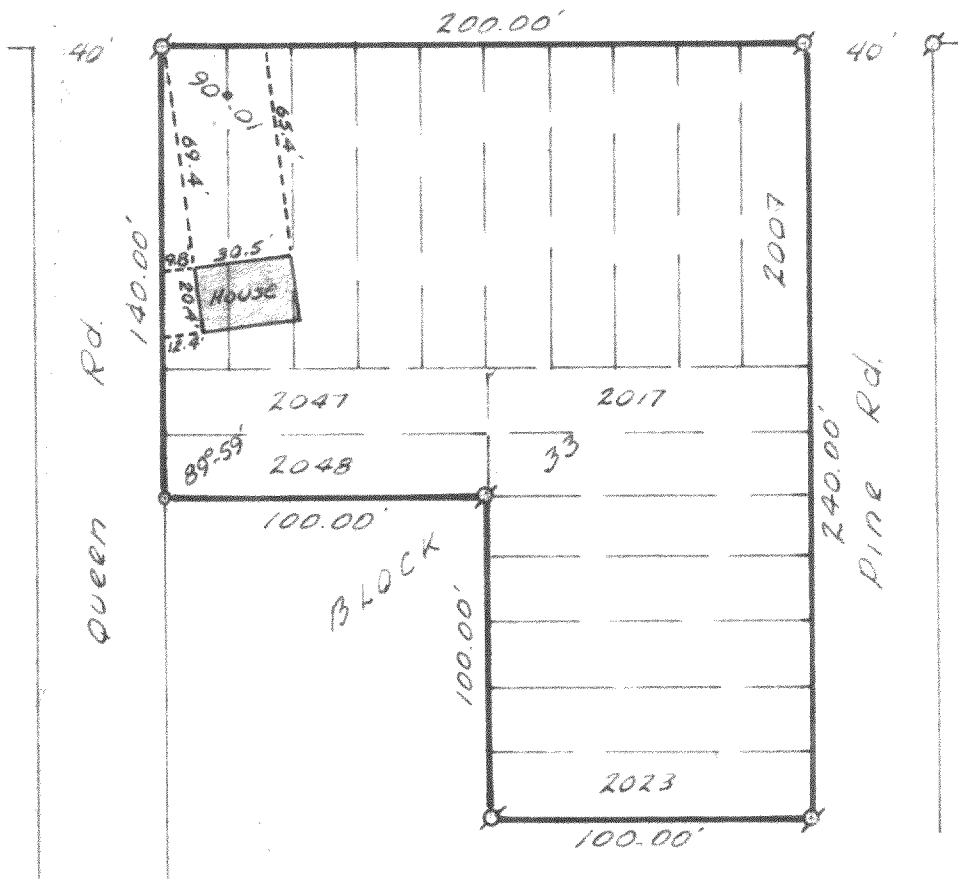

N

LEGEND

- Ø — IRON PIPE FOUND
- — IRON ROD PLACED
- — CONCRETE MONUMENT
- X — SPIKE

SCALE - 1" = 60'



PLAT OF SURVEY OF
Lots 2007 thru 2023 and Lots 2047 and
2048, Block 33, Lake Como Beach Subd.,
T 2 N, R 17 E, Walworth County, Wisconsin

I, HAROLD H. KOLB, DO HEREBY CERTIFY THAT I HAVE
SURVEYED THE PROPERTY HEREON DESCRIBED ACCORDING
TO THE OFFICIAL RECORDS, AND THAT THE PLAT HEREON
IS A CORRECT REPRESENTATION OF THE LOT LINES, and the
principle lines of the buildings thereon.

Harold H. Kolb

HAROLD H. KOLB

WISCONSIN REGISTERED LAND SURVEYOR, S-187

DATE JUNE 6, 1969

JLCLB-335 34

217-227

217-94