

4461

PLAT OF SURVEY

LOTS 5659 THRU 5665

BLOCK 101

LAKE COMO BEACH

A SUBDIVISION

SEC. 28, T. 2., R. 17 E.

WALWORTH COUNTY, WI.

SE CORNER BLOCK 101



ASSIGNED WEST LINE FERN ROAD


S 00° 58' 53" E

FERN ROAD

40' WIDE ROW

FOUND IRON PIPE
STAKE N 66° 40'
E 0.70' FROM
RECORD CORNER

S 00° 58' 53" E 140.00'

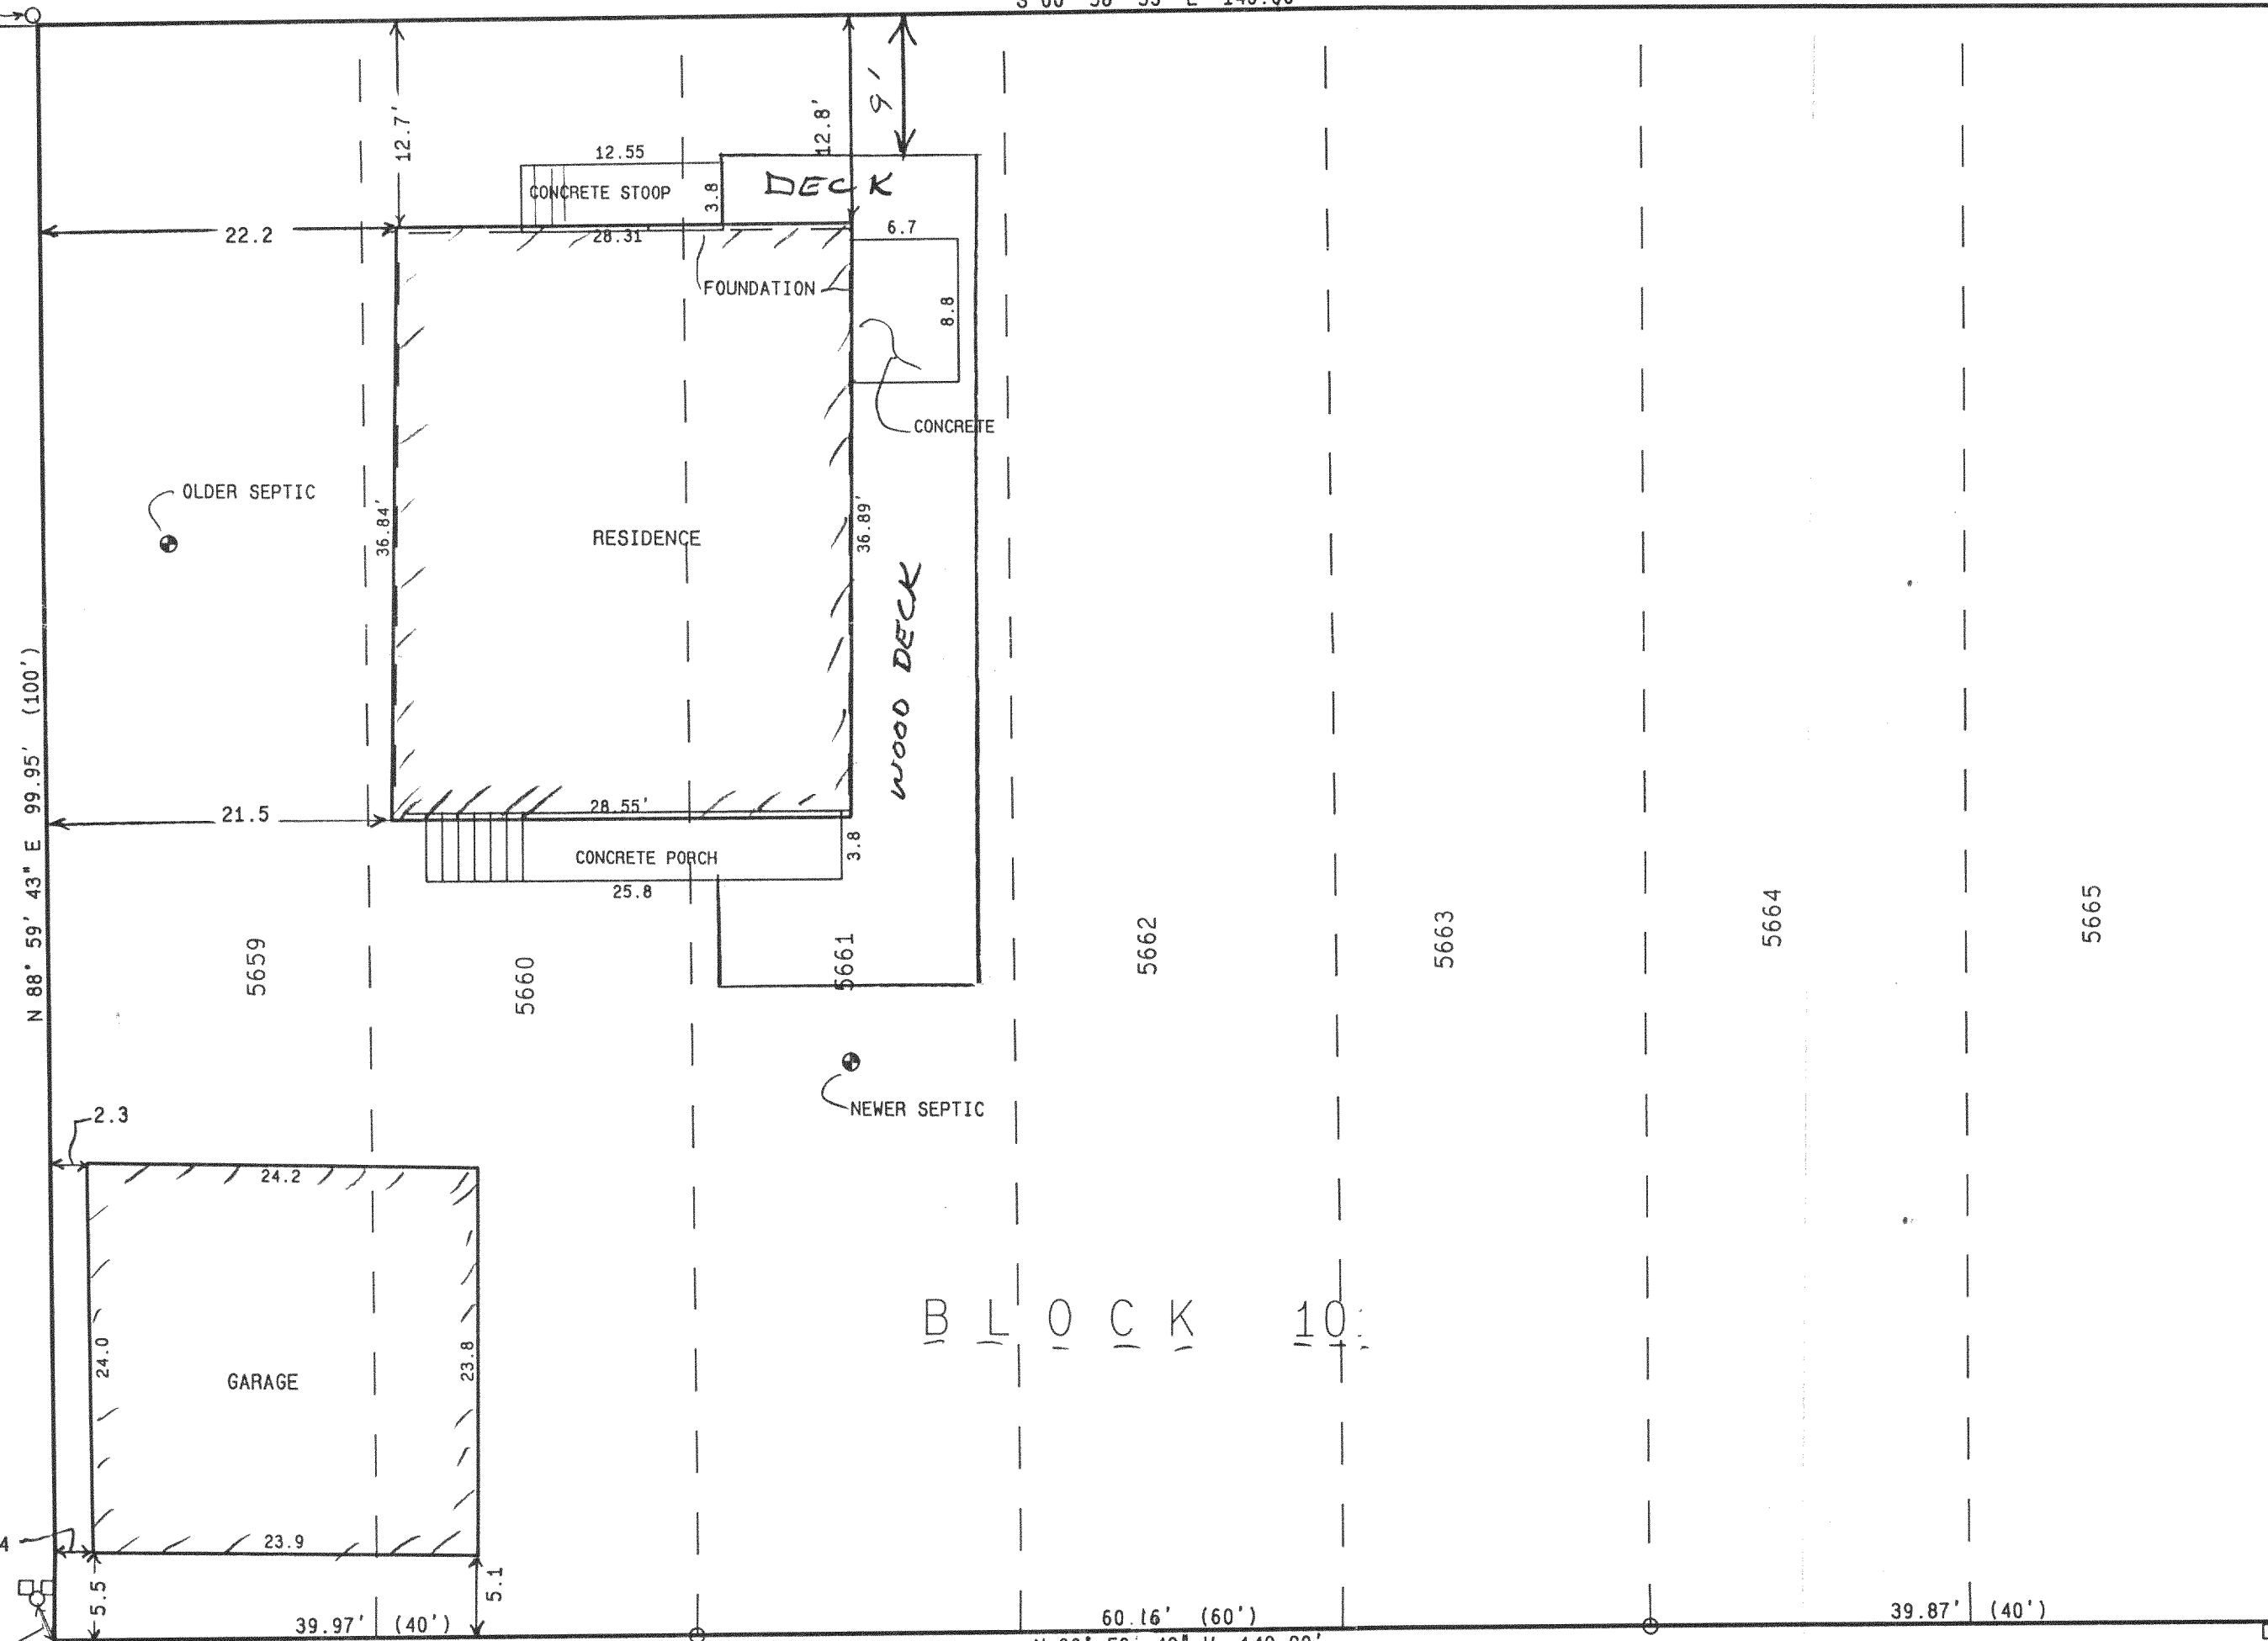

299.88' (300')

85.68' (85.72')

9'

RES.

- = FOUND IRON PIPE STAKE
- ⊙ = SANITARY SYSTEM
- = UTILITY CONTROL BOX
- (x x) = RECORDED AS


NOTE: COPIES OF THIS MAP TO WHICH THE FOLLOWING CERTIFICATE WILL APPLY ARE BLUE LINE PRINTS SHOWING SURVEYOR'S ORIGINAL SEAL AND SIGNATURE IN BLACK INK. COPIES BY ANY OTHER MEANS MAY HAVE ALTERATIONS WHICH DO NOT REPRESENT THE SURVEYOR'S WORK PRODUCT.

I HEREBY CERTIFY THAT THE ABOVE DESCRIBED PROPERTY HAS BEEN SURVEYED UNDER MY DIRECTION AND THAT THE ABOVE MAP IS A TRUE REPRESENTATION THEREOF AND SHOWS THE SIZE AND LOCATION OF THE PROPERTY AND ITS EXTERIOR BOUNDARIES. THIS SURVEY IS MADE FOR THE USE OF THE PRESENT OWNERS OF THE PROPERTY, AND ALSO THOSE WHO PURCHASE, MORTGAGE, OR GUARANTEE THE TITLE THERETO WITHIN ONE YEAR FROM THE DATE HEREOF.

DATED: 1-11-96

Peter S. Gordon
PETER S. GORDON R.L.S. 2101

REVISED 5-8-2002
TO SHOW NEW DECK
+ ABUTTERS TO SOUTH

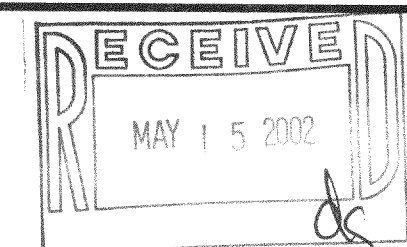

WORK ORDERED BY:
WILLIAM & EILEEN KOLAR
N3189 FERN ROAD
LAKE GENEVA, WI. 53147

FARRIS, HANSEN & ASSOCIATES, INC.
Engineering, Architecture, Surveying
7 Ridgway Court P.O. Box 437
ELKHORN, WISCONSIN 53121
Office: (414) 723-2098
Fax: (414) 723-5886

REVISIONS

PROJECT NO.
4461
DATE
01/11/96
SHEET NO.
1 OF 1

JLCB-1150
217-2272