


PLAT OF SURVEY
UNIT 16-32 OF GENEVA NATIONAL CONDOMINIUM NO. 16
LOCATED IN TOWN 2 NORTH, RANGE 17 EAST, WALWORTH COUNTY, WISCONSIN

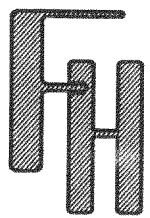

SITE, GRADING, DRAINAGE,
& EROSION CONTROL PLAN

WORK ORDERED BY -
DYKE RAWLES, INC.
SANCTUARY HOMES, INC.
121 WOLF RUN, SUITE 4
MUKWONAGO, WI. 53149


FARRIS, HANSEN & ASSOCIATES, INC.
Engineering, Architecture, Surveying
7 Ridgway Court P.O. Box 437
ELKHORN, WISCONSIN 53121
Office: (262) 723-2098
Fax: (262) 723-5886

REVISIONS
6/13/02 - LK
REVISED
LAYOUT

PROJECT NO.
3269.16-32

DATE:
05/09/2002

SHEET NO.
1 OF 1

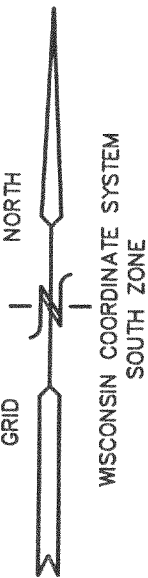

- LEGEND
- = FOUND IRON REBAR STAKE
 - (MH) = SANITARY MANHOLE LOCATED
 - (XXX) = RECORDED AS

JUL 17 2002


NOTE: COPIES OF THIS MAP TO WHICH THE FOLLOWING CERTIFICATE WILL APPLY SHOW THE SURVEYOR'S ORIGINAL SEAL AND SIGNATURE IN RED INK. COPIES BY ANY OTHER MEANS MAY HAVE ALTERATIONS WHICH DO NOT REPRESENT THE SURVEYOR'S WORK PRODUCT.

I HEREBY CERTIFY THAT THE ABOVE DESCRIBED PROPERTY HAS BEEN SURVEYED UNDER MY DIRECTION AND THAT THE ABOVE MAP IS A TRUE REPRESENTATION THEREOF AND SHOWS THE SIZE AND LOCATION OF THE PROPERTY AND ITS EXTERIOR BOUNDARIES. THIS SURVEY IS MADE FOR THE USE OF THE PRESENT OWNERS OF THE PROPERTY, AND ALSO THOSE WHO PURCHASE, MORTGAGE, OR GUARANTEE THE TITLE THERETO WITHIN ONE YEAR FROM THE DATE HEREOF.

DATED: MAY 9, 2002

REVISED 07-15-2002
TO SHOW SIZE & LOCATION OF
FOUNDATION AS BUILT

PETER S. GORDON R.L.S. 2101

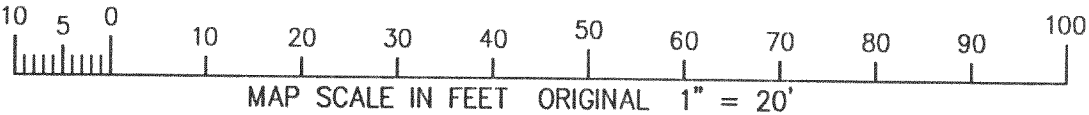

JUL 12 2002

217-2302