

FARRIS, HANSEN & ASSOCIATES, INC.

7 RIDGEWAY COURT, P.O. BOX 437  
ELKHORN, WISCONSIN 53121

PLAT OF SURVEY

PHONE: (414) 723 2098  
FAX: (414) 723 5886



UNIT 04 - 06  
GENEVA NATIONAL GOLF CLUB

- WORK ORDERED BY -  
NANCY LEHMAN  
KEEFE REAL ESTATE  
751 GENEVA PARKWAY P.O. BOX 460  
LAKE GENEVA, WI 53147

MAP LEGEND

- = IRON PIPE STAKE FOUND
- = IRON PIPE STAKE SET
- = IRON ROD STAKE FOUND
- = IRON ROD STAKE SET
- = CONCRETE MONUMENT FOUND
- (XXXXX) — = RECORD DIMENSION

ROYAL BIRKDALE COURT  
66' WIDE PRIVATE ROADWAY

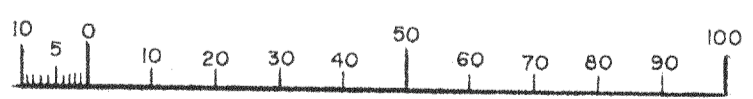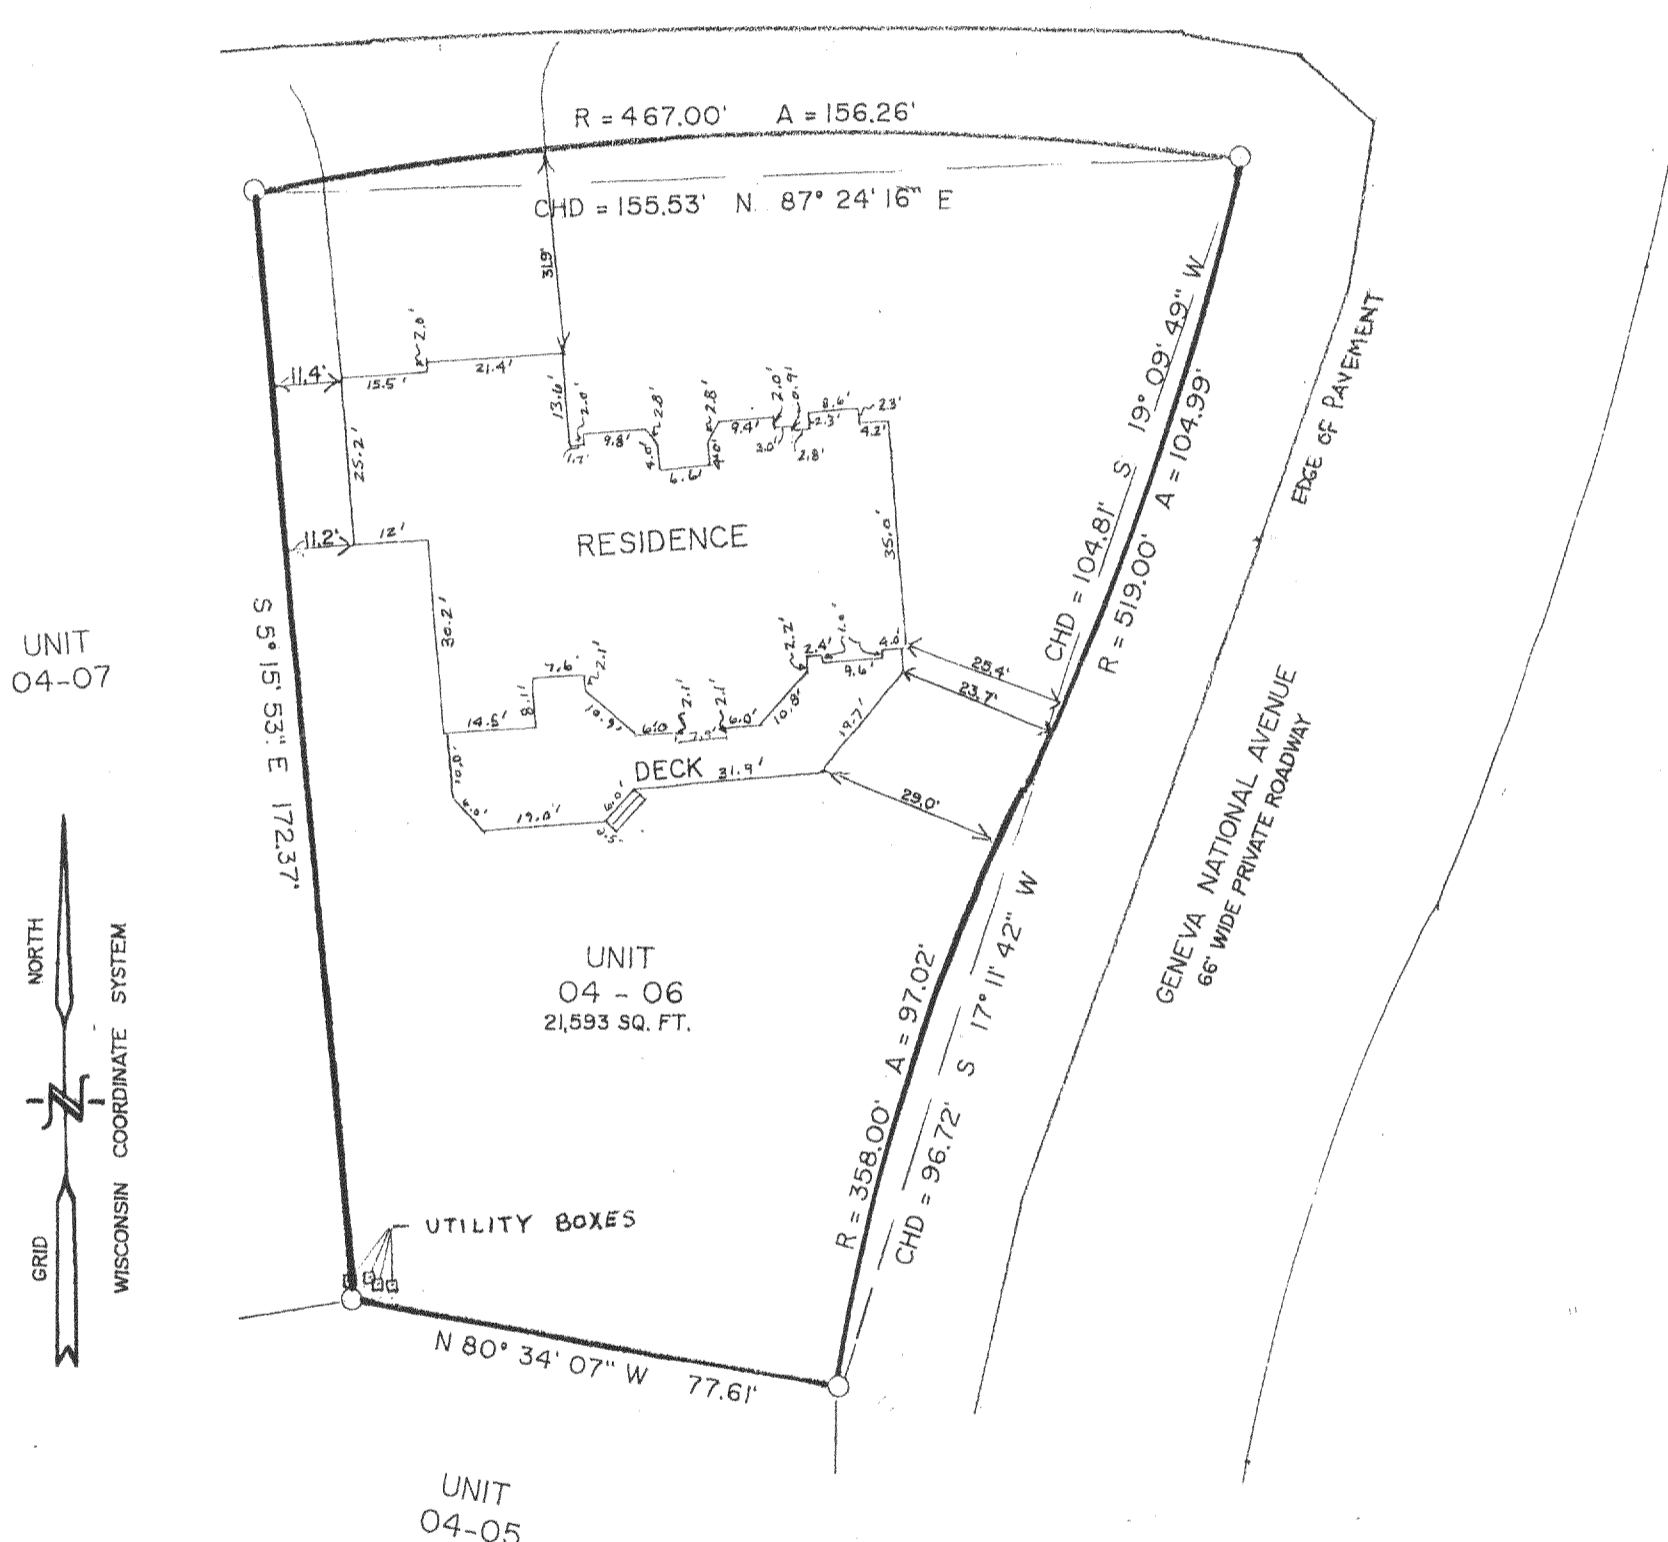


NOTE: COPIES OF THIS MAP TO WHICH THE FOLLOWING CERTIFICATE WILL APPLY SHOW THE SURVEYOR'S ORIGINAL SEAL AND SIGNATURE IN RED INK. COPIES BY ANY OTHER MEANS MAY HAVE ALTERATIONS WHICH DO NOT REPRESENT THE SURVEYOR'S WORK PRODUCT.

I HEREBY CERTIFY THAT THE ABOVE DESCRIBED PROPERTY HAS BEEN SURVEYED UNDER MY DIRECTION AND THAT THE ABOVE MAP IS A TRUE REPRESENTATION THEREOF AND SHOWS THE SIZE AND LOCATION OF THE PROPERTY AND ITS EXTERIOR BOUNDARIES. THIS SURVEY IS MADE FOR THE USE OF THE PRESENT OWNERS OF THE PROPERTY, AND ALSO THOSE WHO PURCHASE, MORTGAGE, OR GUARANTEE THE TITLE THERETO WITHIN ONE YEAR FROM THE DATE HEREOF.

DATED: 7-30-2002

*Peter S. Gordon*  
PETER S. GORDON R.L.S. 2101

JGN 4-6

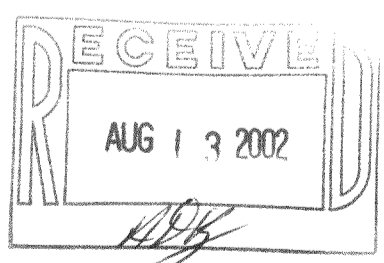

PROJECT NO. 3269 04-06