

HAROLD H. KOLB

REGISTERED PROFESSIONAL LAND SURVEYOR
LAKE GENEVA, WISCONSIN

(697.7') TO INTERSECTION WITH WEST LINE OF COMO DRIVE.

C. & NW. R.R. RIGHT-OF-WAY
(ABANDONED)

WEST END ROAD

49.5' WIDE

48.15' (50)

150.00'

50.00'

50.00'

50.00'

150.00'

12

13

14

(51.17)

(51.8')

(58.4')

209.00'

(52.2)


N



SCALE 1" = 40'

LEGEND

- ⚡ — IRON PIPE FOUND
- — IRON PIPE PLACED
- — CONCRETE MONUMENT
- X — SPIKE
- () — RECORDED DISTANCE

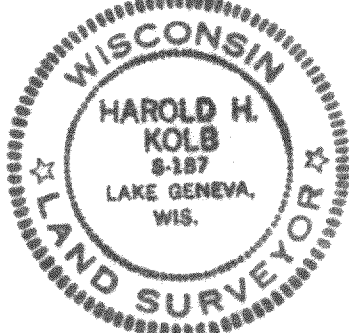

Plat of Survey of
Lots 11, 12, 13, and 14, Como Vista Sub-
division, T 2 N, R 17 E, Walworth
County, Wisconsin.

I, HAROLD H. KOLB, DO HEREBY CERTIFY THAT I HAVE
SURVEYED THE PROPERTY HEREON DESCRIBED ACCORDING
TO THE OFFICIAL RECORDS, AND THAT THE PLAT HEREON
IS A CORRECT REPRESENTATION OF THE LOT LINES.

Harold H. Kolb
HAROLD H. KOLB
WISCONSIN REGISTERED LAND SURVEYOR, S-187
DATE August 8, 1969

217232