




PLAT OF SURVEY

UNIT 19-25
GENEVA NATIONAL CONDOMINIUM
NO. 19

LOCATED IN TOWN 2 NORTH, RANGE 17 EAST
WALWORTH COUNTY, WISCONSIN

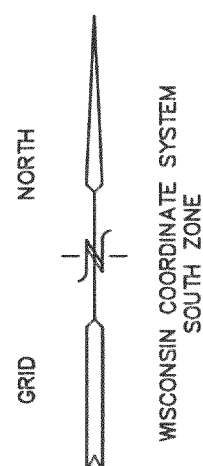

FIRST FLOOR ENTRY
ELEV.= 1020.48'

ABUTTING RESIDENCE

GARAGE ENTRY
ELEV.=1018.74'

UNIT 19-26

UNIT 19-25
15,325 S.F.

UNIT 19-24

GOLF CLUB GROUNDS

SANITARY MANHOLE

8" SANITARY SEWER

ST. ANDREWS ROAD
66' WIDE PRIVATE ROADWAY

SANITARY MANHOLE

EDGE OF PAVEMENT

12" WALNUT

12" WALNUT


12" WALNUT

NOTE: COPIES OF THIS MAP TO WHICH THE FOLLOWING CERTIFICATE WILL APPLY SHOW SURVEYOR'S ORIGINAL SEAL AND SIGNATURE IN RED INK. COPIES BY ANY OTHER MEANS MAY HAVE ALTERATIONS WHICH DO NOT REPRESENT THE SURVEYOR'S WORK PRODUCT.


I HEREBY CERTIFY THAT THE ABOVE DESCRIBED PROPERTY HAS BEEN SURVEYED UNDER MY DIRECTION AND THAT THE ABOVE MAP IS A TRUE REPRESENTATION THEREOF AND SHOWS THE SIZE AND LOCATION OF THE PROPERTY AND ITS EXTERIOR BOUNDARIES. THIS SURVEY IS MADE FOR THE USE OF THE PRESENT OWNERS OF THE PROPERTY, AND ALSO THOSE WHO PURCHASE, MORTGAGE, OR GUARANTEE THE TITLE THERETO WITHIN ONE YEAR FROM THE DATE HEREOF.

DATED: 08/01/02

PETER S. GORDON R.L.S. 2101

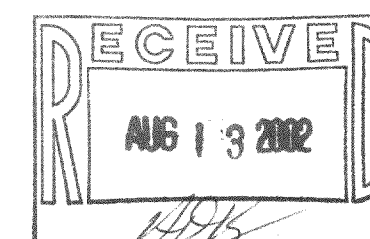

● = FOUND IRON REBAR STAKE
(xxx) = RECORDED AS

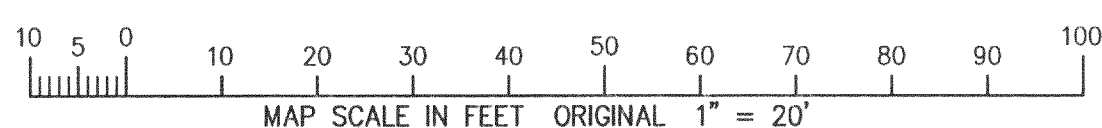

WORK ORDERED BY
GARY SAGUI
1901 ST. ANDREWS
LAKE GENEVA, WI 53147

FARRIS, HANSEN & ASSOCIATES, INC.
Engineering, Architecture, Surveying
7 Ridgeway Court P.O. Box 437
ELKHORN, WISCONSIN 53121
Office: (414) 723-2098
Fax: (414) 723-5886

REVISIONS

PROJECT NO.
3269.19-25
DATE:
07/30/02
SHEET NO.
1 OF 1