


HAROLD H. KOLB

REGISTERED PROFESSIONAL LAND SURVEYOR
LAKE GENEVA, WISCONSIN

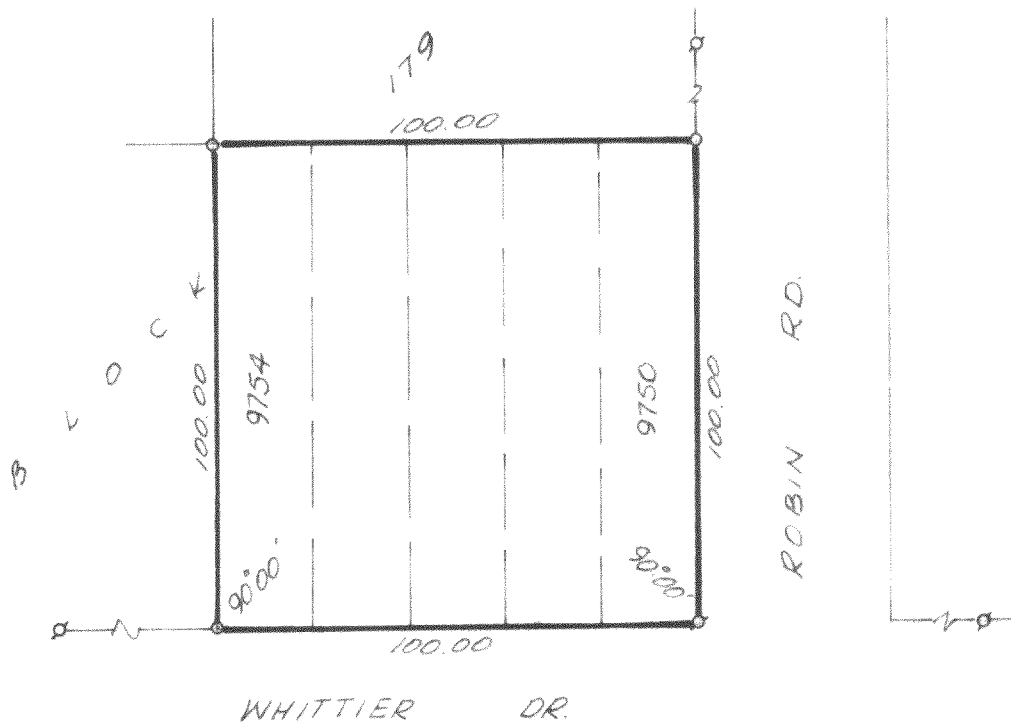

PLAT OF SURVEY OF


Lots 9750 to 9754, Block 179, Lake
Como Beach Subd., T 2 N, R 17 E,
Walworth County, Wisconsin.

N

LEGEND

- X — IRON PIPE FOUND
- O — IRON PIPE PLACED
- — CONCRETE MONUMENT
- X — SPIKE

SCALE - 1" = 40'

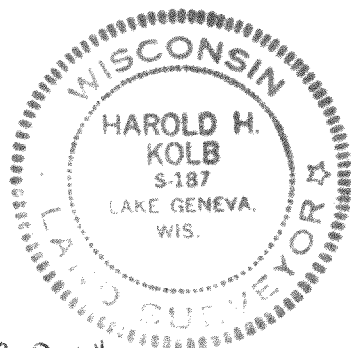

I, HAROLD H. KOLB, DO HEREBY CERTIFY THAT I HAVE
SURVEYED THE PROPERTY HEREON DESCRIBED ACCORDING
TO THE OFFICIAL RECORDS, AND THAT THE PLAT HEREON
IS A CORRECT REPRESENTATION OF THE LOT LINES.

Harold H. Kolb

HAROLD H. KOLB

WISCONSIN REGISTERED LAND SURVEYOR, S-187

DATE NOV. 11, 1969

SLC B-2104

217-235