
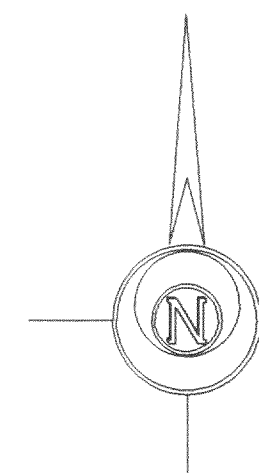


Plat of Survey

of
Unit 25-03 of Geneva National Condominium No. 25,

located in the Southeast 1/4 of Section 29, Town 2 North, Range
17 East, Town of Geneva, Walworth County, Wisconsin.

Surveyed for: **Joe Zubrzycki**
6615 Illiamna Trail
McHenry, Illinois. 60050

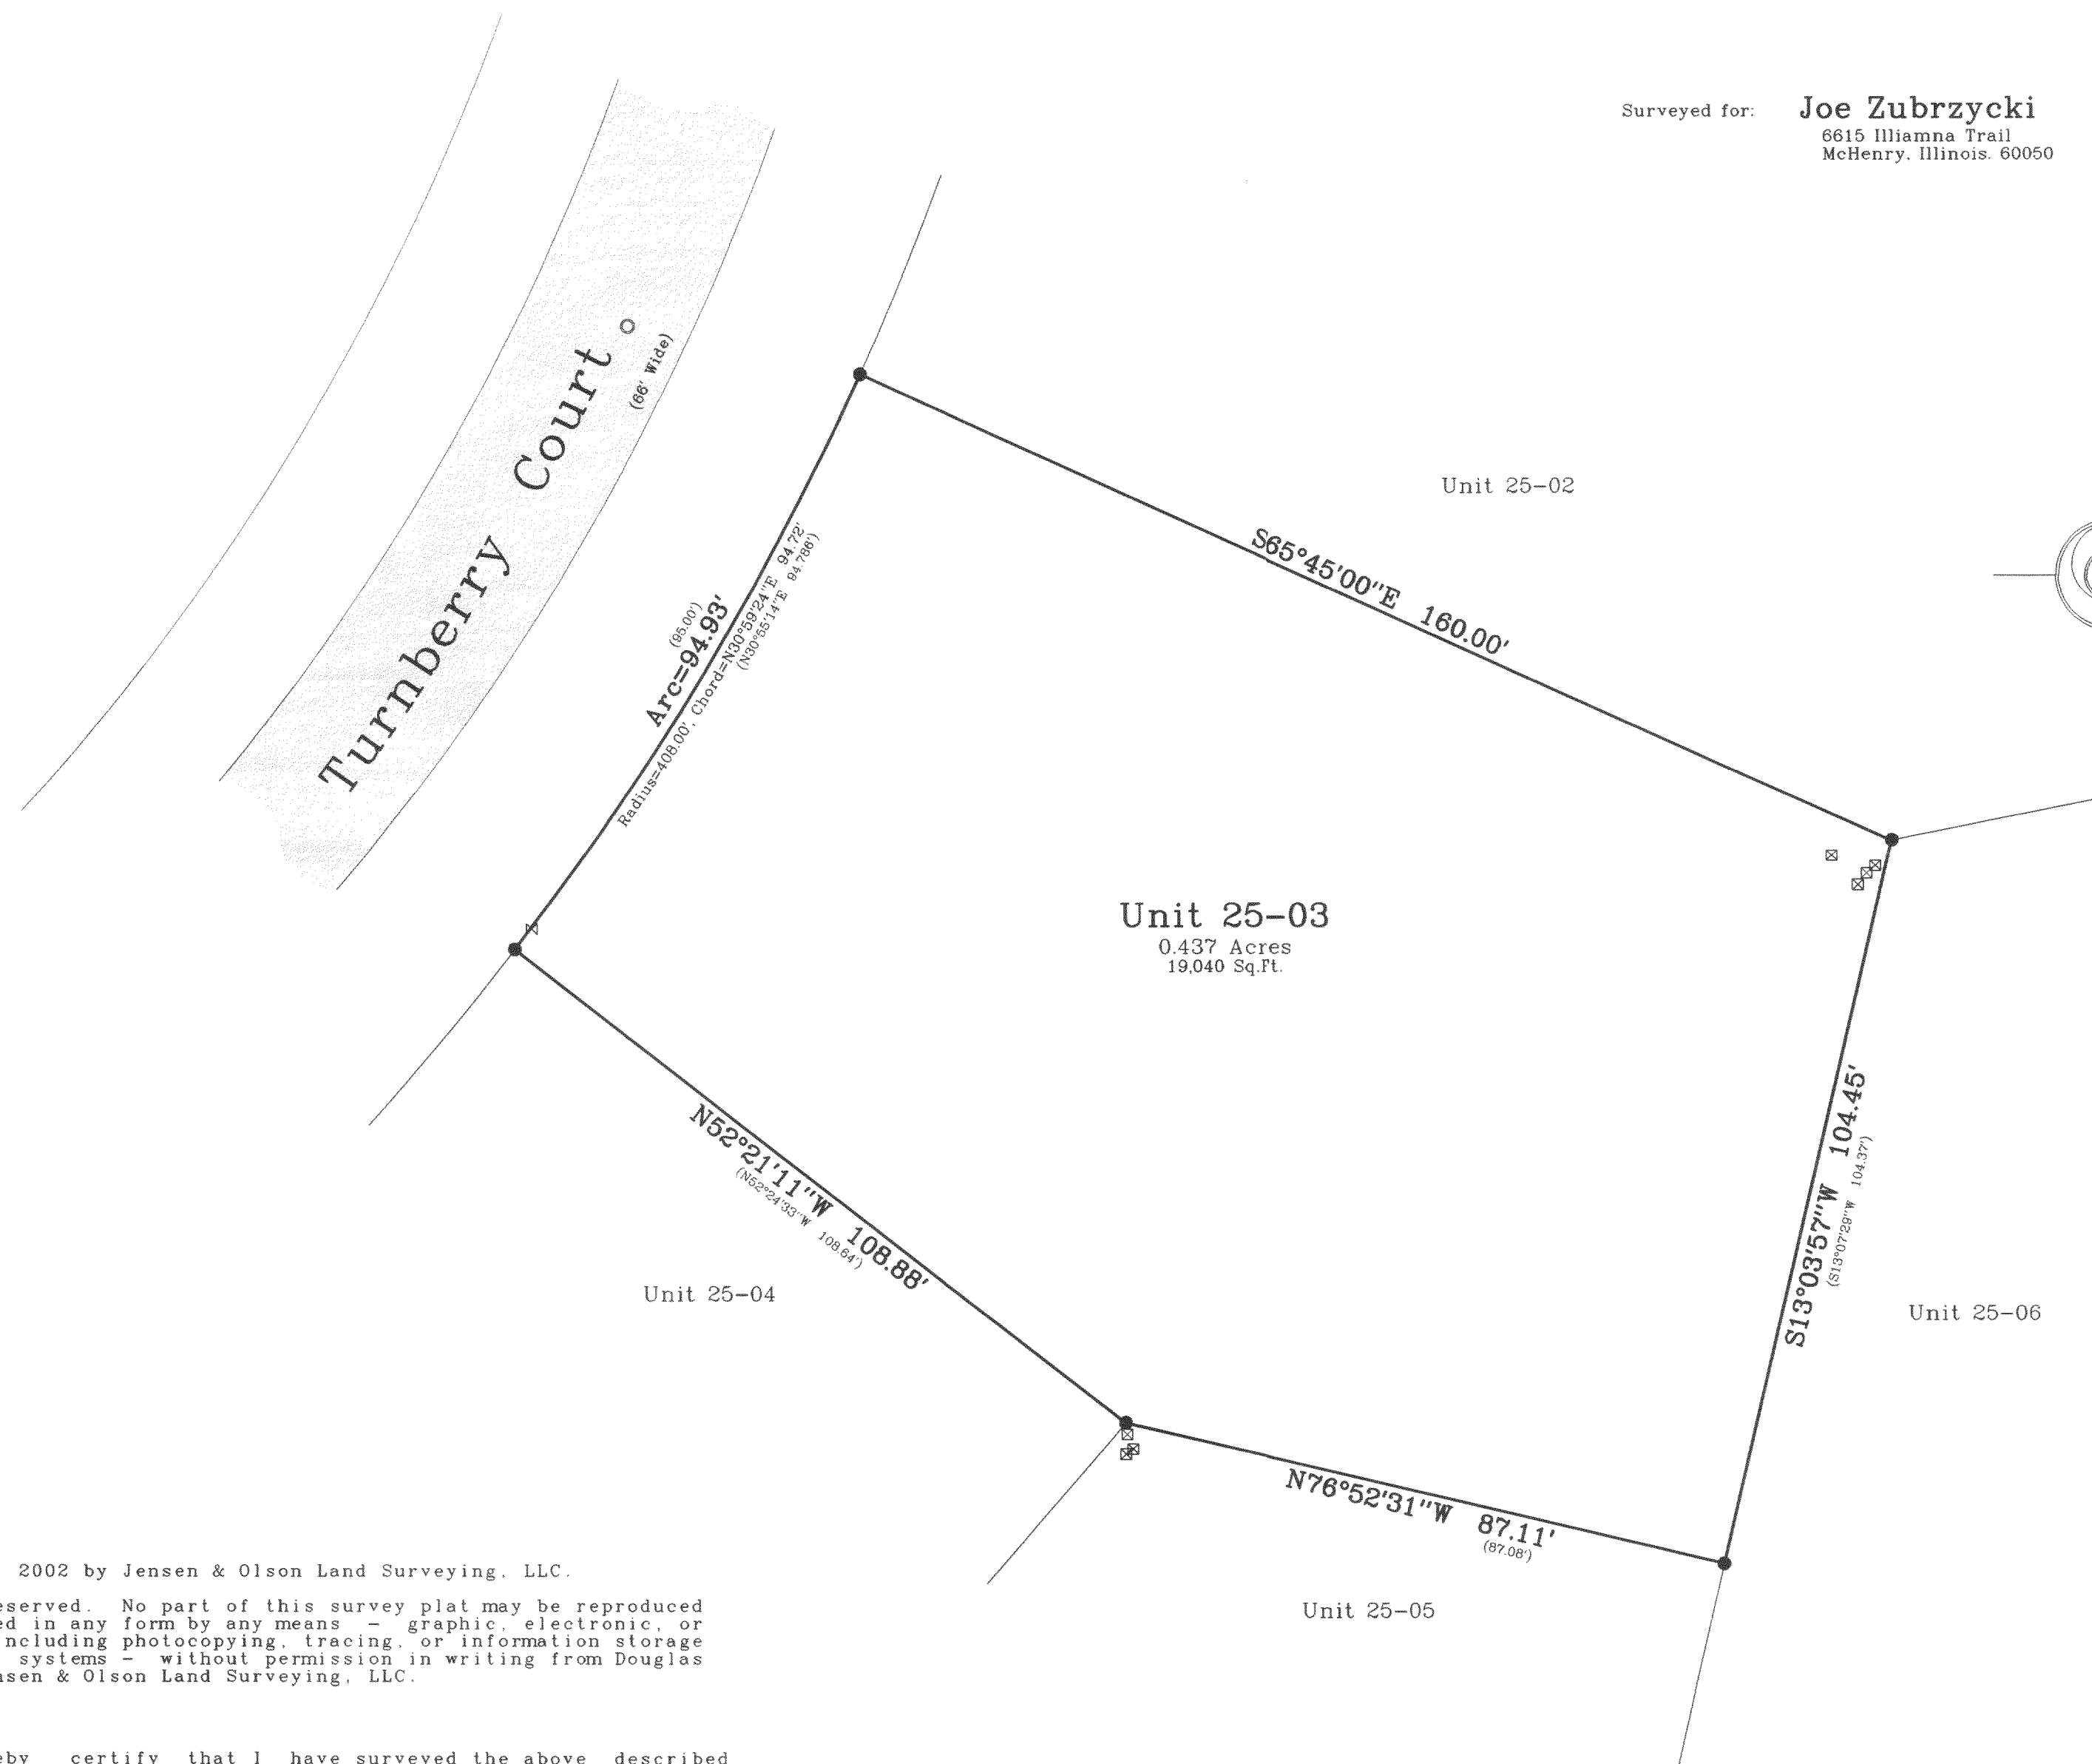

Bearings reference to the plat of
Geneva National Condominium No. 25.



Copyright © 2002 by Jensen & Olson Land Surveying, LLC.

All rights reserved. No part of this survey plat may be reproduced or transmitted in any form by any means - graphic, electronic, or mechanical, including photocopying, tracing, or information storage and retrieval systems - without permission in writing from Douglas G. Olson, Jensen & Olson Land Surveying, LLC.

I hereby certify that I have surveyed the above described property and the map hereon is correct to the best of my professional knowledge and belief and shows the size and location of the property, its exterior boundaries, the location and dimensions of all visible structures thereon, boundary fences, apparent easements and roadways and visible encroachments, if any.

This survey is made for the exclusive use of the present owners of property, and also those who purchase, mortgage or guarantee title thereto, within one year from the date hereof.


Douglas G. Olson
Wisconsin Registered Land Surveyor - 2093

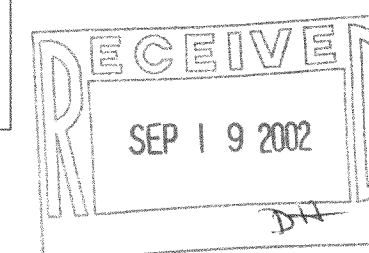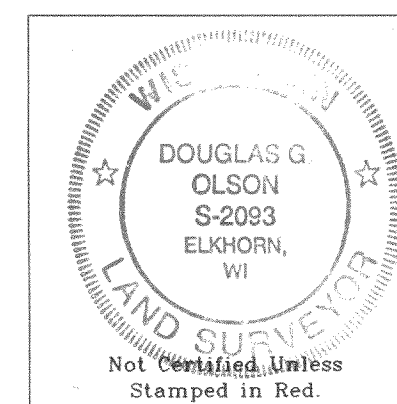

Notes: 1) This survey plat is not certified unless signed and sealed in red ink.

2) This survey is subject to Wisconsin lien laws. This Plat of Survey is the notice of intent to file lien. Lien waiver required.

Survey Date: February 21, 2002.
Revisions:

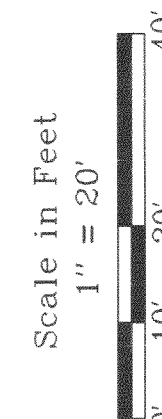

Jensen & Olson Land Surveying, LLC

45 South Wisconsin Street
Elkhorn, Wisconsin 53121
Telephone (262) 723-3434
Facsimile (262) 723-8044

Legend
 • Found Iron Rod
 ○ Recorded Information
 ⊗ Utility Pedestal
 ⊗ Utility Valve
 X Asphalt Surface

Sheet 1 of 1 Sheets
Job Reference Number
2002.024

2002.024