
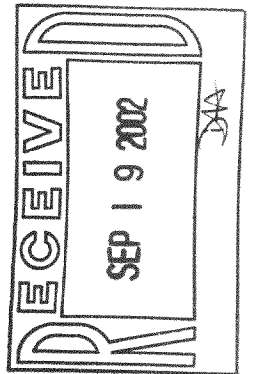
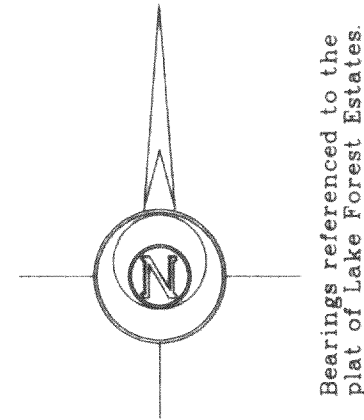


✓ JLFE-16

Property Exhibit

of
**Points set along the North line of
Lot 16 of Lake Forest Estates,**
a subdivision located in the Southwest 1/4 of Section 26, Town 2
North, Range 17 East, Town of Geneva, Walworth County, Wisconsin.


Prepared for: **Maria Radak**
N3025 Lake Forest Circle
Lake Geneva, Wisconsin. 53147

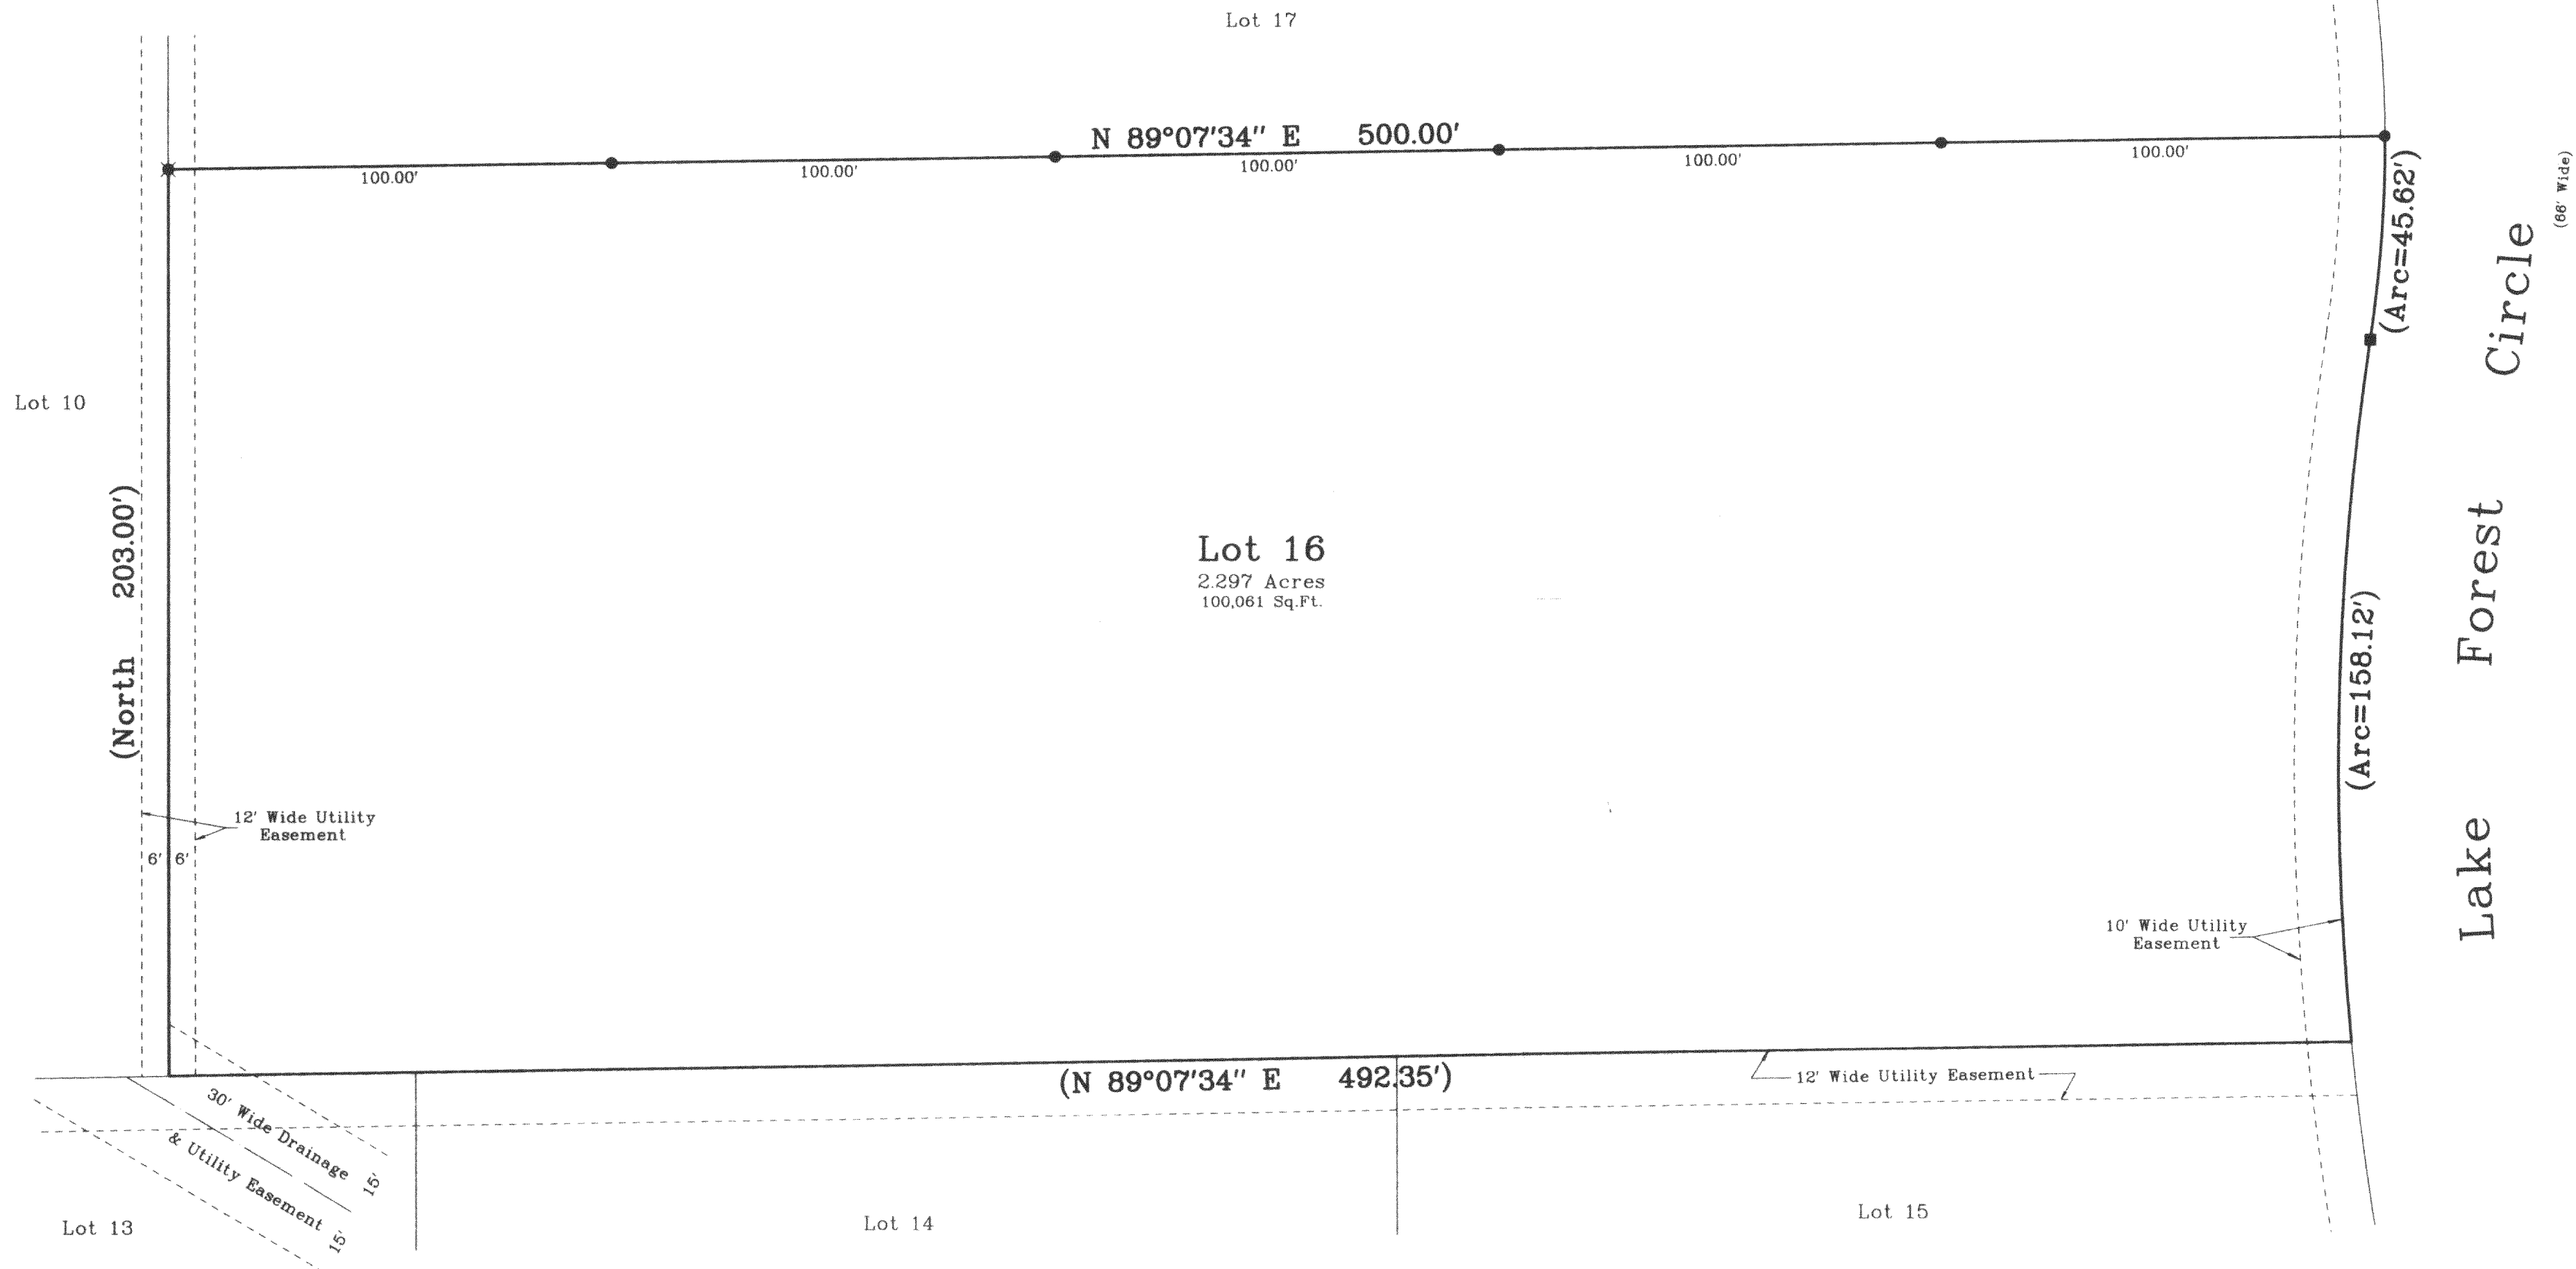

Copyright © 2001 by Jensen & Olson Land Surveying, LLC.

All rights reserved. No part of this survey plat may be reproduced or transmitted in any form by any means - graphic, electronic, or mechanical, including photocopying, tracing, or information storage and retrieval systems - without permission in writing from Douglas G. Olson, Jensen & Olson Land Surveying, LLC.

Survey Date: April 25, 2001.
Revisions:

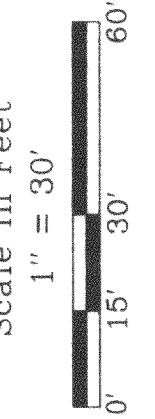

Jensen & Olson Land Surveying, LLC

45 South Wisconsin Street
Elkhorn, Wisconsin. 53121
Telephone (262) 723-3434
Facsimile (262) 723-8044

Legend
■ Found Iron Rod, 1 3/16" dia.
■ Found Iron Rod, 3/4" dia.
● Found Iron Pipe
● Set Iron Rod, 3/4" dia.
() Recorded Information

Sheet 1 of 1 Sheets

Job Reference Number
2001.052

2001.052

217-2383