

PLAT OF SURVEY
 GENEVA NATIONAL CONDOMINIUM
 UNIT 20-42
 WALWORTH COUNTY, WISCONSIN




WORK ORDERED BY:
 JAMES FARLANDER
 2946 NORTH SHORE DRIVE
 DELAVAN, WI. 53115

FARRIS, HANSEN & ASSOCIATES, INC.
 Engineering, Architecture, Surveying
 7 Ridgway Court P.O. Box 437
 ELKHORN, WISCONSIN 53121
 Office: (414) 723-2098
 Fax: (414) 723-5886

REVISIONS

PROJECT NO. 3269.20-42
DATE 02/01/96
SHEET NO. 1 OF 1

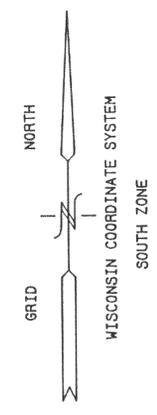



- LEGEND
- = FOUND IRON REBAR STAKE
 - = SET IRON REBAR STAKE
 - = FOUND UTILITY CONTROL BOX
 - = RECORDED AS

NOTE: COPIES OF THIS MAP TO WHICH THE FOLLOWING CERTIFICATE WILL APPLY SHOW SURVEYOR'S ORIGINAL SEAL AND SIGNATURE IN RED INK. COPIES BY ANY OTHER MEANS MAY HAVE ALTERATIONS WHICH DO NOT REPRESENT THE SURVEYOR'S WORK PRODUCT.

I HEREBY CERTIFY THAT THE ABOVE DESCRIBED PROPERTY HAS BEEN SURVEYED UNDER MY DIRECTION AND THAT THE ABOVE MAP IS A TRUE REPRESENTATION THEREOF AND SHOWS THE SIZE AND LOCATION OF THE PROPERTY AND ITS EXTERIOR BOUNDARIES. THIS SURVEY IS MADE FOR THE USE OF THE PRESENT OWNERS OF THE PROPERTY, AND ALSO THOSE WHO PURCHASE, MORTGAGE, OR GUARANTEE THE TITLE THERETO WITHIN ONE YEAR FROM THE DATE HEREOF.

DATED: 10-14-2002

Peter S. Gordon
 PETER S. GORDON R.L.S. 2101

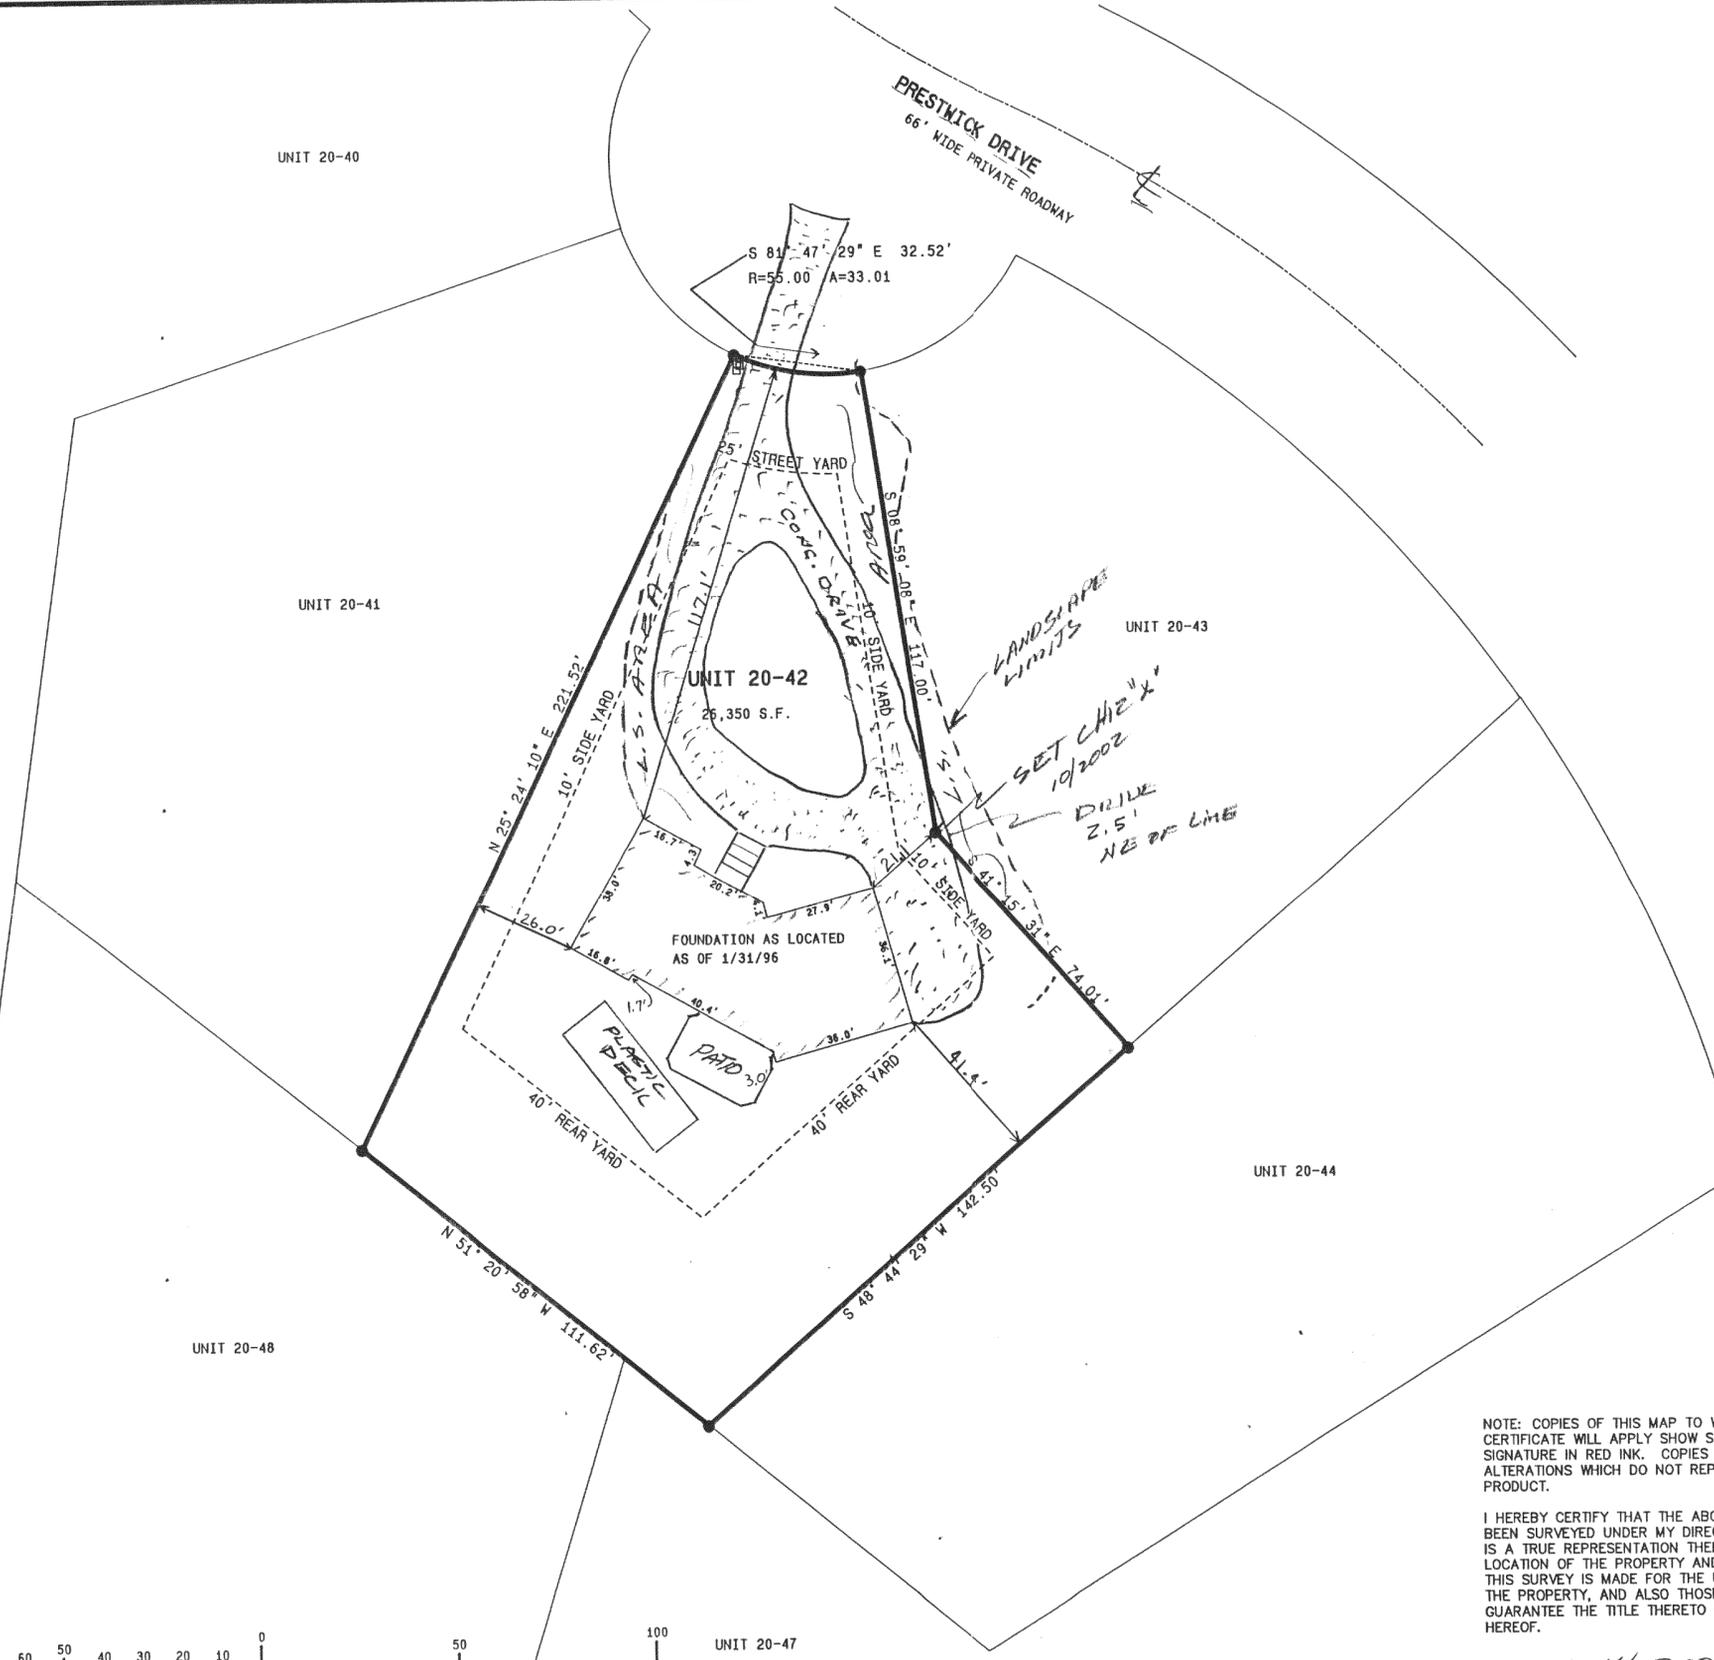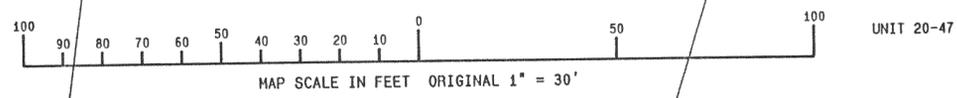

OCT 1 2002

JGN 20-42 217-2407

