


1140 SEQUOIA STREET • DELAVAN, WISCONSIN 53115
262-728-6737

3/4" DIA.
1. P. FOUND

N.W. CORNER
BLOCK 171

THE NORTH 1/2 OF LOT 9612 AND LOTS
9613-9619, BLOCK 173, LAKE COMO
BEACH SUBDIVISION, T2N.R17E. WALWORTH
COUNTY, WISCONSIN.

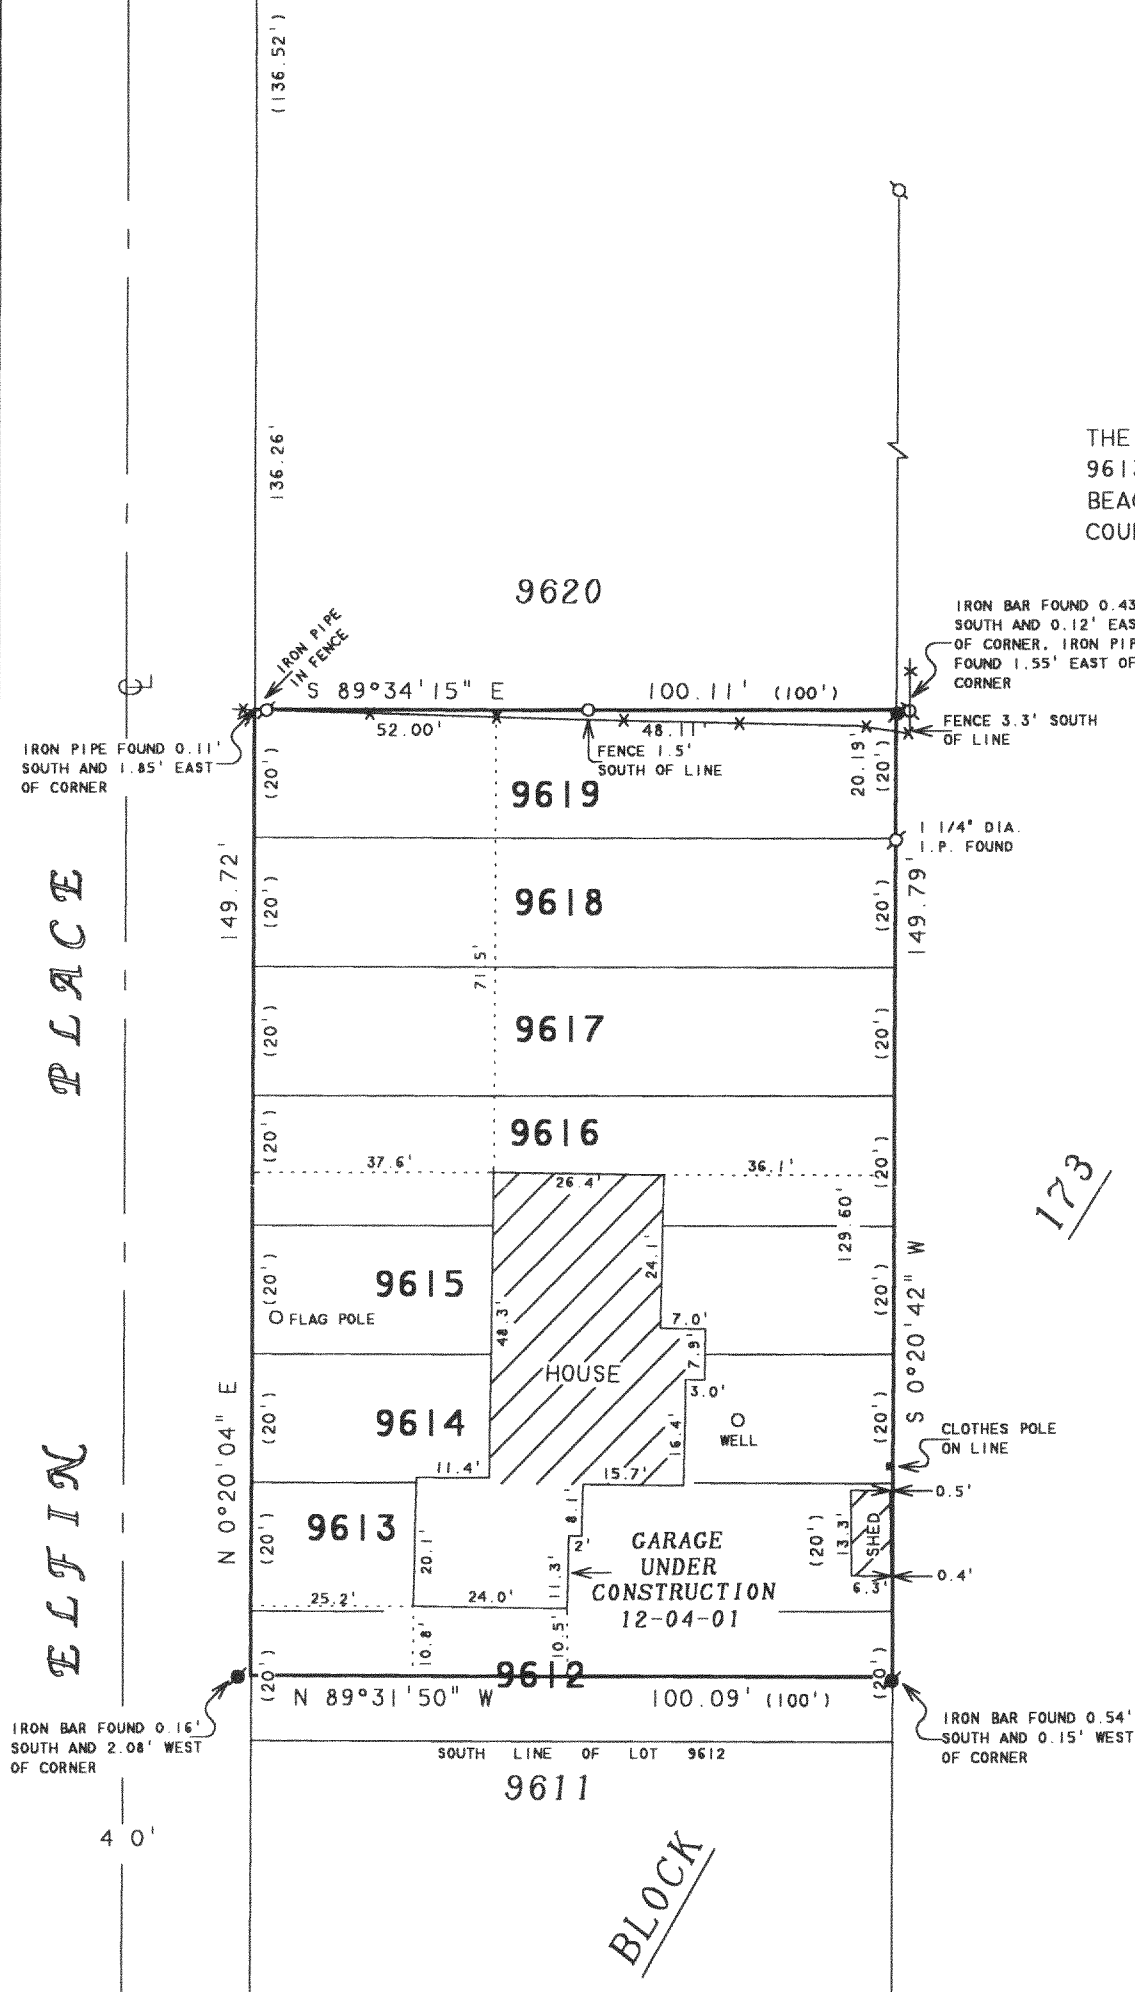

REVISED: JULY 16, 2001
TO SHOW PROPOSED GARAGE.

REVISED: DECEMBER 5, 2001
TO SHOW GARAGE UNDER CONSTRUCTION

ORDERED BY: ZELL WOODWORKING
1299 CENTER ST.
DELAVER, WI 53115

NOTE: BEARINGS ARE REFERENCED TO THE
RECORDED SUBDIVISION PLAT.

SCALE 1" = 30'

LEGEND

- Q - 1 1/2" DIA. IRON PIPE
 FOUND UNLESS OTHERWISE
 NOTED
 O - 1" DIA. IRON PIPE SET
 ----- - FENCE
 () - RECORDED AS

REVISED DATE: SEPTEMBER 19, 2002
REVISED TO SHOW LOCATION OF FENCE
ALONG NORTH PROPERTY LINE AND
ADDITIONAL IRON PIPE SET.

ORDERED BY: ANN DILLA
8516 W. BERWIN
CHICAGO, IL 60656

I, DAVID F. ABELL, DO HEREBY CERTIFY THAT I HAVE SURVEYED THE PROPERTY HEREON DESCRIBED ACCORDING TO THE OFFICAL RECORDS AND THAT THE PLAT HEREON IS A CORRECT REPRESENTATION OF THE PROPERTY LINES TO THE BEST OF MY KNOWLEDGE AND BELIEF.

DAVID F. ABELL
WISCONSIN REGISTERED LAND SURVEYOR. S-1596

February 4, 1998

DATE _____ JOB NUMBER - 98008C
NOTE: THIS IS NOT A CERTIFIED COPY UNLESS SEALED.

RECEIVED
NOV 12 2002
DH

V JLCB - 2073

217-2422