


ABELL SURVEYING & MAPPING

1140 SEQUOIA STREET • DELAVAN, WISCONSIN 53115
414-728-6737

LONGFELLOW DRIVE

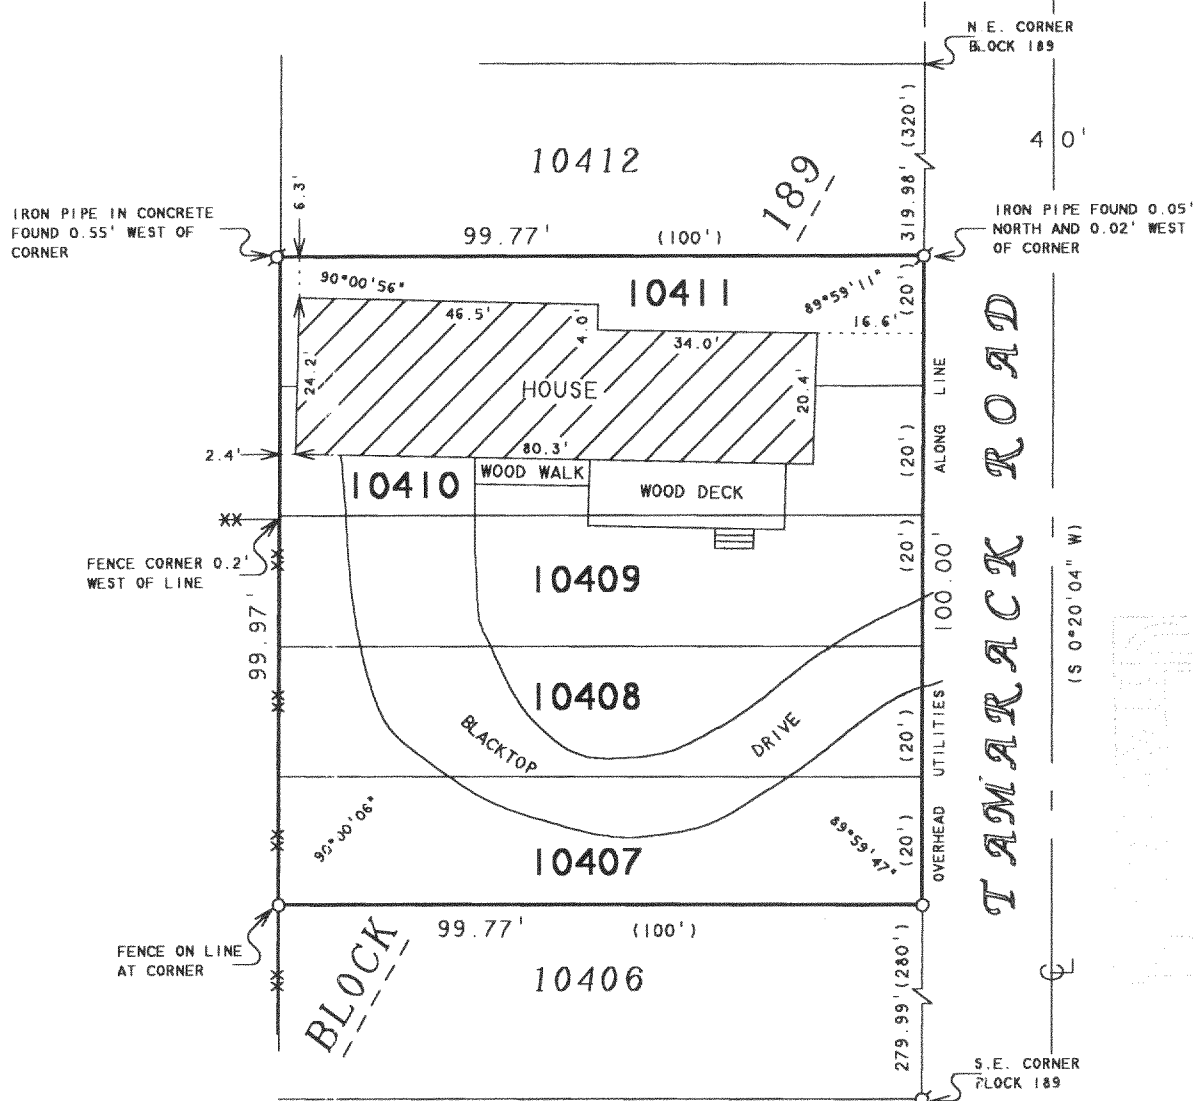

REVISED AND RECERTIFIED DECEMBER 11, 2002
ORDERED BY: MARTY GRANBERG
3125 TAMARACK ROAD
LAKE GENEVA, WI 53147

WHITTIER DRIVE

PLAT OF SURVEY OF

ORDERED BY: HENRY AND DONALD NOVAK
3125 TAMARACK ROAD
LAKE GENEVA, WI 53147

LOTS 10407-10411, BLOCK 189, LAKE COMO
BEACH SUBDIVISION, LOCATED IN T2N, R17E,
WALWORTH COUNTY, WISCONSIN.

N



SCALE 1"=30'

LEGEND

- - IRON PIPE FOUND
- - IRON ROD FOUND
- - IRON PIPE SET, found '2-11-02
- XX - CHAINLINK FENCE
- () - RECORDED AS

I HEREBY CERTIFY THAT I HAVE SURVEYED THE ABOVE DESCRIBED PROPERTY AND THAT THE ABOVE MAP IS A TRUE REPRESENTATION THEREOF AND SHOWS THE SIZE AND LOCATION OF THE PROPERTY, ITS EXTERIOR BOUNDARIES, THE LOCATION OF ALL VISIBLE STRUCTURES AND DIMENSIONS OF ALL PRINCIPAL BUILDINGS THEREON, BOUNDARY FENCES, APPARENT EASEMENTS, ROADWAYS AND VISIBLE ENCROACHMENTS, IF ANY, TO THE BEST OF MY KNOWLEDGE AND BELIEF.

THIS SURVEY IS MADE FOR THE USE OF THE PRESENT OWNERS OF THE PROPERTY, AND ALSO THOSE WHO PURCHASE, MORTGAGE, OR GUARANTEE THE TITLE THERETO WITHIN ONE (1) YEAR FROM DATE HEREON.

David F. Abell

DAVID F. ABELL
WISCONSIN REGISTERED LAND SURVEYOR, S-1596

June 13, 1997

DATE: June 13, 1997 JOB NUMBER - 97101A
NOTE: THIS IS NOT A CERTIFIED COPY UNLESS SEALED.

MAR 5 2003

VJLCB-2254

217-2495