
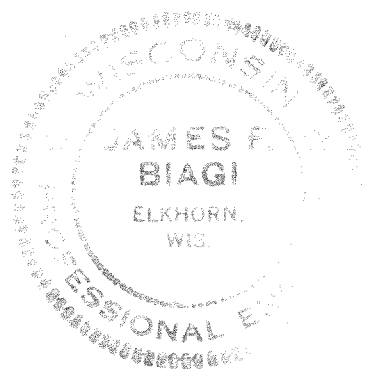


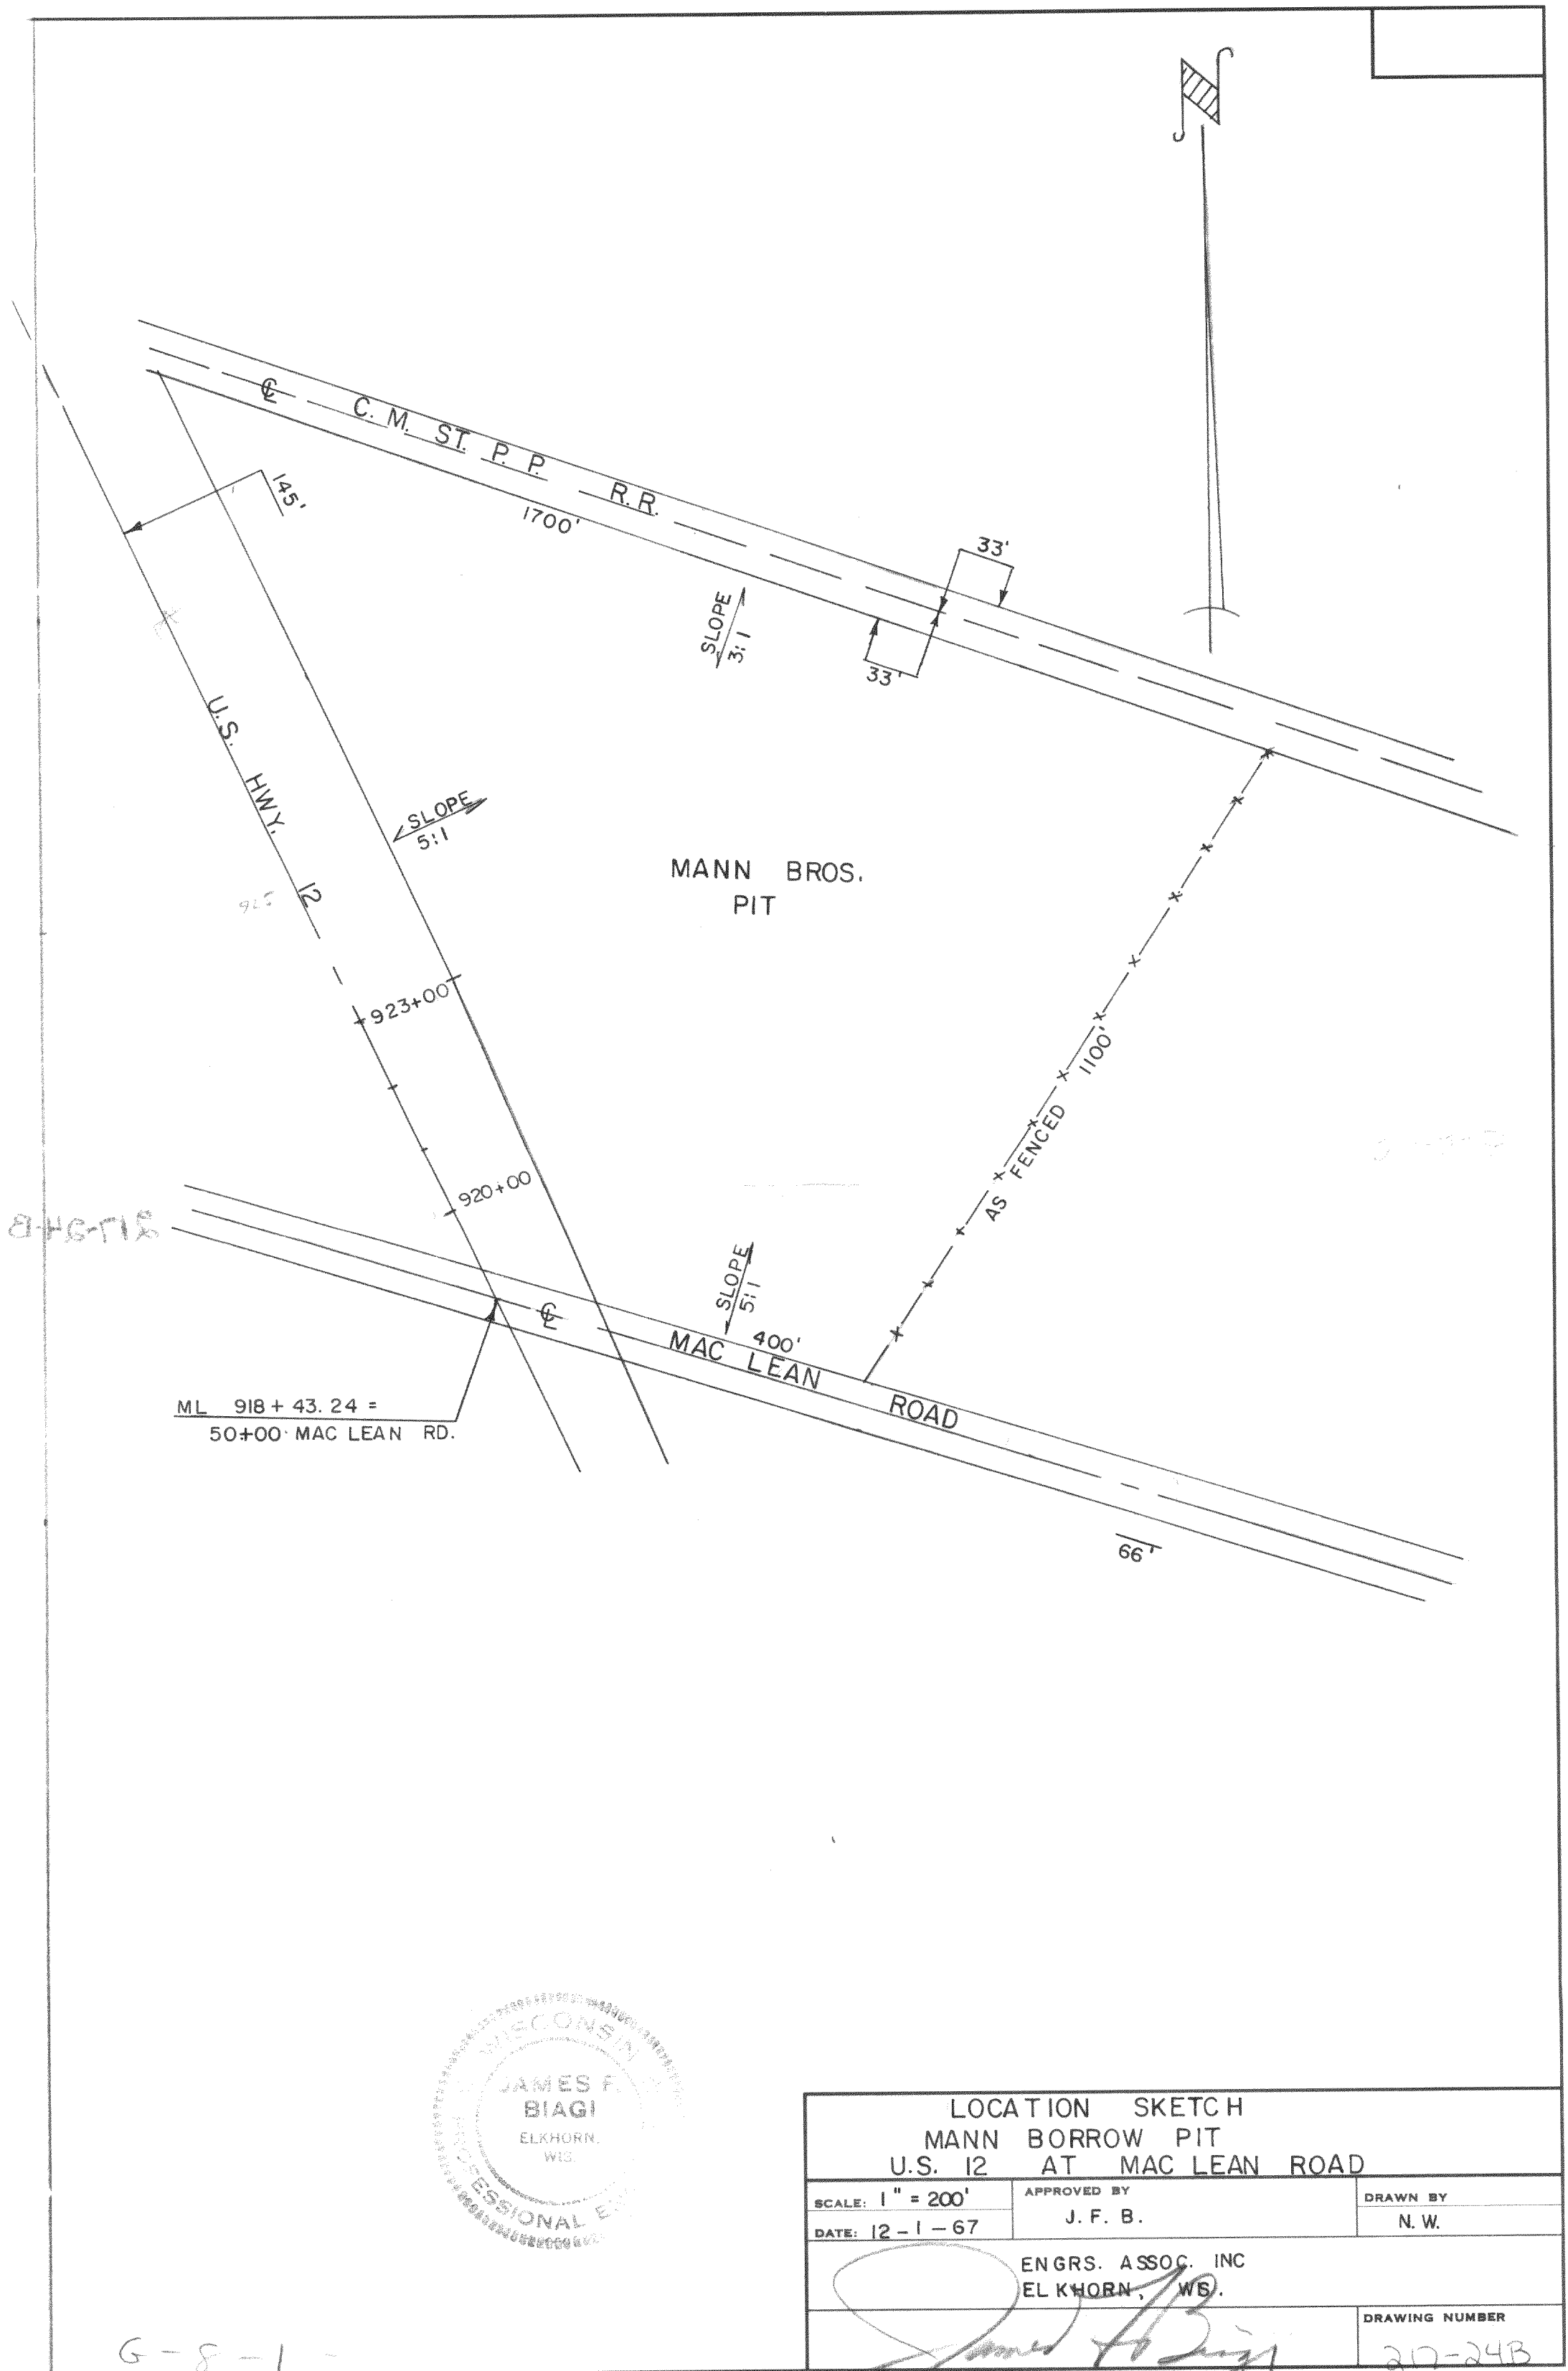

LOCATION SKETCH MANN BORROW PIT U.S. 12 AT MAC LEAN ROAD		
SCALE: 1" = 200'	APPROVED BY J. F. B.	DRAWN BY N. W.
DATE: 12-1-67	ENGRS. ASSOC. INC. ELKHORN, WIS.	
James F. Biagi		DRAWING NUMBER 20-24B 2-17