


PLAT OF SURVEY

J.K. SURVEYING INC.
FORMERLY KOLB LAND CONSULTING
N3705 WILLOW BEND LANE LAKE GENEVA, WI
(262) 248-3697

DATE OF LAST REVISION 1 / 16 / 2003
DATE: 10-13-1999

ORDERED BY: RICHARD KLEIN
1141 OLD FENCE ROAD
ADDISON IL 60101

DESCRIPTION: LOTS 9715 THRU 9719 AND LOTS 9725 THRU 9728
BLOCK 178, OF LAKE COMO BEACH SUBDIVISION
T2N, R17E, WALWORTH COUNTY, WISCONSIN.

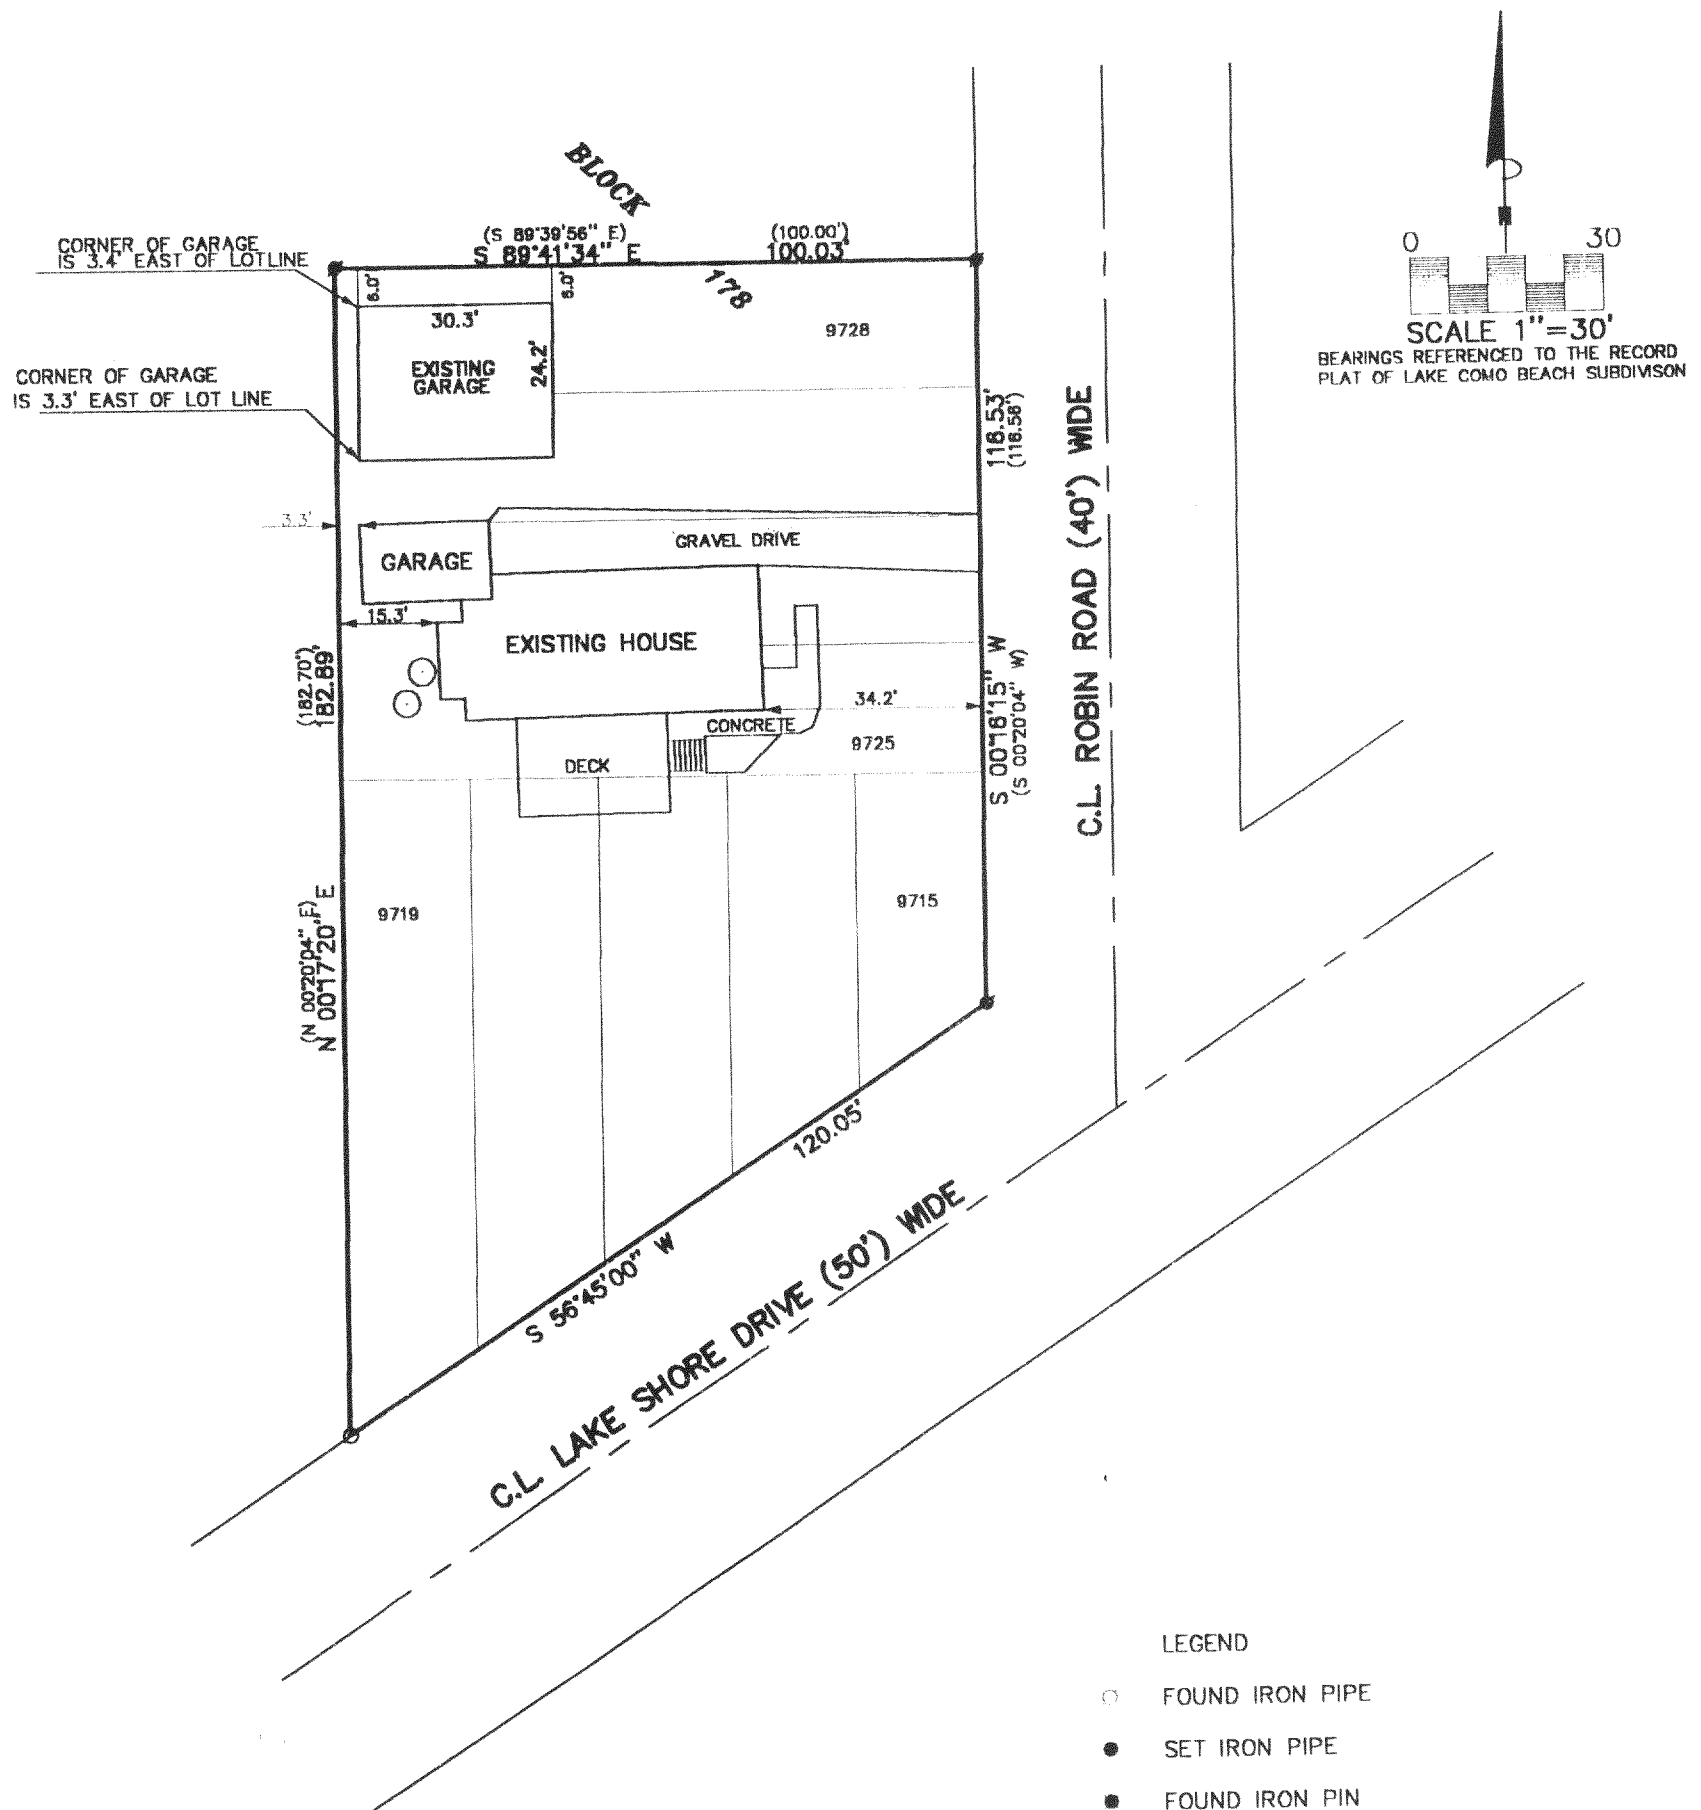

LEGEND

- FOUND IRON PIPE
- SET IRON PIPE
- FOUND IRON PIN


(XXXX) RECORDED AS
○ MANHOLE

THE ABOVE MAP IS A TRUE REPRESENTATION THEREOF AND SHOWS THE SIZE AND LOCATION OF ALL THE PROPERTY, EXTERIOR BOUNDARIES, THE LOCATION OF ALL VISIBLE BOUNDARY FENCES, APPARENT EASEMENTS, ROADWAYS AND VISIBLE ENCROACHMENTS, IF ANY

THIS SURVEY IS MADE FOR THE USE OF THE PRESENT OWNERS OF THE PROPERTY, AND ALSO THOSE WHO PURCHASE, MORTGAGE OR GUARANTEE TITLE THERETO WITHIN ONE (1) YEAR FROM DATE HERETO.

John P. Krott
JOHN P. KROTT, R.L.S. 2258

MAR 24 2003

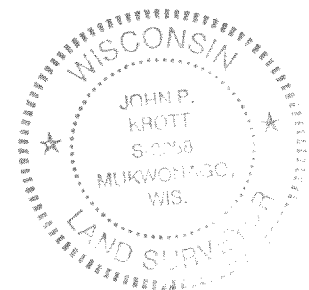

NOTE: THIS IS NOT A CERTIFIED COPY
UNLESS SEAL IS IN RED.

JOB NUMBER 99245 2-17 JLCB 02097

JLCB-2097

217-2515