

PLAT OF SURVEY

WORK ORDERED BY
JOHN MAKI
23901 GRASS CAKE ROAD
ANTIOCH, IL 60002


FARRIS, HANSEN & ASSOCIATES, INC.
Engineering, Architecture, Surveying
7 Ridgway Court P.O. Box 437
ELKHORN, WISCONSIN 53121
Office: (262) 723-2098
Fax: (262) 723-5886

REVISIONS
12/30/02
SITE, GRADING,
& EROSION
CONTROL PLAN
01/22/03
REVISED
RESIDENCE &
MISC REVISIONS

PROJECT NO.
3269.25-06
DATE
12-19-02
SHEET NO.
1 OF 1

SITE, GRADING, & EROSION CONTROL PLAN

UNIT 25-06
GENEVA NATIONAL CONDOMINIUM
NO. 25
LOCATED IN TOWN 2 NORTH, RANGE 17 EAST
WALWORTH COUNTY, WISCONSIN

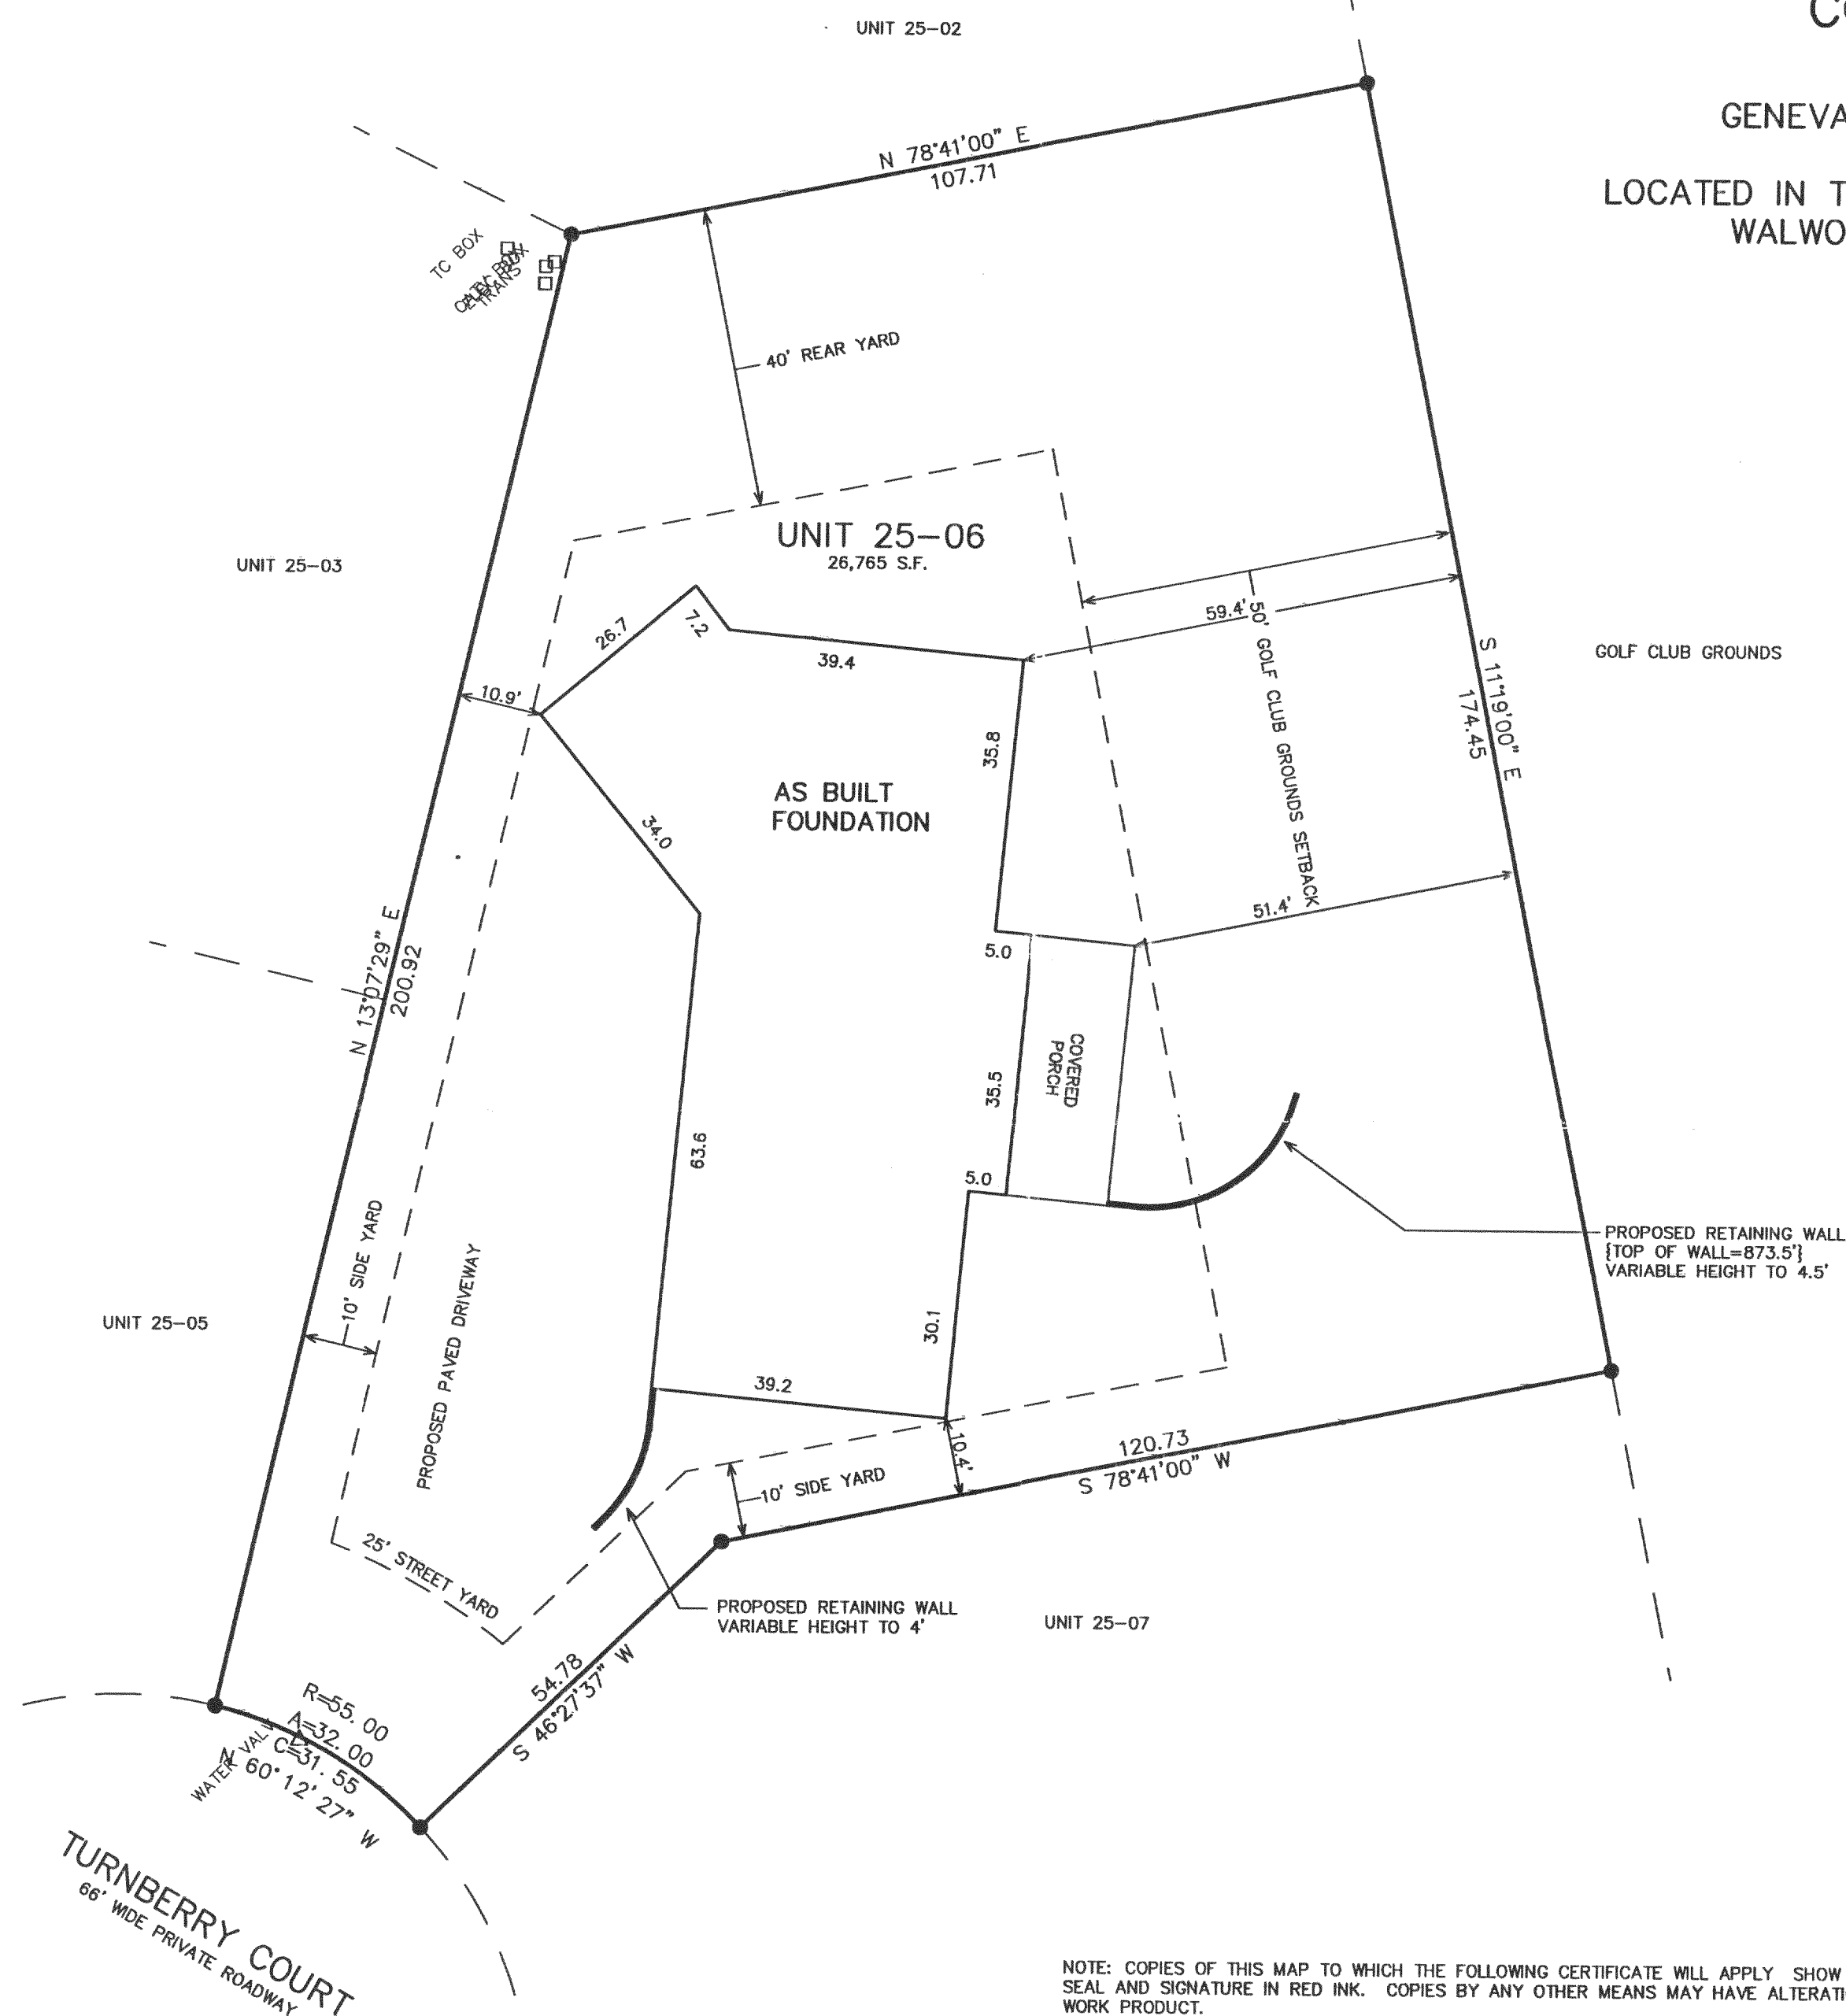

NOTE: COPIES OF THIS MAP TO WHICH THE FOLLOWING CERTIFICATE WILL APPLY SHOW SURVEYOR'S ORIGINAL SEAL AND SIGNATURE IN RED INK. COPIES BY ANY OTHER MEANS MAY HAVE ALTERATIONS WHICH DO NOT REPRESENT THE SURVEYOR'S WORK PRODUCT.

I HEREBY CERTIFY THAT THE ABOVE DESCRIBED PROPERTY HAS BEEN SURVEYED UNDER MY DIRECTION AND THAT THE ABOVE MAP IS A TRUE REPRESENTATION THEREOF AND SHOWS THE SIZE AND LOCATION OF THE PROPERTY AND ITS EXTERIOR BOUNDARIES. THIS SURVEY IS MADE FOR THE USE OF THE PRESENT OWNERS OF THE PROPERTY, AND ALSO THOSE WHO PURCHASE, MORTGAGE, OR GUARANTEE THE TITLE THERETO WITHIN ONE YEAR FROM THE DATE HEREOF.

DATED: 12-31-2002
Peter S. Gordon
PETER S. GORDON R.L.S. 2101

REVISED 03-27-2003
TO SHOW SIZE & LOCATION OF
AS BUILT FOUNDATION

RECEIVED
MAR 28 2003

JGN 25-06

217-2525