
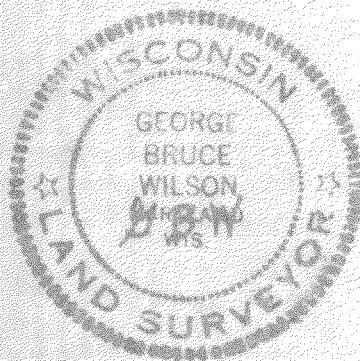


PLAT OF SURVEY OF

LOTS 6674 - 6675 - 6676 - 6677
LAKE COMO BEACH SUBDIVISION
WALWORTH COUNTY, WISCONSIN

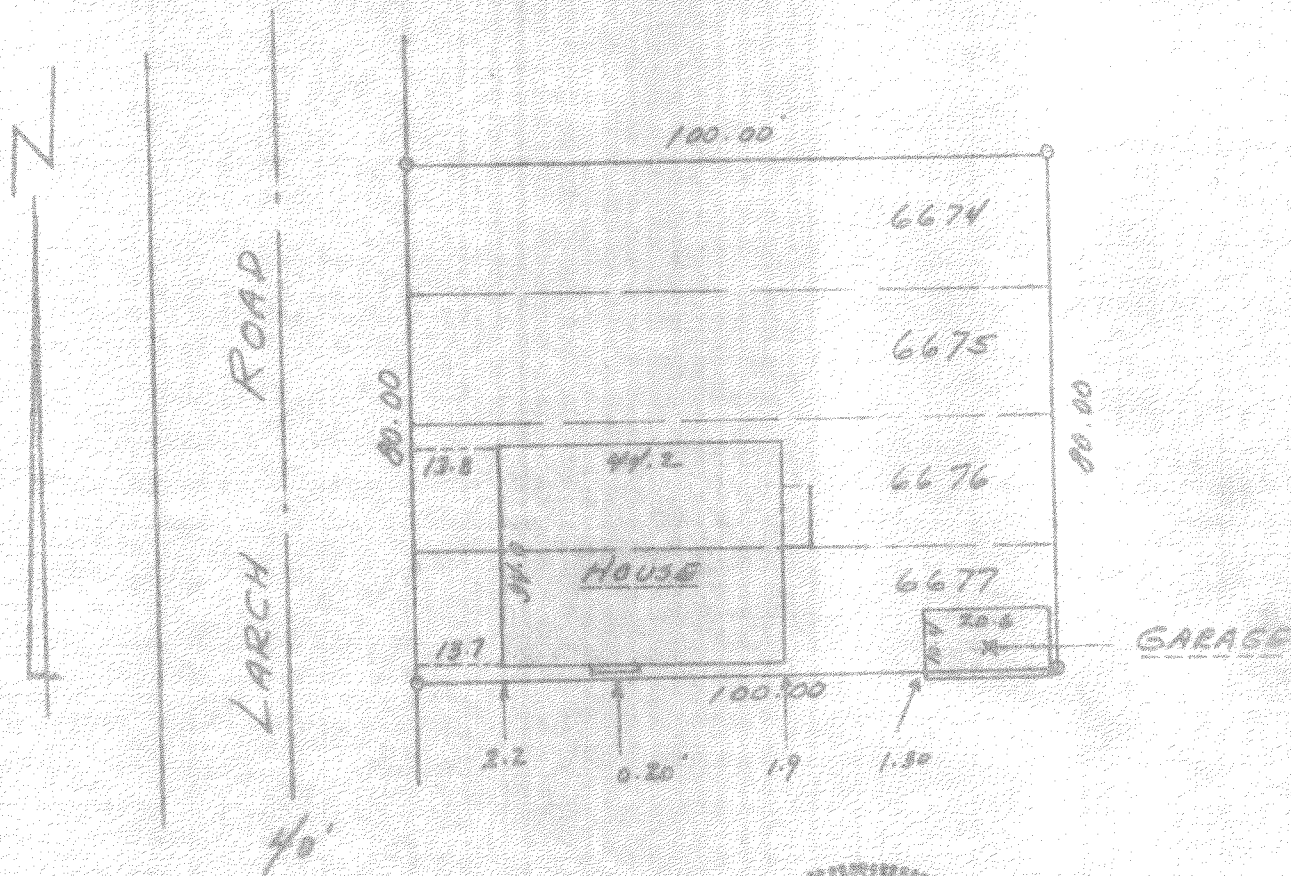

SURVEY AND PLAT BY
JENSEN & JOHNSON, INC.
CIVIL ENGINEERS AND SURVEYORS
Milwaukee, Wisconsin

LEGEND
O — Iron Pipe
● — Concrete Monument
Scale 1" = 30'

WE CERTIFY: That we have surveyed the above described property and that the plat shown herewith is an accurate survey and a true representation thereof and correctly shows the exterior boundary lines and all divisions of said property.

Nov. 15, 1966

George B. Wilson
GEORGE B. WILSON

Wisconsin Registered Land Surveyor, No. 5488

JLCB-01398

217-254J