


PLAT OF SURVEY

UNIT 20-50
GENEVA NATIONAL CONDOMINIUM
NO. 20
LOCATED IN TOWN 2 NORTH, RANGE 17 EAST
WALWORTH COUNTY, WISCONSIN

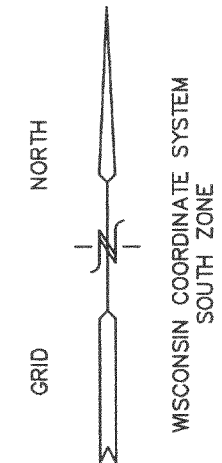

BENCH MARK
SANITARY MH
ELEV.=1021.92'

PRESTWICK PLACE
66' WIDE PRIVATE ROADWAY

UNIT 20-49

AS BUILT
FOUNDATION

PROPOSED
PAVED
DRIVEWAY

25' STREET YARD

JE=1009.8'
(VERIFY)

S 36° 16' 42" E
C=62.76
R=567.00

8" SANITARY SEWER
6" WATERMAIN

N 65° 20' 51" E
181.17
10' SIDE YARD

23.0'

12.4'

22.1'

16.8'

11.0'

2.0'

7.4'

15.6'

8.3'

21.7'

19.3'

218.92'

S 55° 34' 45" W

10' SIDE YARD

40' REAR YARD

104.67'

N 48° 54' 37" W

UNIT 20-52


UNIT 20-51

50' GOLF CLUB
GROUNDS SETBACK

GOLF CLUB
GROUNDS

UNIT 20-50
23,815 S.F.

- LEGEND
- = FOUND IRON REBAR STAKE
 - (xxx) = RECORDED AS

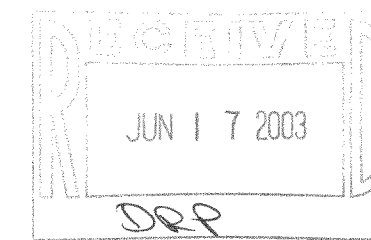


NOTE: COPIES OF THIS MAP TO WHICH THE FOLLOWING CERTIFICATE WILL APPLY SHOW SURVEYOR'S ORIGINAL SEAL AND SIGNATURE IN RED INK. COPIES BY ANY OTHER MEANS MAY HAVE ALTERATIONS WHICH DO NOT REPRESENT THE SURVEYOR'S WORK PRODUCT.

I HEREBY CERTIFY THAT THE ABOVE DESCRIBED PROPERTY HAS BEEN SURVEYED UNDER MY DIRECTION AND THAT THE ABOVE MAP IS A TRUE REPRESENTATION THEREOF AND SHOWS THE SIZE AND LOCATION OF THE PROPERTY AND ITS EXTERIOR BOUNDARIES. THIS SURVEY IS MADE FOR THE USE OF THE PRESENT OWNERS OF THE PROPERTY, AND ALSO THOSE WHO PURCHASE, MORTGAGE, OR GUARANTEE THE TITLE THERETO WITHIN ONE YEAR FROM THE DATE HEREOF.

DATED: 09/24/02

PETER S. GORDON R.L.S. 2101

REVISED 06-04-2003
TO SHOW SIZE & LOCATION OF
FOUNDATION AS BUILT

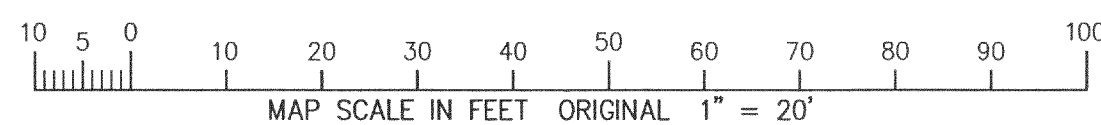

WORK ORDERED BY
SCOTT LOWELL - LOWELL MANAGEMENT
P.O. BOX 926
LAKE GENEVA, WI 53147

FARRIS, HANSEN & ASSOCIATES, INC.
Engineering, Architecture, Surveying
7 Ridgeway Court P.O. Box 437
ELKHORN, WISCONSIN 53121
Office: (262) 723-2098
Fax: (262) 723-5886

REVISIONS

PROJECT NO.
3269.20-50
DATE:
09-24-02
SHEET NO.
1 OF 1

JUN 3 4 2003

J6N 20-50

217-2582