


ABERNATHY and ASSOCIATES**Kenneth B. Abernathy Jr.**

Wisconsin Registered Land Surveyor S-1594

**W4056 BRAY RD.
ELKHORN, WI. 53121****PHONE:** (262) 723-4260 (OFFICE)
(262) 723-7209 (FAX)**Email:** abernathy@elknet.net**PLAT OF SURVEY**

Lots 11717 - 11721 and Lots 11704 - 11711
and Lots 11676 - 11686 of Block 210, Fifth Map
of Lake Como Beach, being a part of the SW 1/4
of Section 29, T 2 N., R 17 E, Walworth County, Wisconsin.

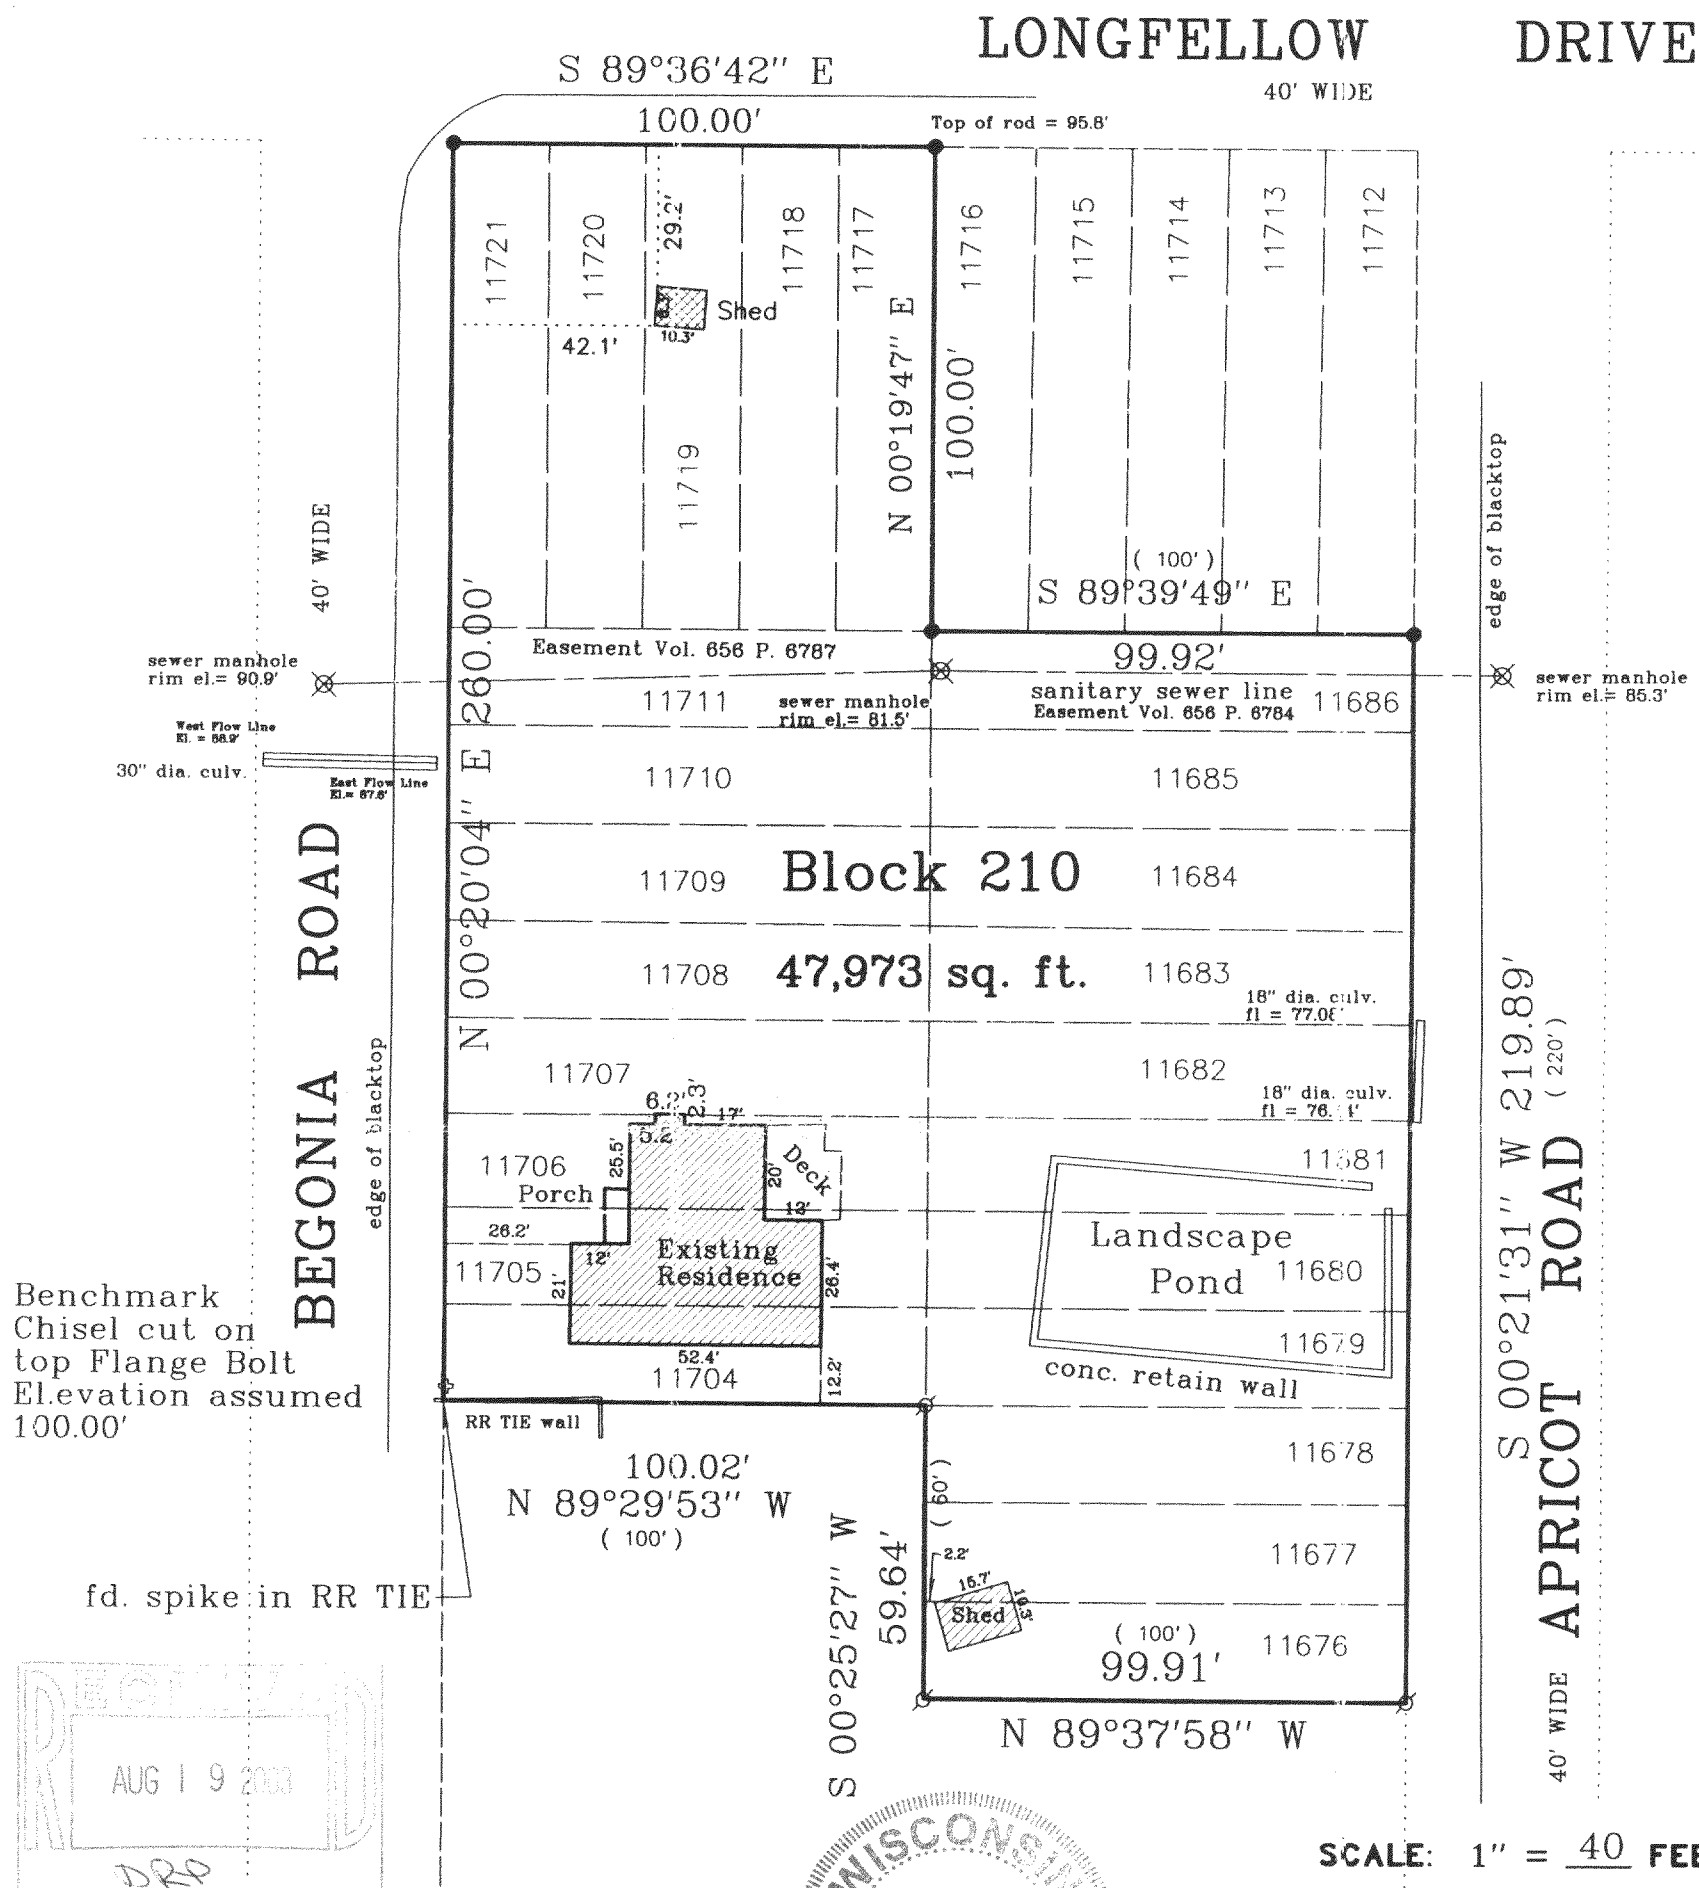

Owners: Roman and Stefanie Mural
5706 W. Pensacola
Chicago, IL 60634

Ordered by: Schauder Builders, Inc.
4115 Hwy 51 North
Janesville, WI. 53545-9674

LEGEND



- FOUND IRON PIPE
- FOUND IRON ROD
- ⊠ FOUND BRASS CAPPED MONUMENT
- FOUND CONCRETE MONUMENT
- + CHISEL CUT IN CONCRETE
- SET IRON ROD, 24" LONG, WEIGHING 1.5 LBS./LINEAL FT., 3/4" DIA.
- SET IRON ROD, 30" LONG, WEIGHING 4.5 LBS./LINEAL FT., 1-11/16" DIA.

(x x x) RECORDED AS DIMENSION

- - - - - EXISTING FENCE

Plat Revised and
As Built Residence located 3/07/03

Plat revised 4/21/03
Shed added

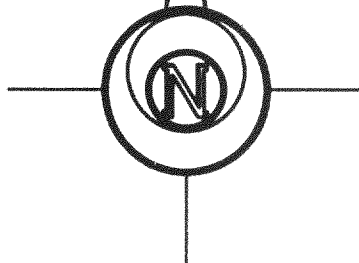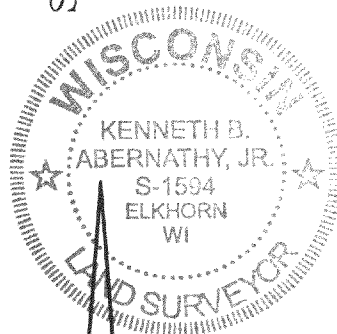

"I hereby certify that the above described property has been surveyed by me or under my direction and that the above map is a true representation thereof and shows the size and location of the property, its exterior boundaries, the location of all visible structures and dimensions of all principal buildings thereon, boundary fences, apparent easements, roadways and visible encroachments, if any."

"This survey is made for the use of the present owners of the property, and also those who purchase, mortgage, or guarantee the title thereto within one year from the date hereof."

Kenneth B. Abernathy, Jr.

**KENNETH B. ABERNATHY, JR. S-1594
WISCONSIN REGISTERED LAND SURVEYOR**

DATED Sept. 25, 2002 Job No. 02.902

JLCB-2538

217-2614