


ABERNATHY and ASSOCIATES
Kenneth B. Abernathy Jr.
Wisconsin Registered Land Surveyor S-1594

W4056 BRAY RD.
ELKHORN, WI. 53121
PHONE: (282) 723-4260 (OFFICE)
(282) 723-7209 (FAX)
Email: abernathy@elknet.net

PLAT OF SURVEY

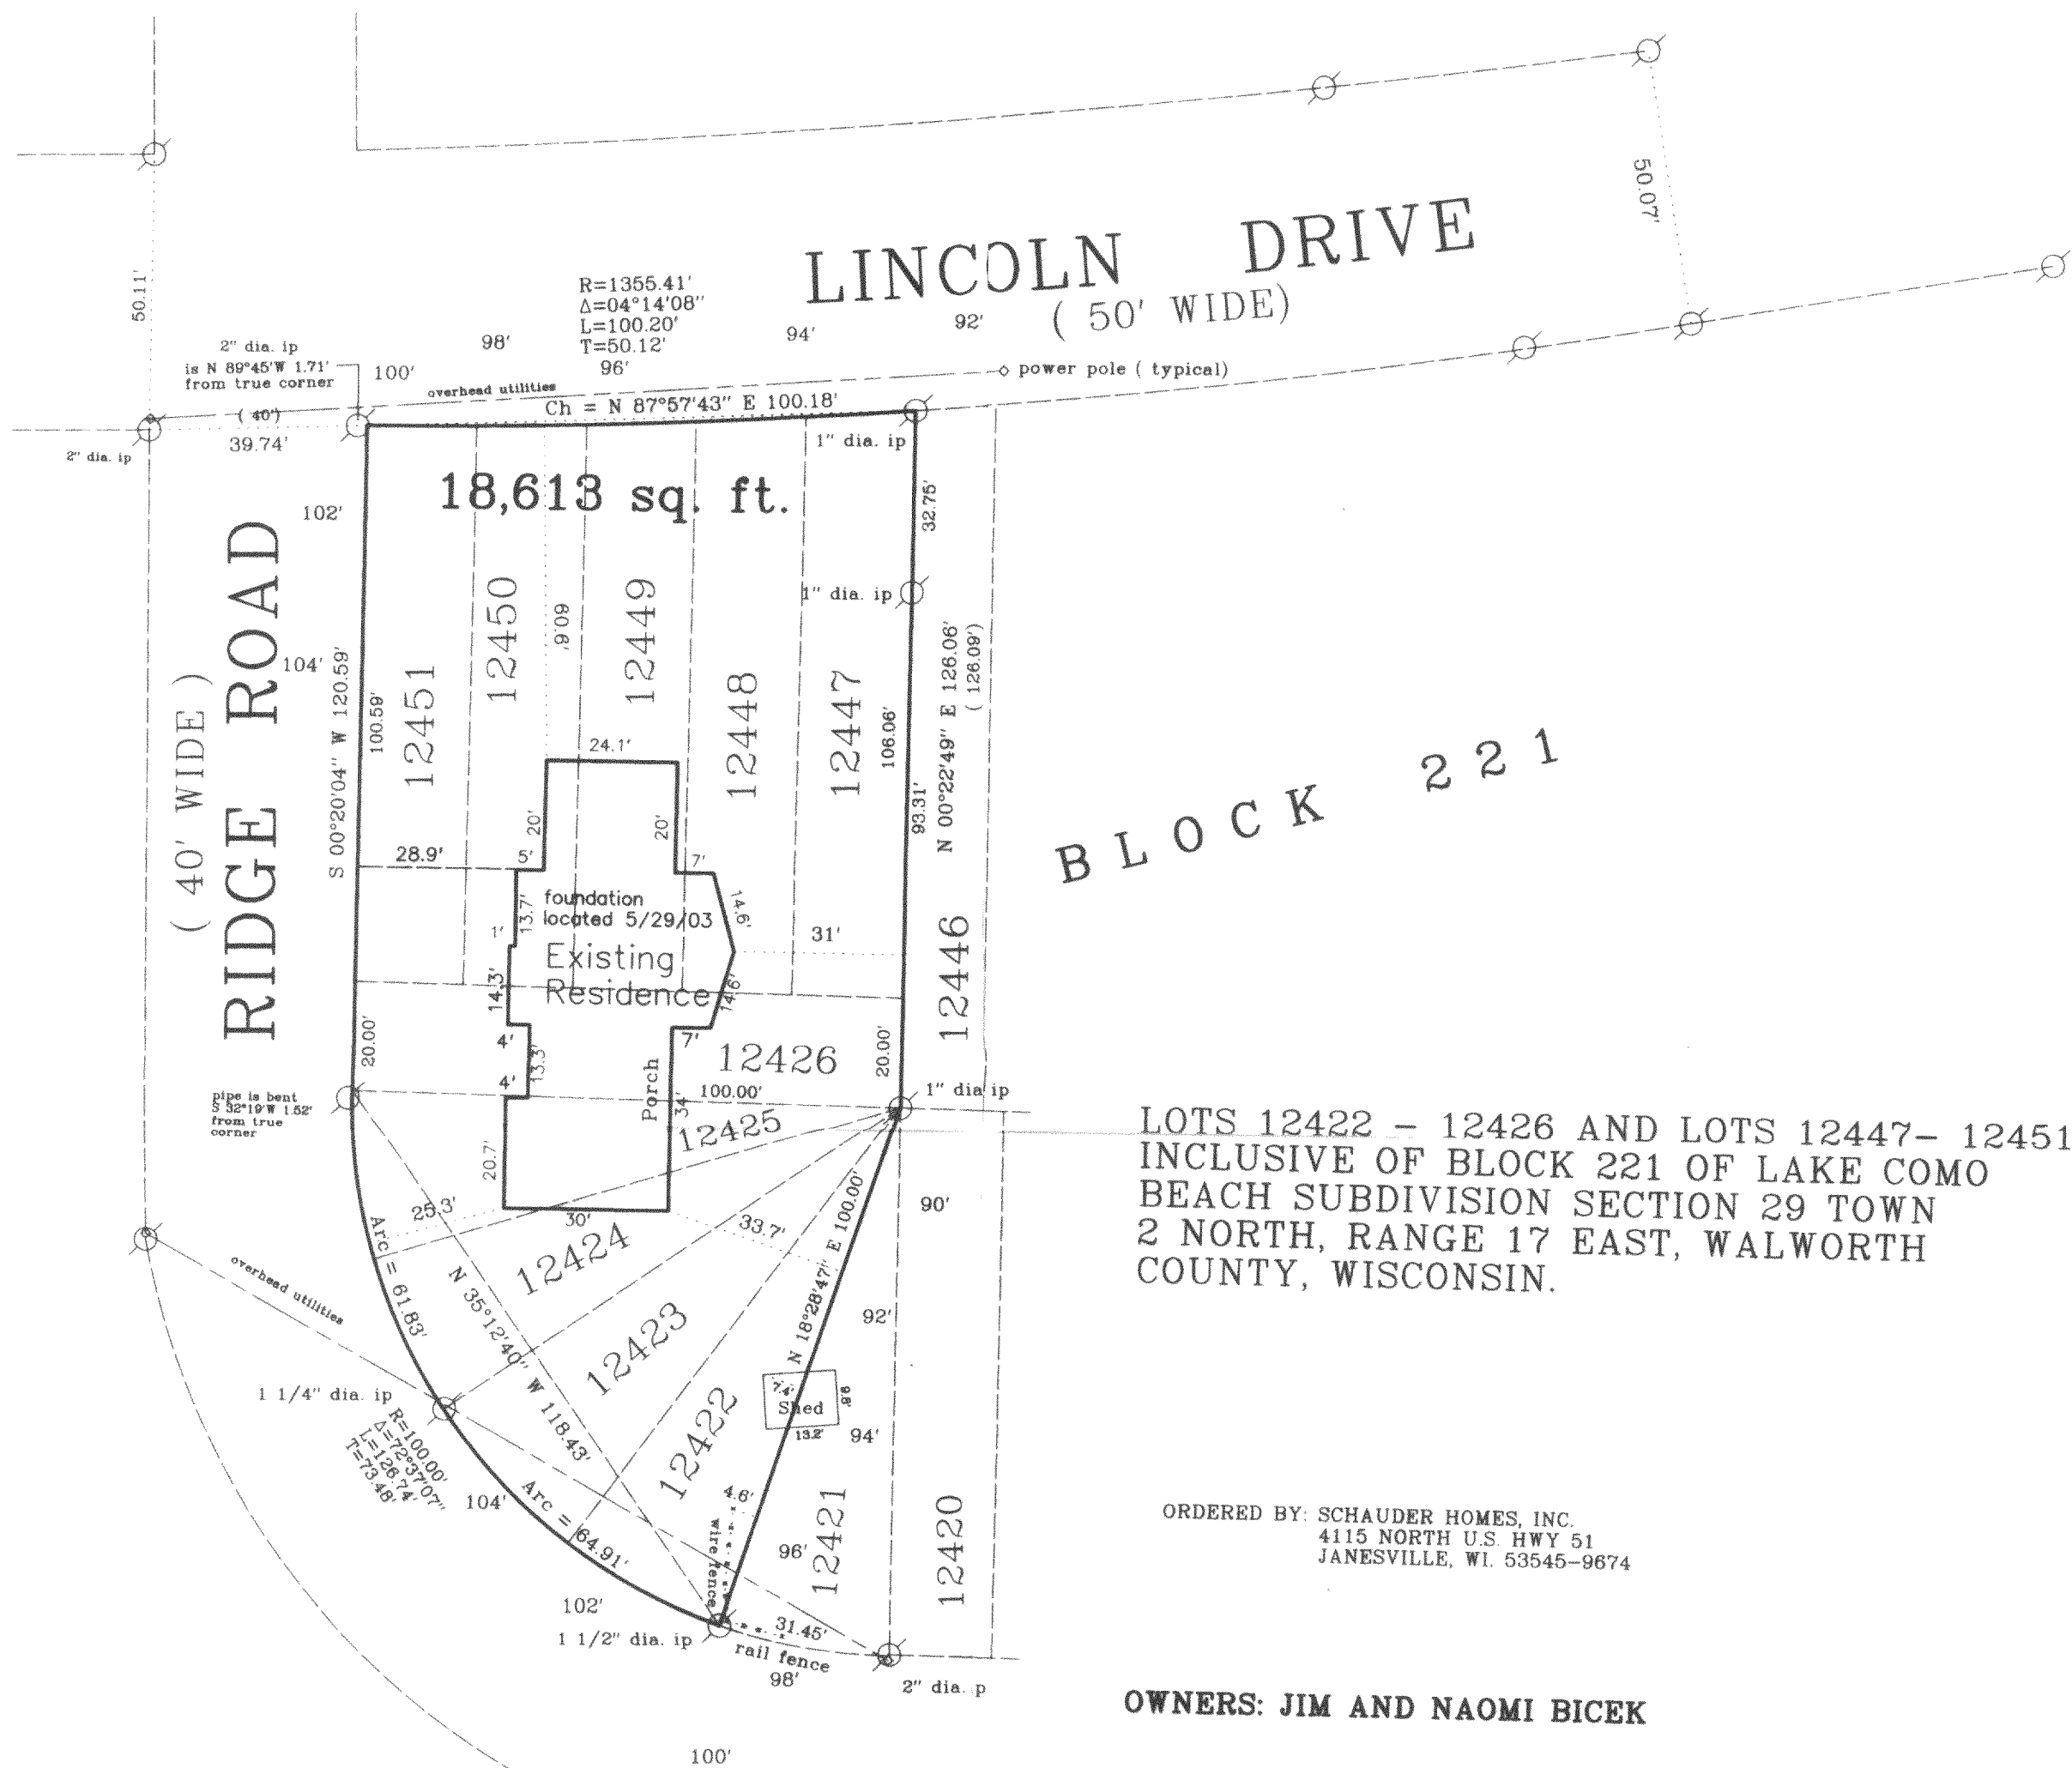

BLOCK 221



LOTS 12422 - 12426 AND LOTS 12447- 12451
INCLUSIVE OF BLOCK 221 OF LAKE COMO
BEACH SUBDIVISION SECTION 29 TOWN
2 NORTH, RANGE 17 EAST, WALWORTH
COUNTY, WISCONSIN.

ORDERED BY: SCHAUDER HOMES, INC.
4115 NORTH U.S. HWY 51
JANESVILLE, WI. 53545-9674

OWNERS: JIM AND NAOMI BICEK

LEGEND

- FOUND IRON PIPE
- FOUND IRON ROD
- ⊠ FOUND BRASS CAPPED MONUMENT
- ⊗ FOUND CONCRETE MONUMENT
- + CHISEL CUT IN CONCRETE
- SET IRON ROD, 24" LONG, WEIGHING 1.5 LBS./LINEAL FT., 3/4" DIA.
- SET IRON ROD, 30" LONG, WEIGHING 4.5 LBS./LINEAL FT., 1-11/16" DIA.
- (x x x) RECORDED AS DIMENSION
- EXISTING FENCE

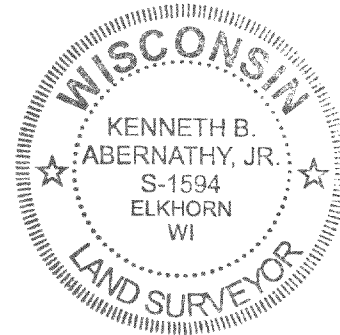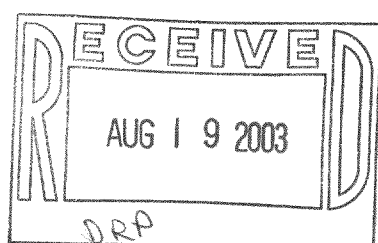

Revised 5/2/03

Revised 5/30/03 As Built Residence
located and Plat revised

SCALE: 1" = 30 FEET

"I hereby certify that the above described property has been surveyed by me or under my direction and that the above map is a true representation thereof and shows the size and location of the property, its exterior boundaries, the location of all visible structures and dimensions of all principal buildings thereon, boundary fences, apparent easements, roadways and visible encroachments, if any."

"This survey is made for the use of the present owners of the property, and also those who purchase, mortgage, or guarantee the title thereto within one year from the date hereof."

Kenneth B. Abernathy, Jr.
KENNETH B. ABERNATHY, JR. S-1594
WISCONSIN REGISTERED LAND SURVEYOR

DATED Feb. 5, 2003 Job No. 02.1004

JLCB-2703

217-2615