


GEORGE T. DUNHAM
SURVEYING & SUBDIVIDING
DELAVER, WISCONSIN



Scale - 1" = 20'
O = Iron Pipe

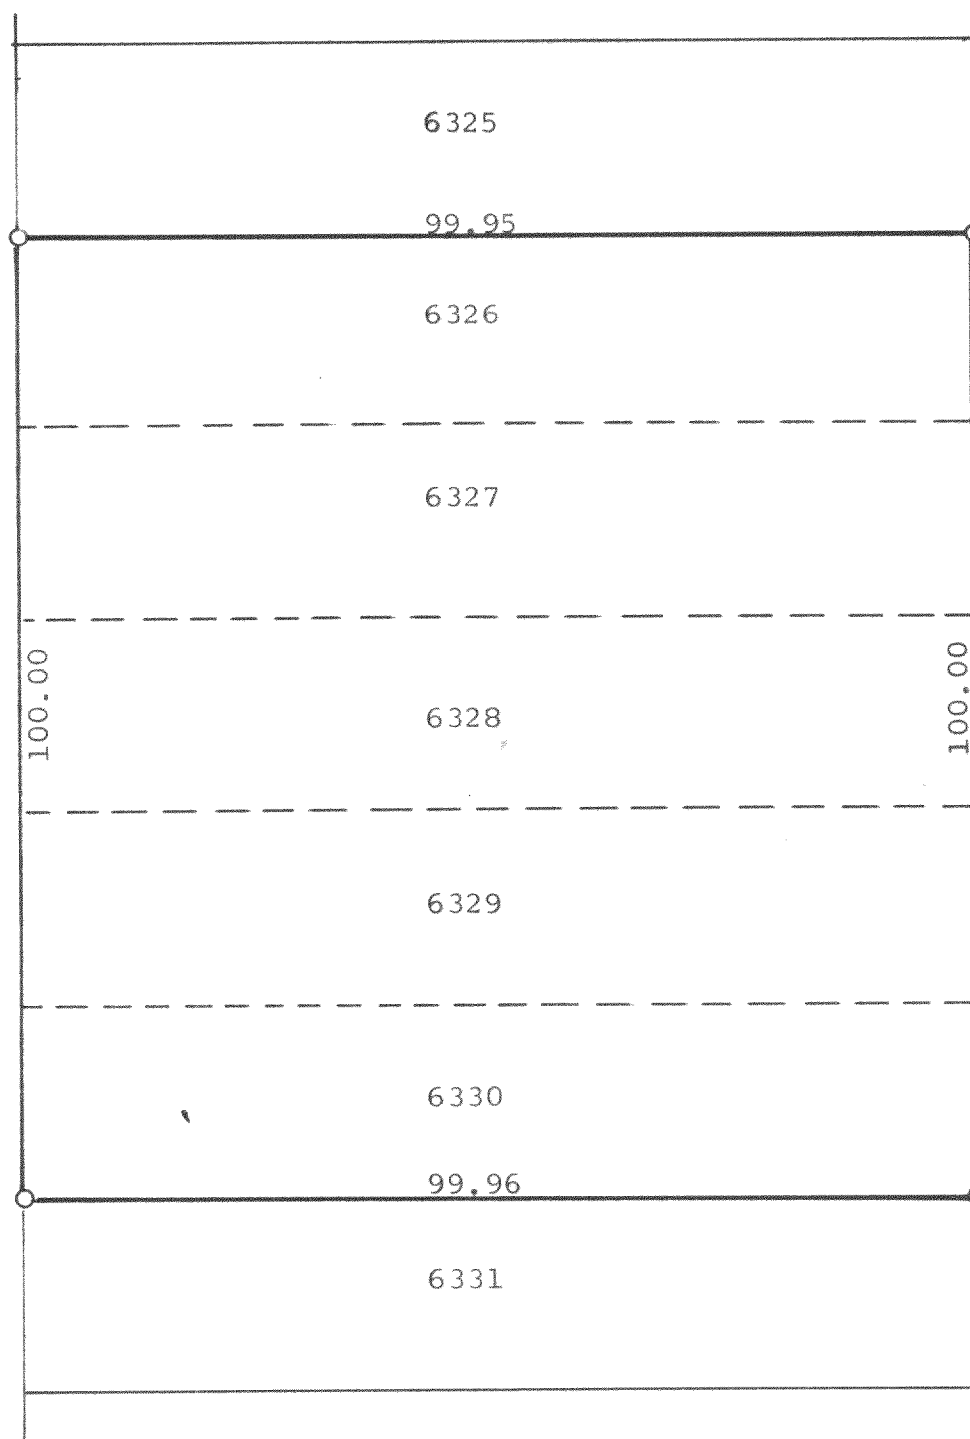

Plat of survey of Lots 6326-6330 Inclusive in Lake Como Beach
Subdivisions, Town of Geneva, Walworth County, Wisconsin.
October 5, 1970


George T. Dunham, Surveyor