


J.K. SURVEYING INC.
N3705 WILLOWBEND LANE
LAKE GENEVA, WI, 53147
262-248-3697

- OF -

LOTS 6-10, BLOCK 16B OF SUNSET HILLS, LOCATED
IN SECTION 33, TOWN2 NORTH RANGE 17 EAST,
WALWORTH COUNTY, WISCONSIN.

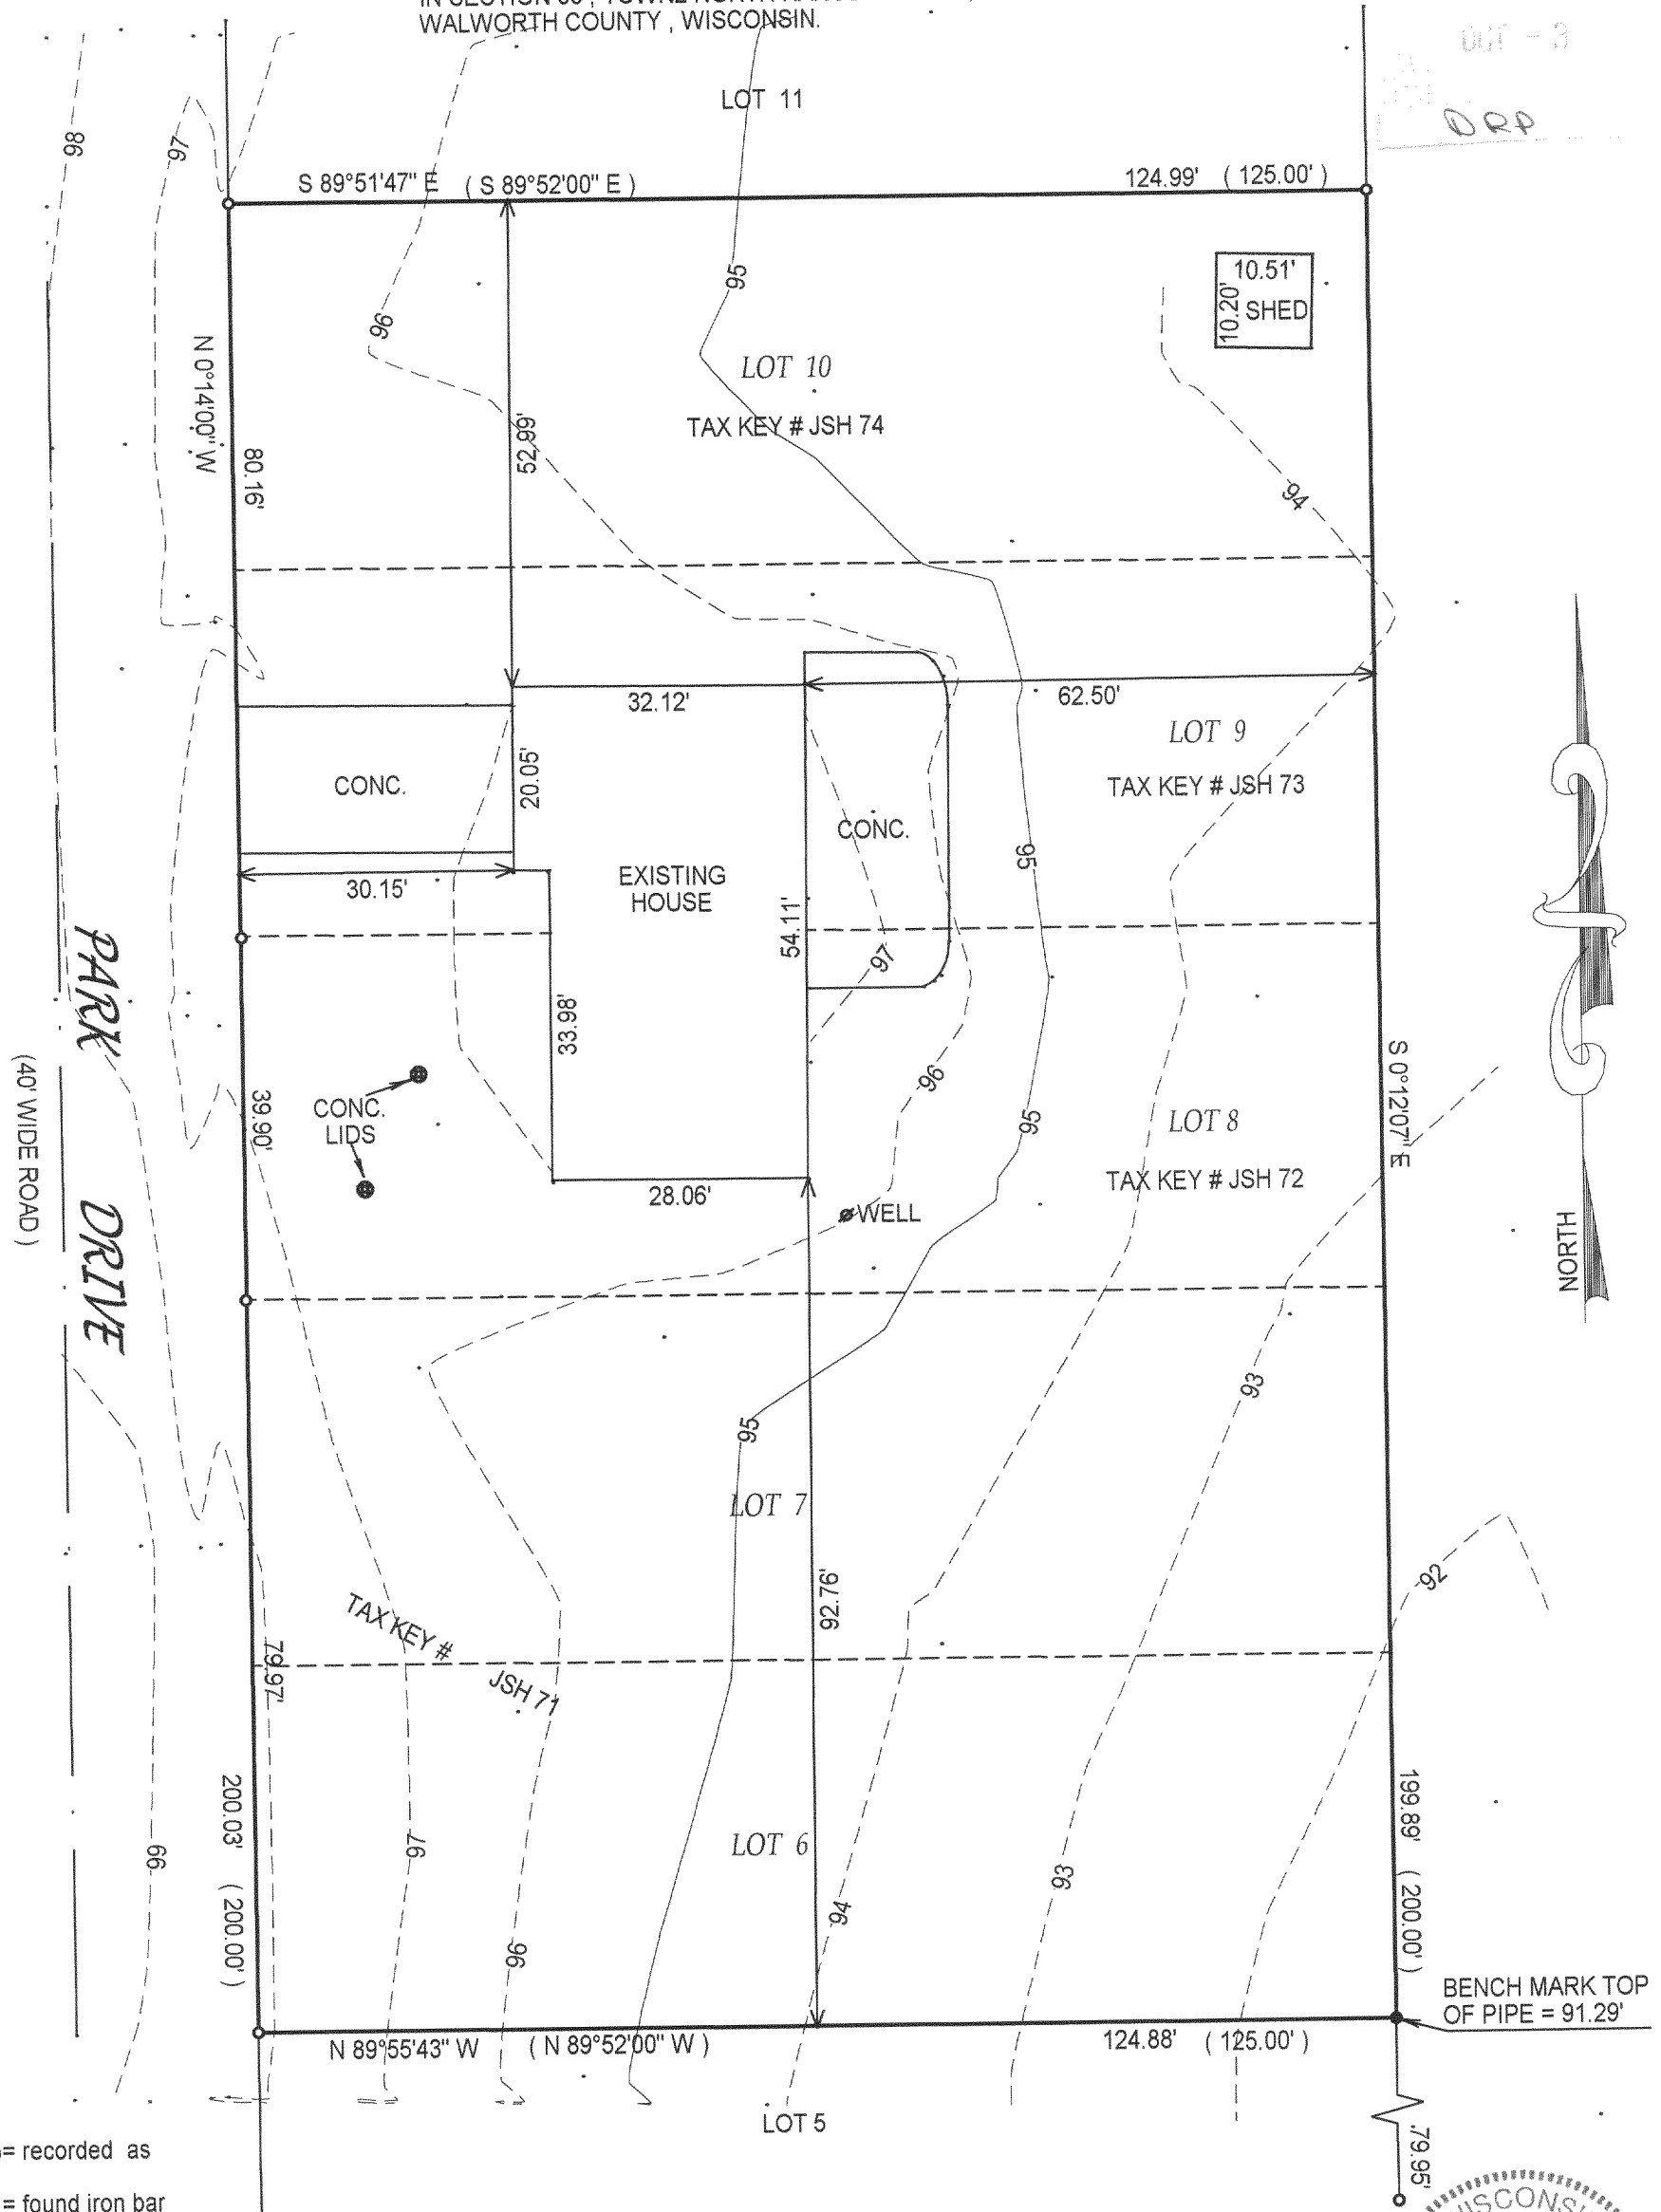

- () = recorded as
 □ = found iron bar
 ○ = found iron pipe
 ● = set iron pipe
 ■ = set iron bar

DATE OF LAST REVISION 06 / 20 / 03

COMPARE LEGAL DESCRIPTION ABOVE AND DRAWING WITH DEED. FOR BUILDING RESTRICTIONS AND EASEMENTS NOT SHOWN, REFER TO DEED, ABSTRACT SOURCES AND LOCAL MUNICIPAL CODES. NOTIFY THE SURVEYOR IMMEDIATELY OF ANY DISCREPANCY.

SCALE 1" = 20'


JOB # 02-102

TAX ID # JSH 71/72/73/74

"I hereby certify that I have surveyed the above described property and that the above map is a true representation thereof and shows the size and location of all visible structures, apparent easements and encroachments if any."

This survey is made for the present owners of the property, and those who purchase, mortgage, or guarantee the title thereto, within one year from the date hereof.

DATED THIS THE 27th DAY OF MARCH 2002.

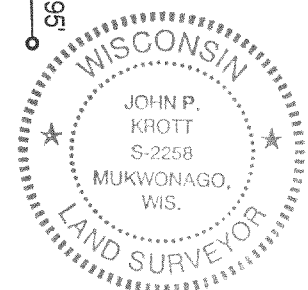

JOHN KROTT S - 2258
Wisconsin Registered Land Surveyor
(original if signed in red)

554-71, 72, 74

217-2694