

DEGEN-FOAT SURVEYING LLC


100 SOUTH SECOND STREET
WATERFORD, WISCONSIN
(262)534-5404 (FAX)534-2022

037198
038198S1.DWG



PLAT OF SURVEY

LOTS 5831 AND 5832, THE EAST 15.5 FEET OF LOT 5862 AND LOTS 5863 THRU 5866,
BLOCK 103 OF LAKE COMO BEACH SUBDIVISION, LOCATED IN SECTION 28, TOWN 2 NORTH,
RANGE 17 EAST, TOWN OF GENEVA, WALWORTH COUNTY, WISCONSIN.

* REFER TO CURRENT TITLE REPORT FOR EASEMENTS, RESTRICTIONS OR COVENANTS OF RECORD THAT MAY AFFECT THIS LAND *
* ESPECIALLY THOSE NOT SHOWN ON THE RECORDED PLAT OF LAKE COMO BEACH SUBDIVISION *

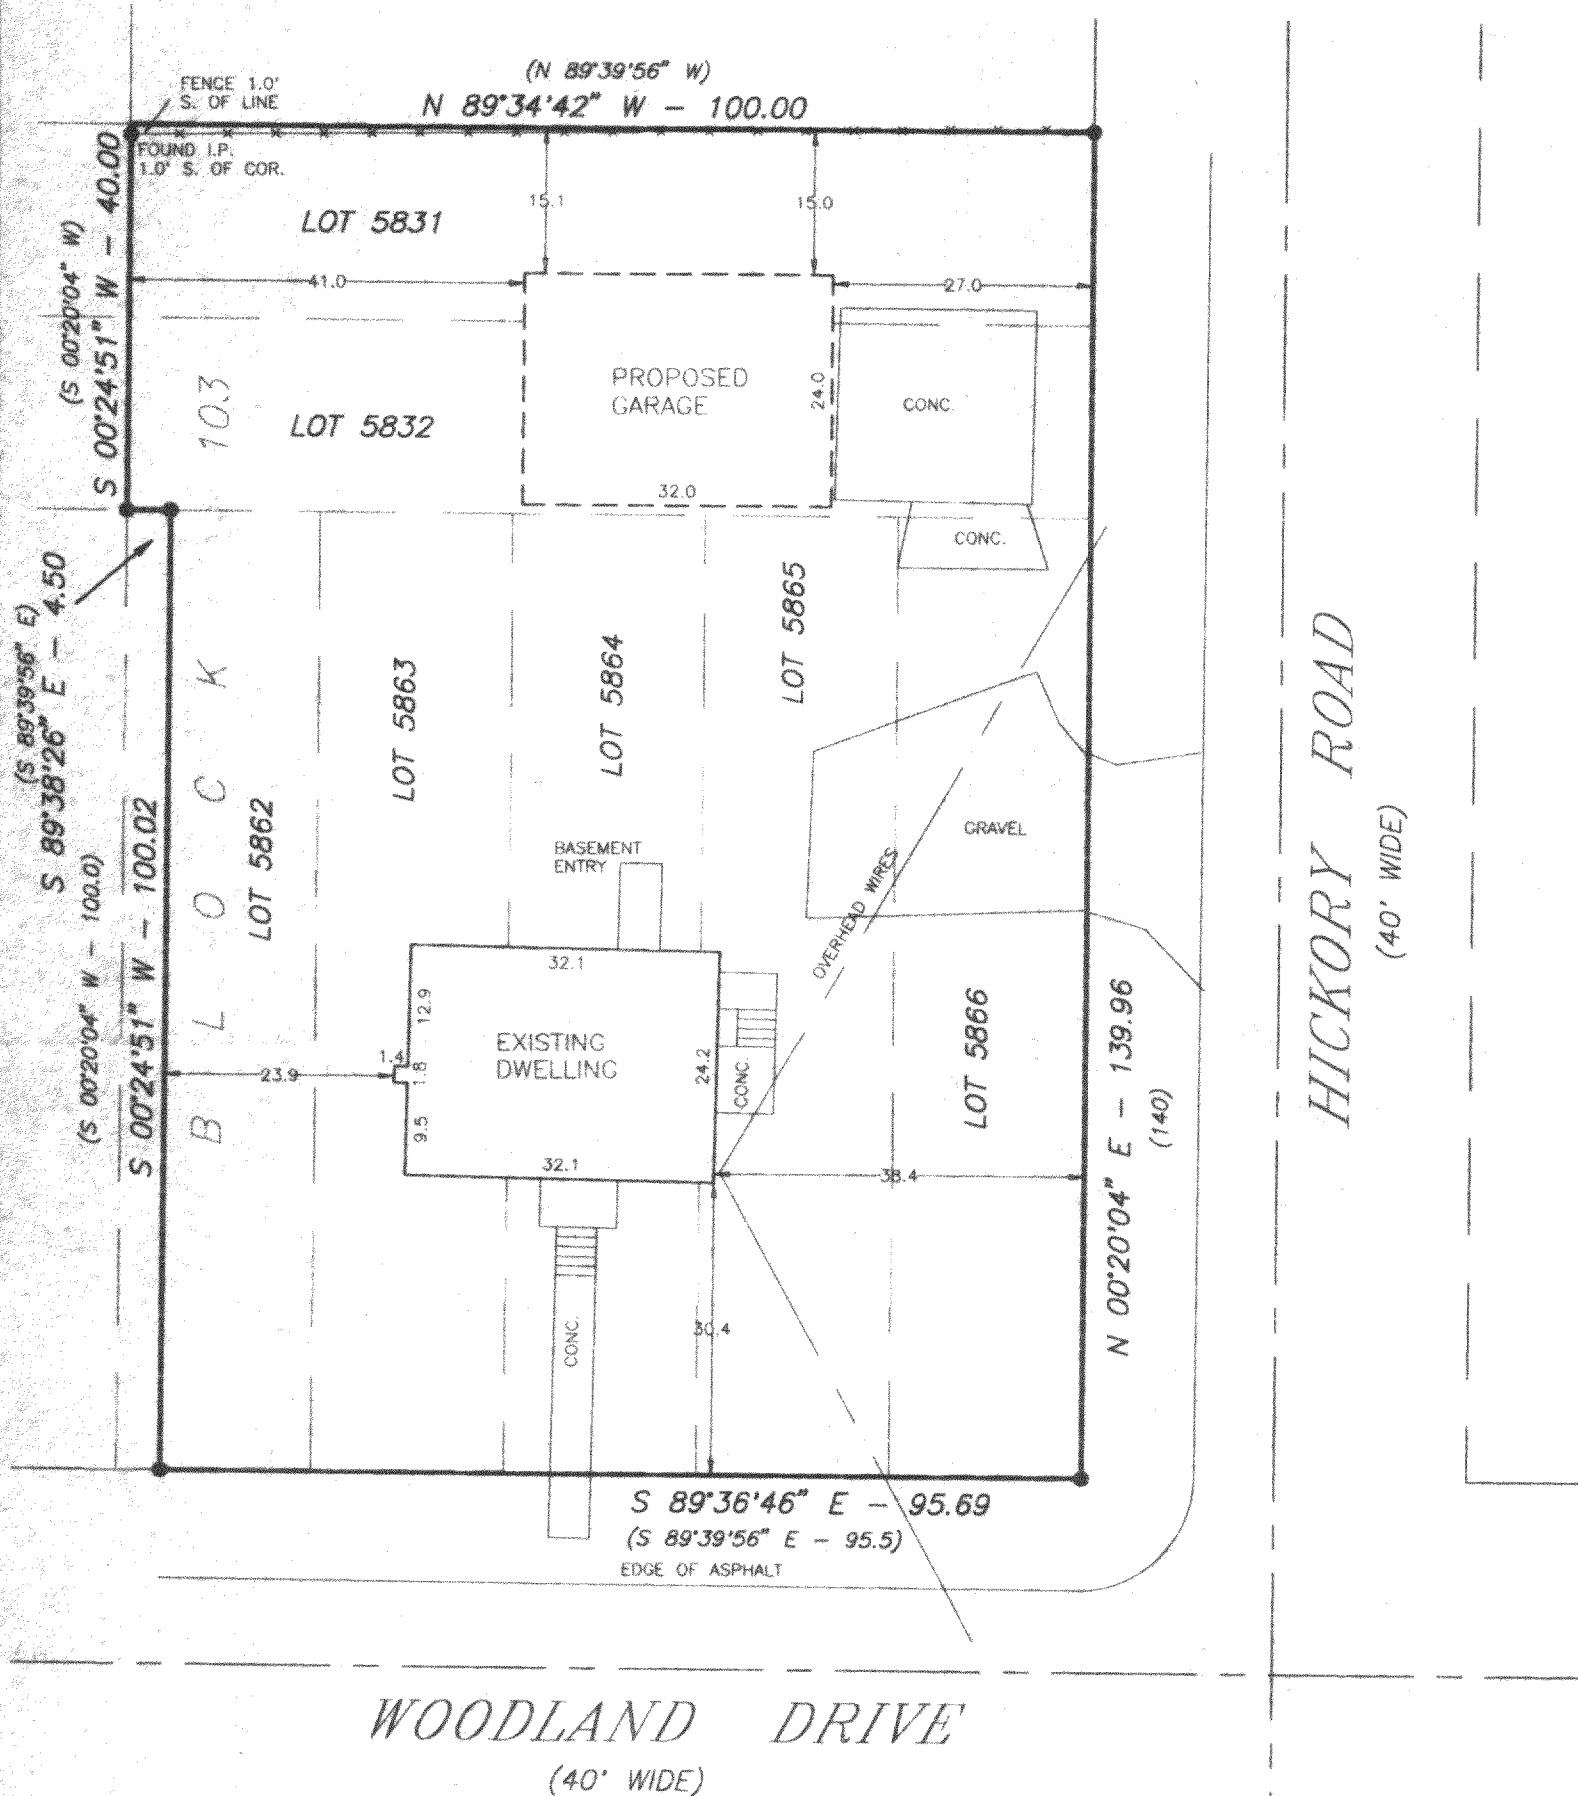

SURVEY PREPARED FOR: BILL COREY
P.O. BOX 628
SILVER LAKE, WISCONSIN 53170

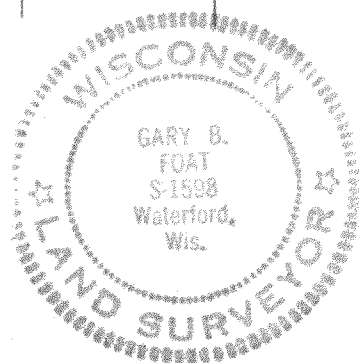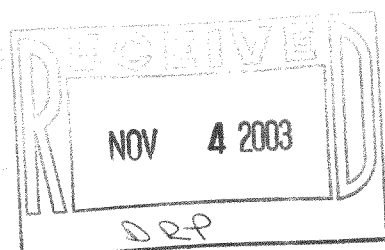

SCALE: 1" = 20'

LEGEND

- - FOUND IRON PIPE
- - SET IRON PIPE
- - WOOD FENCE
- () - RECORDED AS

I HEREBY CERTIFY THAT I HAVE SURVEYED THE ABOVE DESCRIBED PROPERTY AND THE ABOVE MAP IS A TRUE REPRESENTATION THEREOF AND SHOWS THE SIZE AND LOCATION OF THE PROPERTY, THE LOCATION OF ALL VISIBLE STRUCTURES AND DIMENSIONS OF ALL PRINCIPAL BUILDINGS THEREON, BOUNDARY FENCES, APPARENT EASEMENTS, ROADWAY AND VISIBLE ENCROACHMENTS, IF ANY.

THIS SURVEY IS MADE FOR THE PRESENT OWNERS OF THE PROPERTY, AND ALSO THOSE WHO PURCHASE, OR GUARANTEE THE TITLE THERETO WITHIN (1) YEAR FROM THE DATE HEREOF.

DATED AT: WATERFORD, WI THIS 18th DAY OF JULY 2003

RECEIVED

Gary B. Foat

JLCB-1199

217-2708