


HAROLD H. KOLB
REGISTERED PROFESSIONAL LAND SURVEYOR
LAKE GENEVA, WISCONSIN

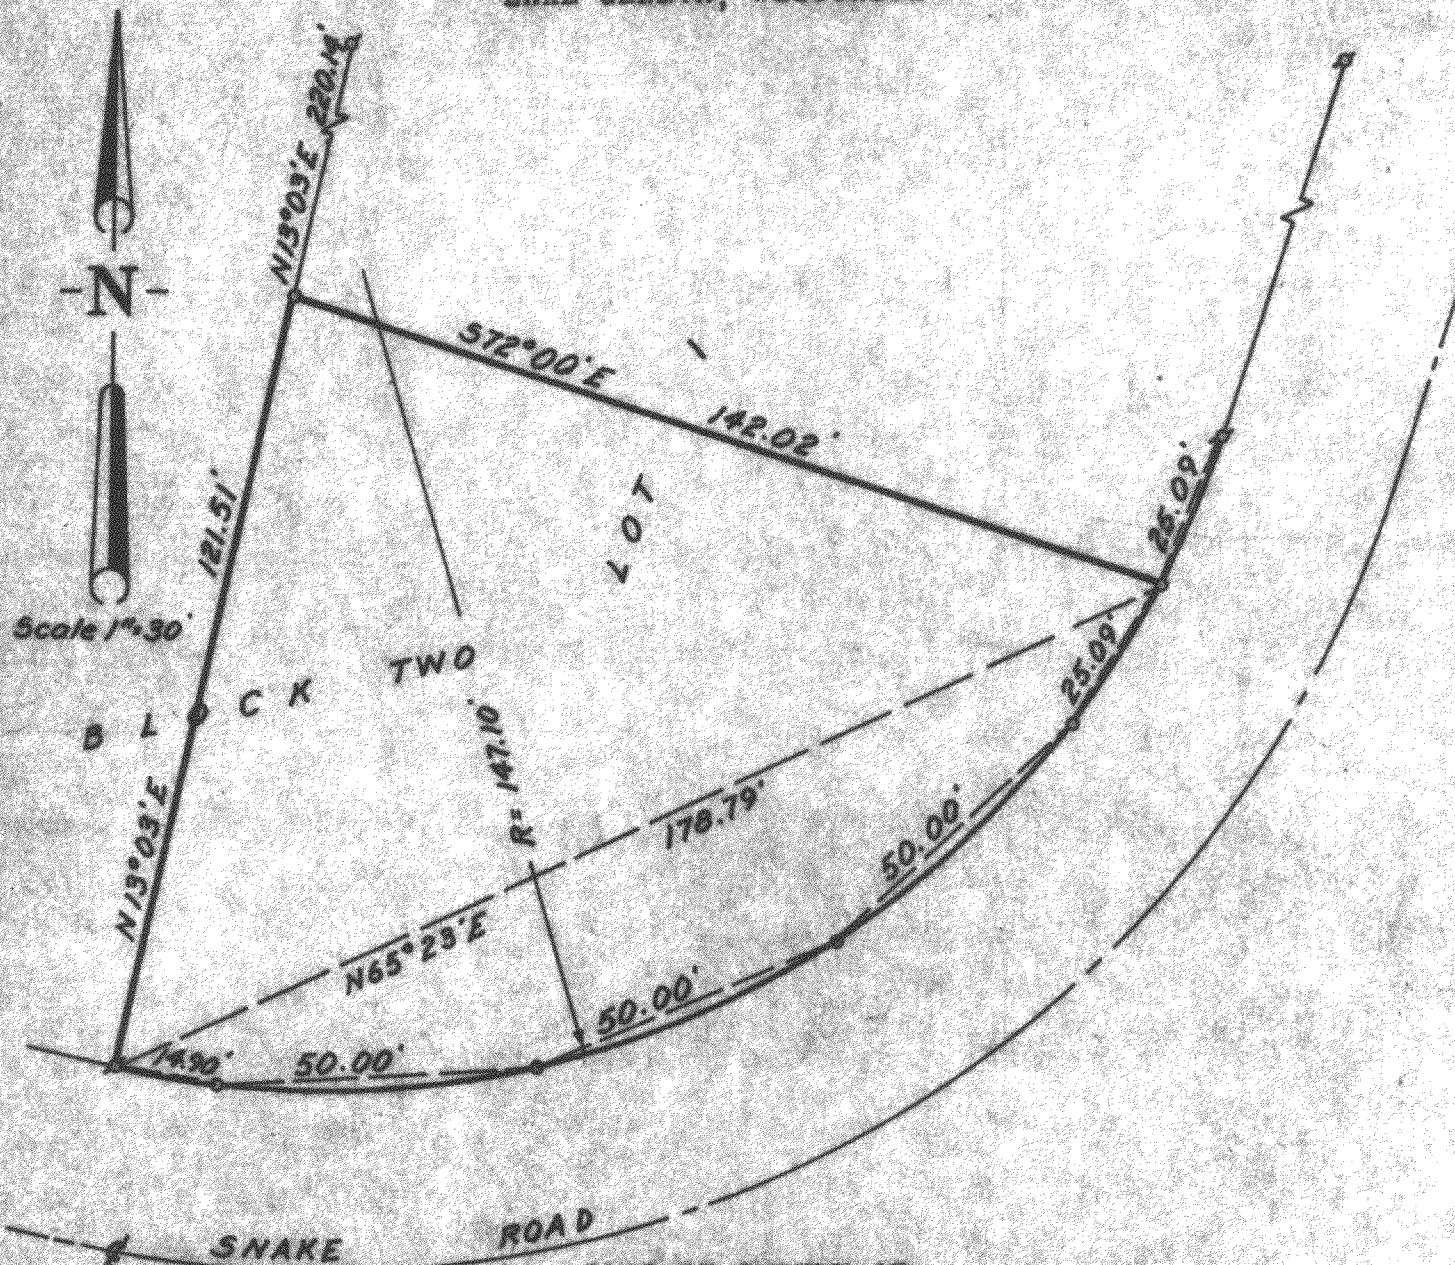

PLAT OF SURVEY OF

Part of Lot 1, Block 2, Geneva Bay Estates, located in the Southeast 1/4 of Section 35, T 2 N, R 17 E, Walworth County, Wisconsin and described as follows; to wit:

Commencing at the Northwest corner of said Lot 1; thence S 13° 03' W 220.14 feet to the place of beginning; thence continue S 13° 03' W 121.51 feet to the Northerly line of Snake Road; thence along the arc of a curve to the left, the radius of which is 147.10 feet and the chord is N 65° 23' E 178.79 feet; thence N 72° 00' W 142.02 feet to the place of beginning.

Containing 12,500 square feet, more or less.

Harold H. Kolb

Harold H. Kolb, Wisconsin Surveyor, S-187

DATE: June 12, 1964

• Iron Pipe Found
• Iron Pipe Placed

217-271