


Plat of Survey

of
Lots 3348 through 3364 and lots 3370 through 3383 of Block 59 of Lake Como Beach,
a subdivision located in the Southwest 1/4 of Section 22, Town 2 North, Range 17 East, Town of Geneva, Walworth County, Wisconsin.

Surveyed for: Thorpe, Compton & Christian , S.C.
1114 Ann Street • Suite 3
Delavan, Wisconsin. 53115

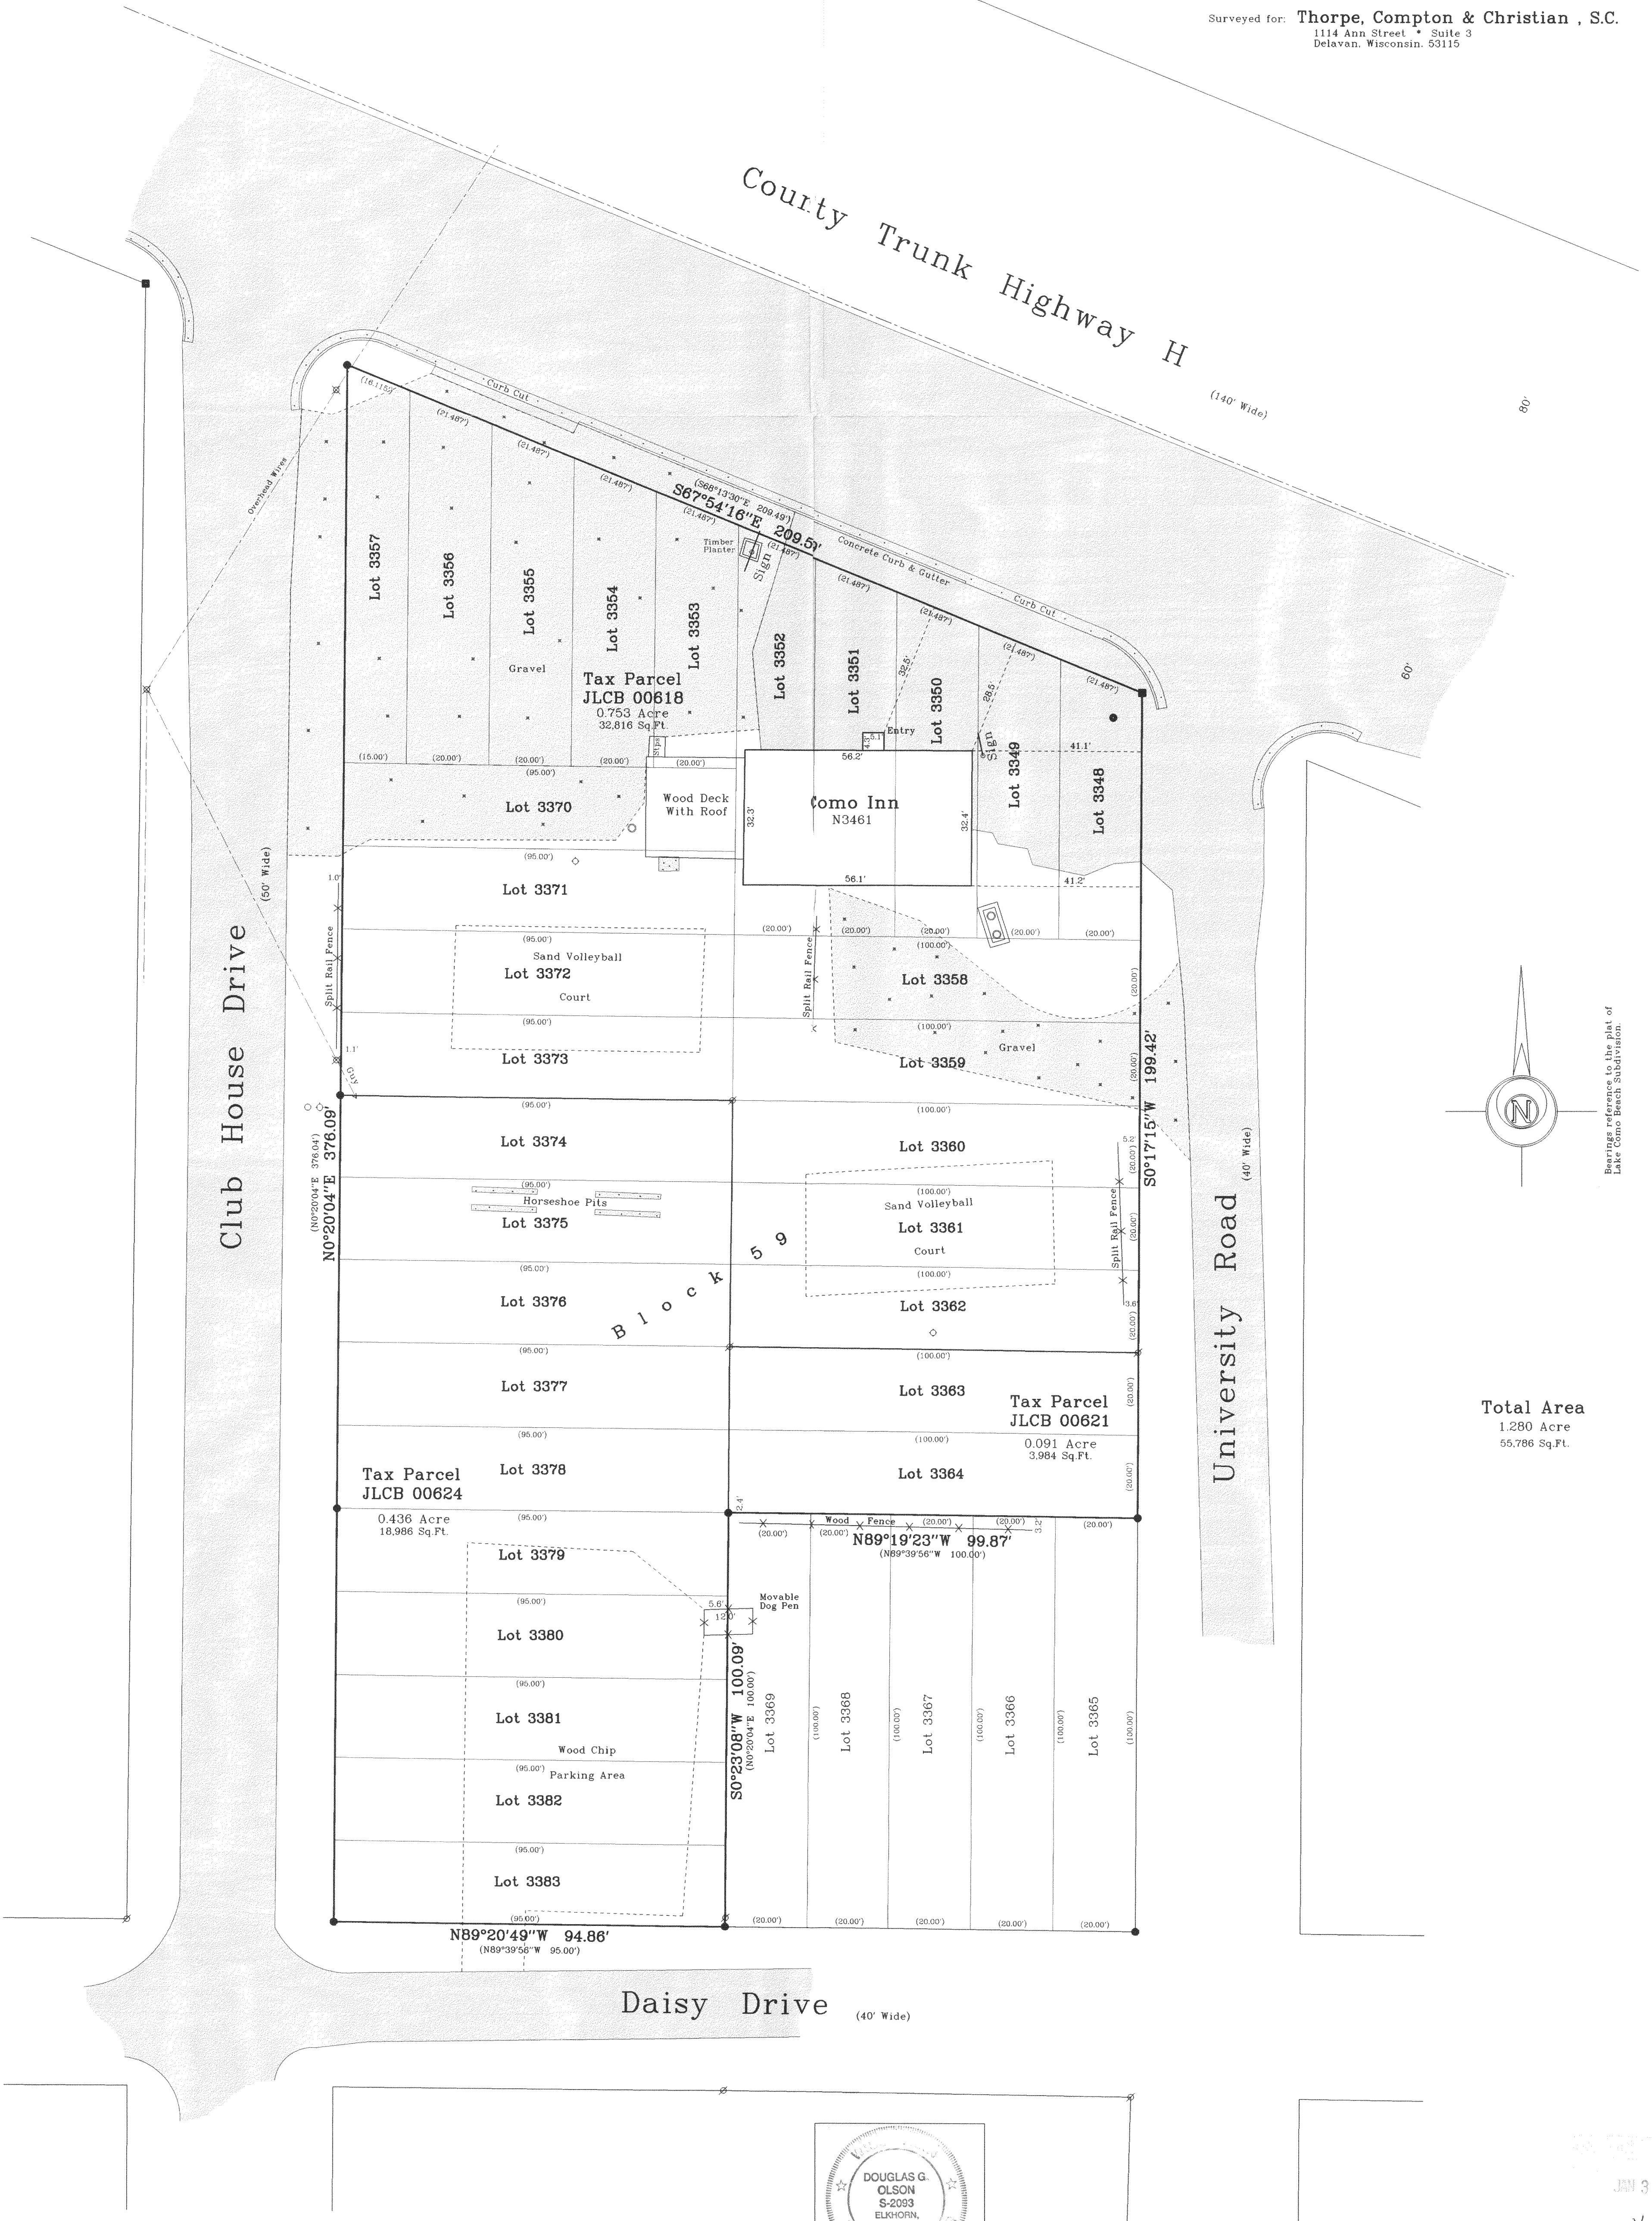

Total Area
1.280 Acre
55,786 Sq.Ft.

Copyright © 2003 by Jensen & Olson Land Surveying, LLC.
All rights reserved. No part of this survey plat may be reproduced or transmitted in any form by any means - graphic, electronic, or mechanical, including photocopying, tracing, or information storage and retrieval systems - without permission in writing from Douglas G. Olson, Jensen & Olson Land Surveying, LLC.

Notes: 1) This survey plat is not certified unless signed and sealed in red ink.
2) This survey is subject to Wisconsin lien laws. This Plat of Survey is the notice of intent to file lien. Lien waiver required.

I hereby certify that I have surveyed the above described property and the map hereon is correct to the best of my professional knowledge and belief and shows the size and location of the property, its exterior boundaries, the location and dimensions of all visible structures thereon, boundary fences, apparent easements and roadways and visible encroachments, if any.
This survey is made for the exclusive use of the present owners of property, and also those who purchase mortgage or guarantee title thereto, within one year from the date hereof.

Douglas G. Olson
Wisconsin Registered Land Surveyor - 2093

2003.161

Sheet 1 of 1 Sheets.

Job Reference Number

2003.161

Legend

- Found Iron Pipe
- Found Iron Rod
- Found Railroad Spike
- Recorded Information
- Utility Pole
- Concrete Cover
- Light Pole
- Hydrant & Water Valve
- Concrete Surface
- Asphalt Surface
- Gravel Surface



Jensen & Olson Land Surveying, LLC

45 South Wisconsin Street P.O. Box 322
Elkhorn, Wisconsin. 53121
Telephone: (262) 723-3434
Facsimile: (262) 723-8044

Scale in Feet

1" = 20'



Survey date: October 8, 2003.

Revisions:

JLCB-618
JLCB-621
JLCB-624

217-2733