



Plat of Survey

of
Lot 3 of Lake Forest Estates,
located in the Southwest 1/4 of Section 26, Town 2 North,
Range 17 East, Town of Geneva, Walworth County, Wisconsin.

Surveyed for: **Thelen Total Construction, Inc.**
N5896 Highways 12 & 67
Elkhorn, Wisconsin. 53121

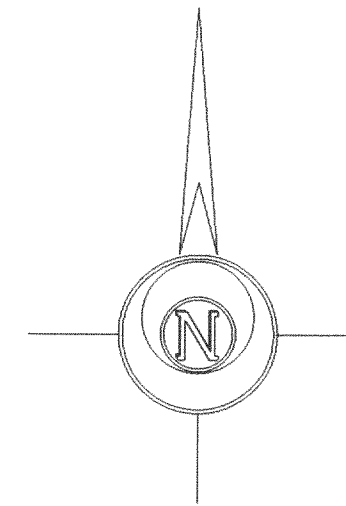

Bearings reference to the plat
of Lake Forest Estates.

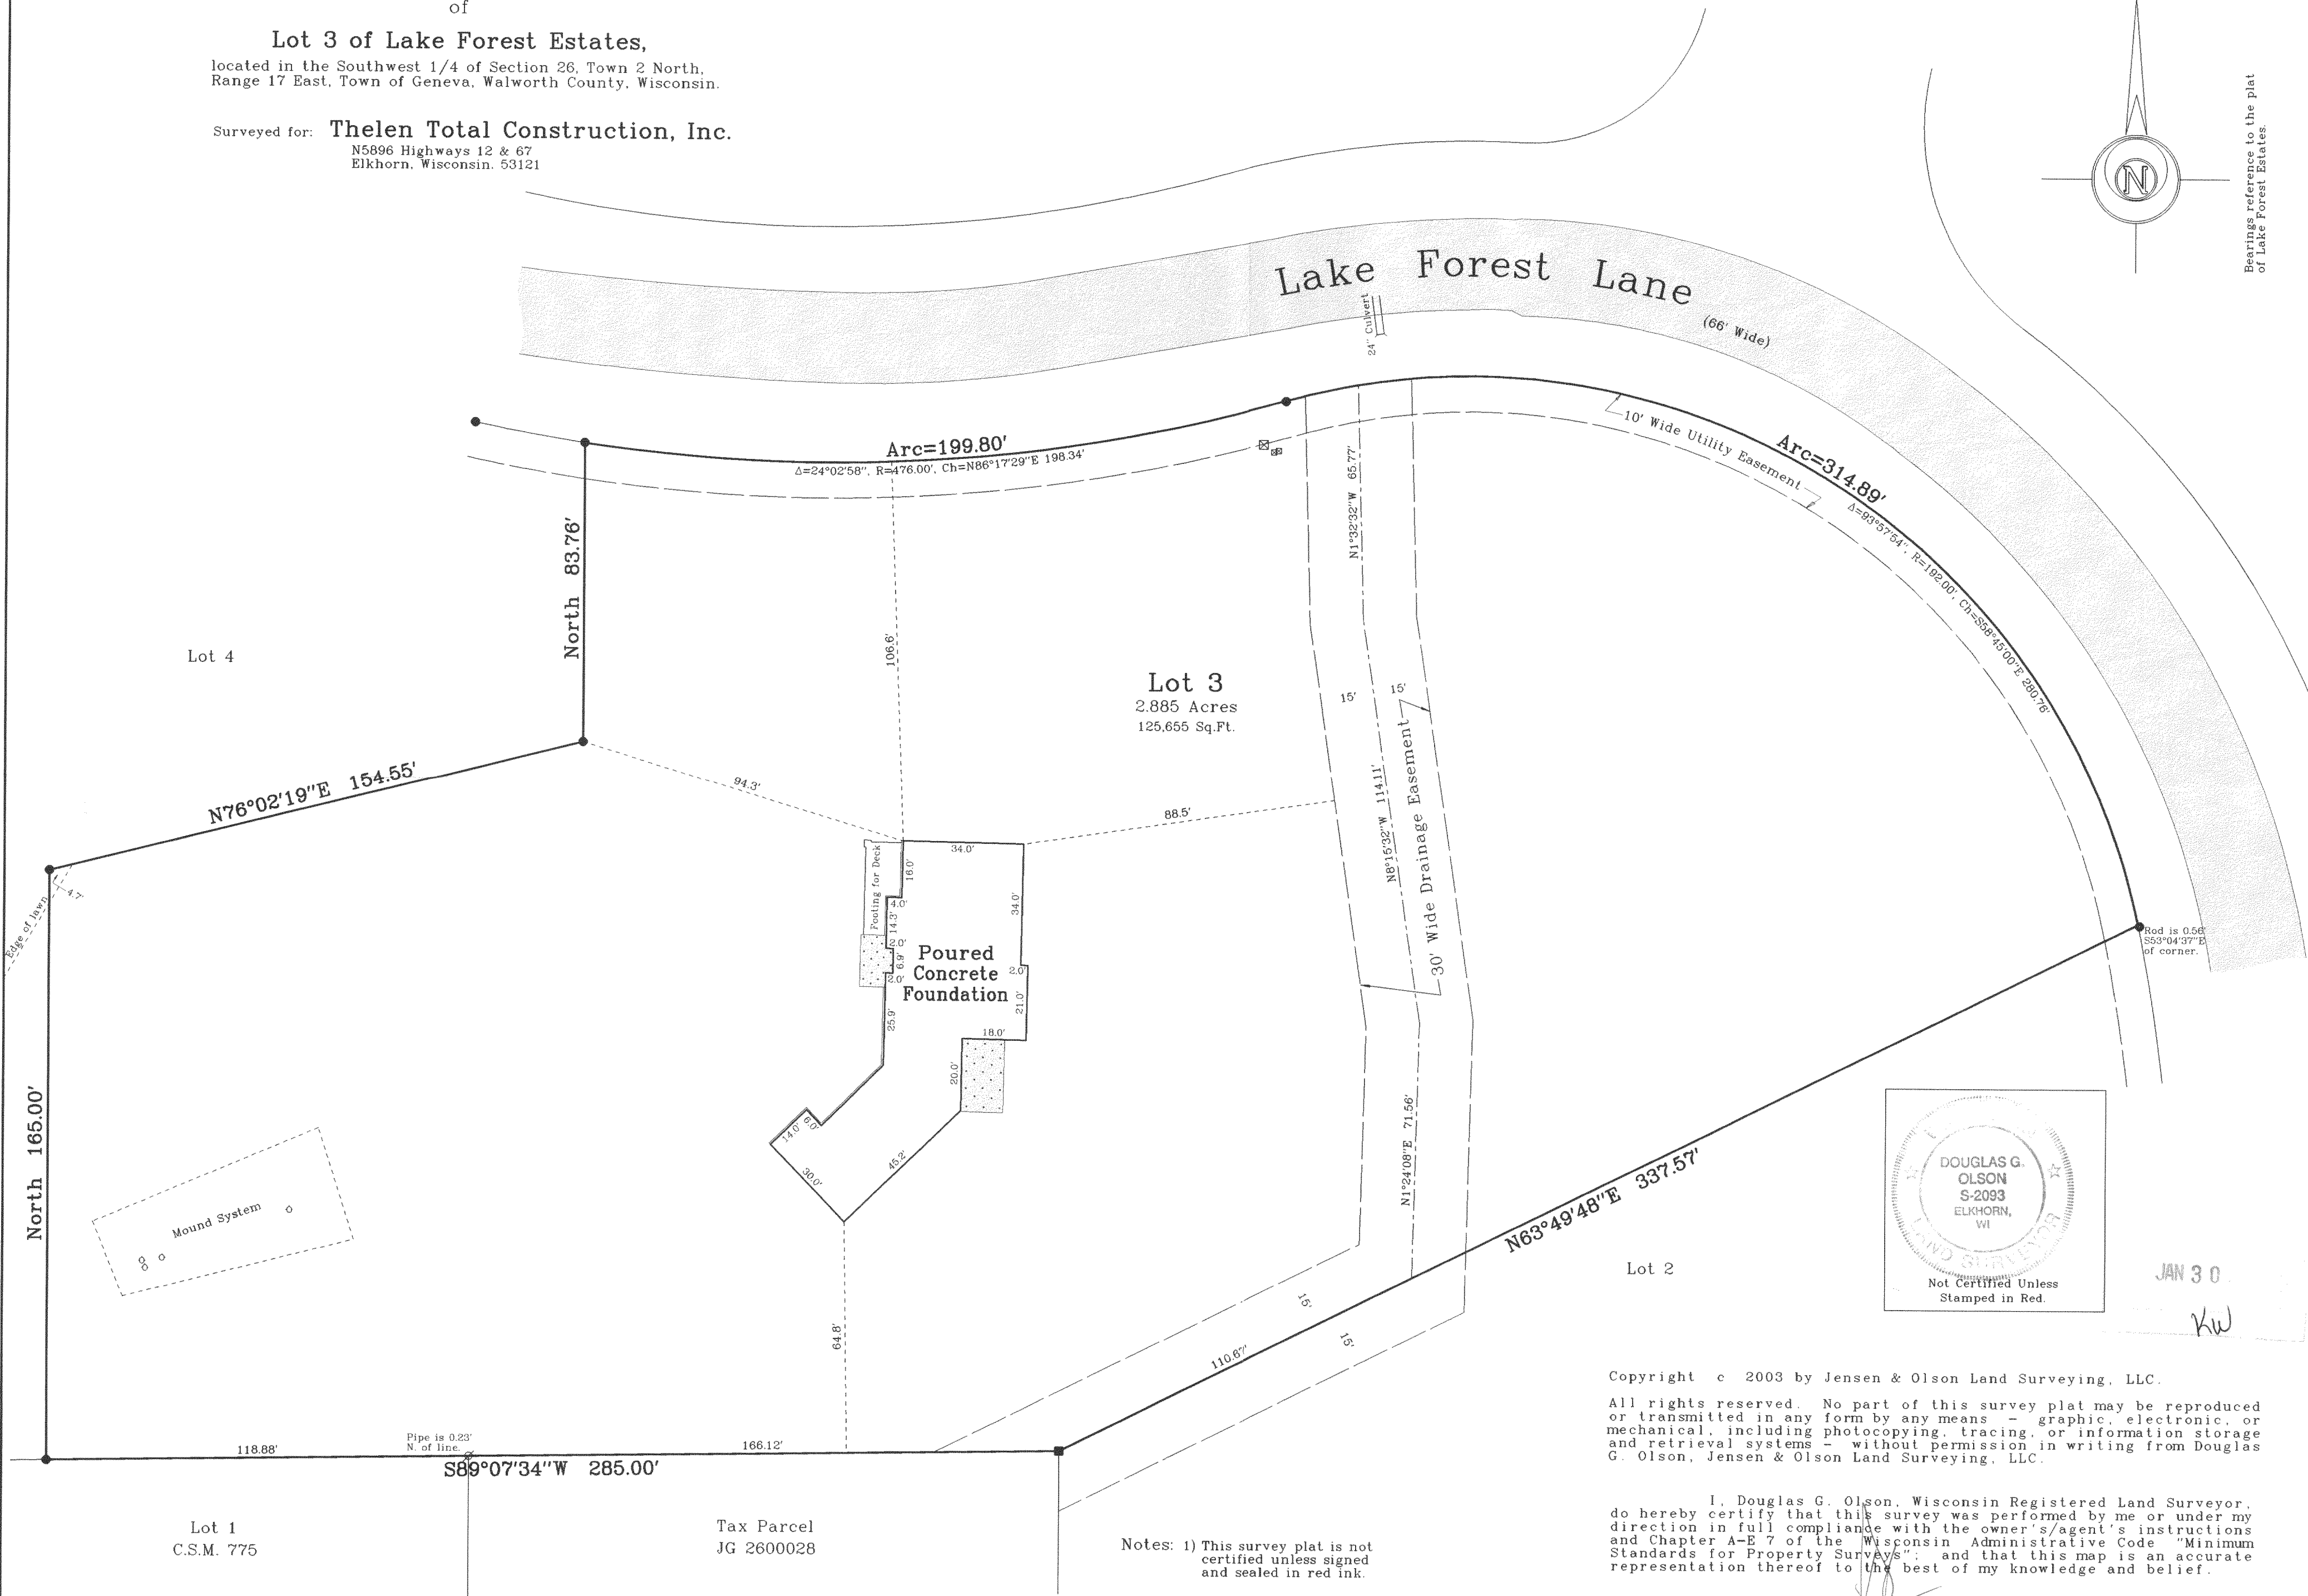

Survey Date: Sept. 29, 2003.
Revisions: No. 1 - Foundation

Scale in Feet
1" = 30'
0' 15' 30' 60'

Jensen & Olson Land Surveying, LLC
45 South Wisconsin Street
Elkhorn, Wisconsin 53121
Telephone (262) 723-3434
Facsimile (262) 723-8044

Legend
Found Concrete Monument
Found Iron Pipe
Found Iron Rod
Set Wood Stake
Recorded Information
Elevation for Federal
Spot Elevation
Asphalt Surface
Concrete

Sheet 1 of 1 Sheets
Job Reference Number
2003.162

2003.162

JLFE-3

217-2735