

Tax Parcel
JG 1500010

(259.00')
S89°33'28"E 259.10'

North line of the Northwest 1/4 of Section 22-2-17.

Lot 17

Willow Bend
Park

Bottom of Berm along Property Line

Lot 19
0.920 Acre
40,059 Sq.Ft.

Plat of Survey

of

Lot 19 of Willow Bend Park 1st Addition,
a subdivision located in the Northwest 1/4 of Section 22,
Town 2 North, Range 17 East, Town of Geneva, Walworth
County, Wisconsin.

Surveyed for: **Homestead Lakes Realty, Inc.**
520 Broad Street
Lake Geneva, Wisconsin. 53147

Lot 18

S10°00'50"W 226.00'
(S10°00'00"W)


N21°59'23"W 207.53'
(N21°59'07"W 207.61')

12' Wide Utility Easement
As shown on the plat of Willow
Bend Park 1st Addition


10' Wide Utility Easement
As shown on the plat of Willow
Bend Park 1st Addition

Radius=216.00', Chord=N77°17'50"W 145.65'
Arc=148.56'

Willow Bend Court
(66' Wide)

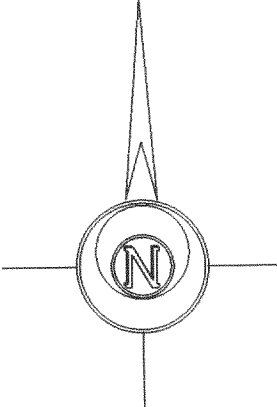

Bearings reference to the plat of
Willow Bend Park 1st Addition.

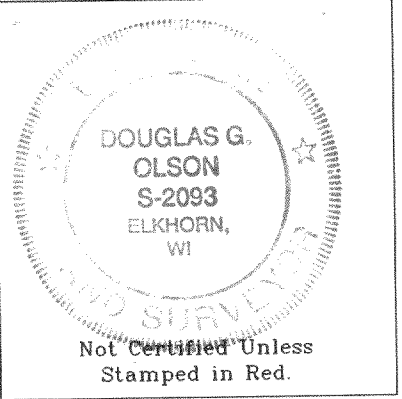

- Notes: 1) This survey plat is not certified unless signed and sealed in red ink.
- 2) This survey is subject to Wisconsin lien laws. This Plat of Survey is the notice of intent to file lien. Lien waiver required.

Copyright © 2003 by Jensen & Olson Land Surveying, LLC.

All rights reserved. No part of this survey plat may be reproduced or transmitted in any form by any means - graphic, electronic, or mechanical, including photocopying, tracing, or information storage and retrieval systems without permission in writing from Douglas G. Olson, Jensen & Olson Land Surveying, LLC.


I hereby certify that I have surveyed the above described property and the map hereon is correct to the best of my professional knowledge and belief and shows the size and location of the property, its exterior boundaries, the location and dimensions of all visible structures thereon, boundary fences, apparent easements and roadways and visible encroachments, if any.

This survey is made for the exclusive use of the present owners of property, and also those who purchase, mortgage or guarantee title thereto, within one year from the date hereof.

Douglas G. Olson
Wisconsin Registered Land Surveyor - 2093

Survey Date: November 11, 2003

Revisions:

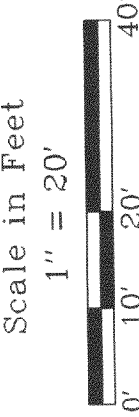

Jensen & Olson Land Surveying, LLC

45 South Wisconsin Street P.O. Box 322
Elkhorn, Wisconsin. 53121
Telephone (262) 723-3434
Facsimile (262) 723-8044

Legend

- Found Iron Pipe
- Found Iron Rod
- Set Iron Rod, 3/4" dia.
- Recorded Information
- Utility Pedestal
- Asphalt Surface

Sheet 1 of 1 Sheets

Job Reference Number
2003.186

2003.186